


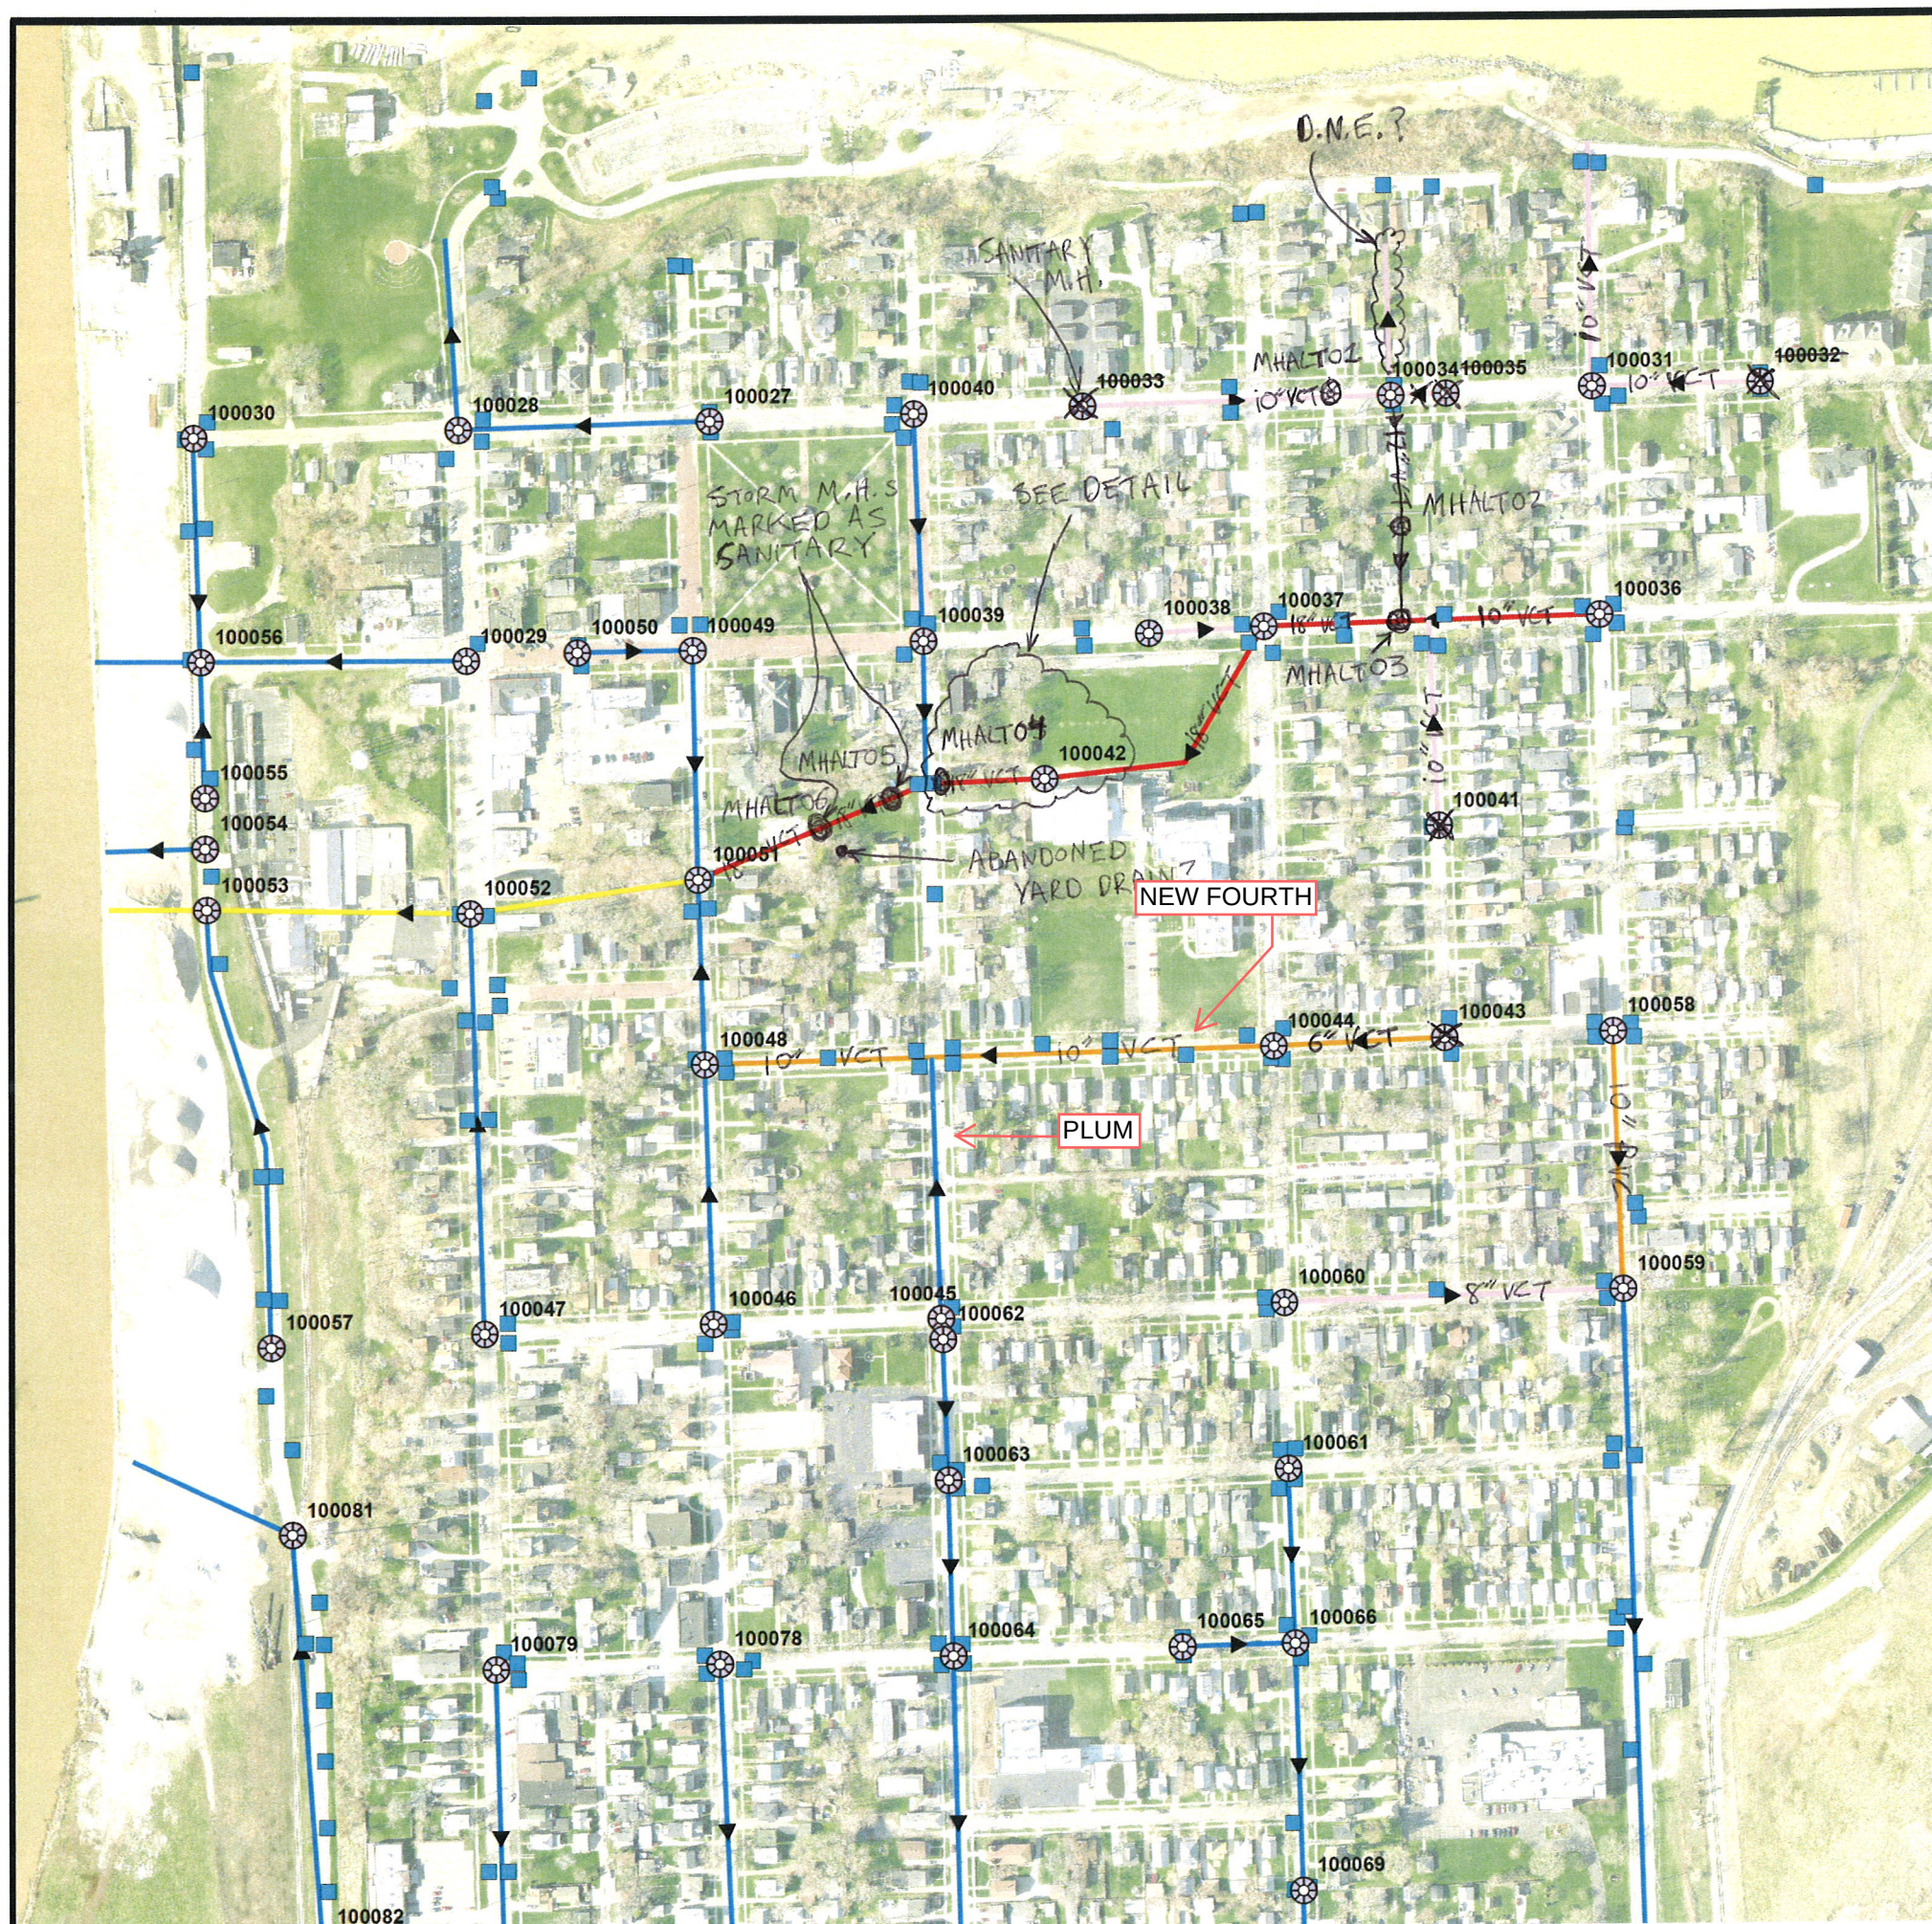


FAIRPORT HARBOR STORM SEWER
RECONNAISSANCE

- OBSERVED MANHOLE LOCATIONS:

<u>M.H.#</u>	<u>M.H. LOCATION</u>
100031	N.E. CORNER OF EAST ST. & 2 ND ST.
100034	S. SIDE OF 2 ND ST. BETWEEN VINE & EAST ST.
MHALT01	IN DRIVEWAY ON N. SIDE OF 2 ND ST. (507 2 ND ST.)
MHALT02	IN BACK YARD OF 513 3 RD ST. (NOT LOCATED)
MHALT03	IN DRIVEWAY AT 516 3 RD ST.
100036	S.E. CORNER OF EAST ST. & 3 RD ST.
100037	S.W. CORNER OF VINE ST. & 3 RD ST.
1000 100042	IN FIELD NEAR WEST ACCESS DRIVE. (SEE DETAIL)
MHALT04	N OF FENCE AT NE CORNER OF PLUM ST & ACCESS D
MHALT05	EMPTY LOT N OF 329 PLUM ST. (W SIDE)
MHALT06	EMPTY LOT N OF 332 EAGLE ST. (E OF PARKING LOT
100051	EMPTY LOT S OF 323 EAGLE ST. (W SIDE)
100044	IN TREE LAWN NEAR NW CORNER OF VINE & NEW 4 TH ST.
100048	NW CORNER OF NEW 4 TH & EAGLE ST.
100058	MIDDLE OF S.B. LANE AT NEW 4 TH & EAST ST
100059	MIDDLE OF S.B. LANE AT 5 TH & EAST ST.
100041	M.H. IN EITHER W OR E C.B. NEAR 324 A ^{CHESTNUT}
100060	M.H. IN NE C.B. AT VINE & 5 TH ST.

- MHALT04 + 100042 DETAIL:

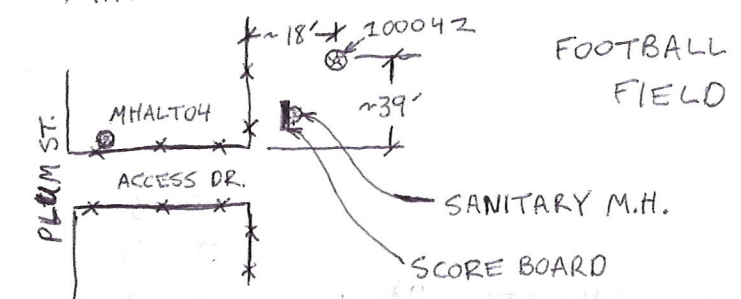[illegible]