


PROFILE	BY	DATE
SURVEYED.....		
PLOTTED.....		
GRADES CHECKED.....		
B.M.'S NOTED.....		
STRUCTURE NOTATION'S CHK'D.....		
N.O.....		

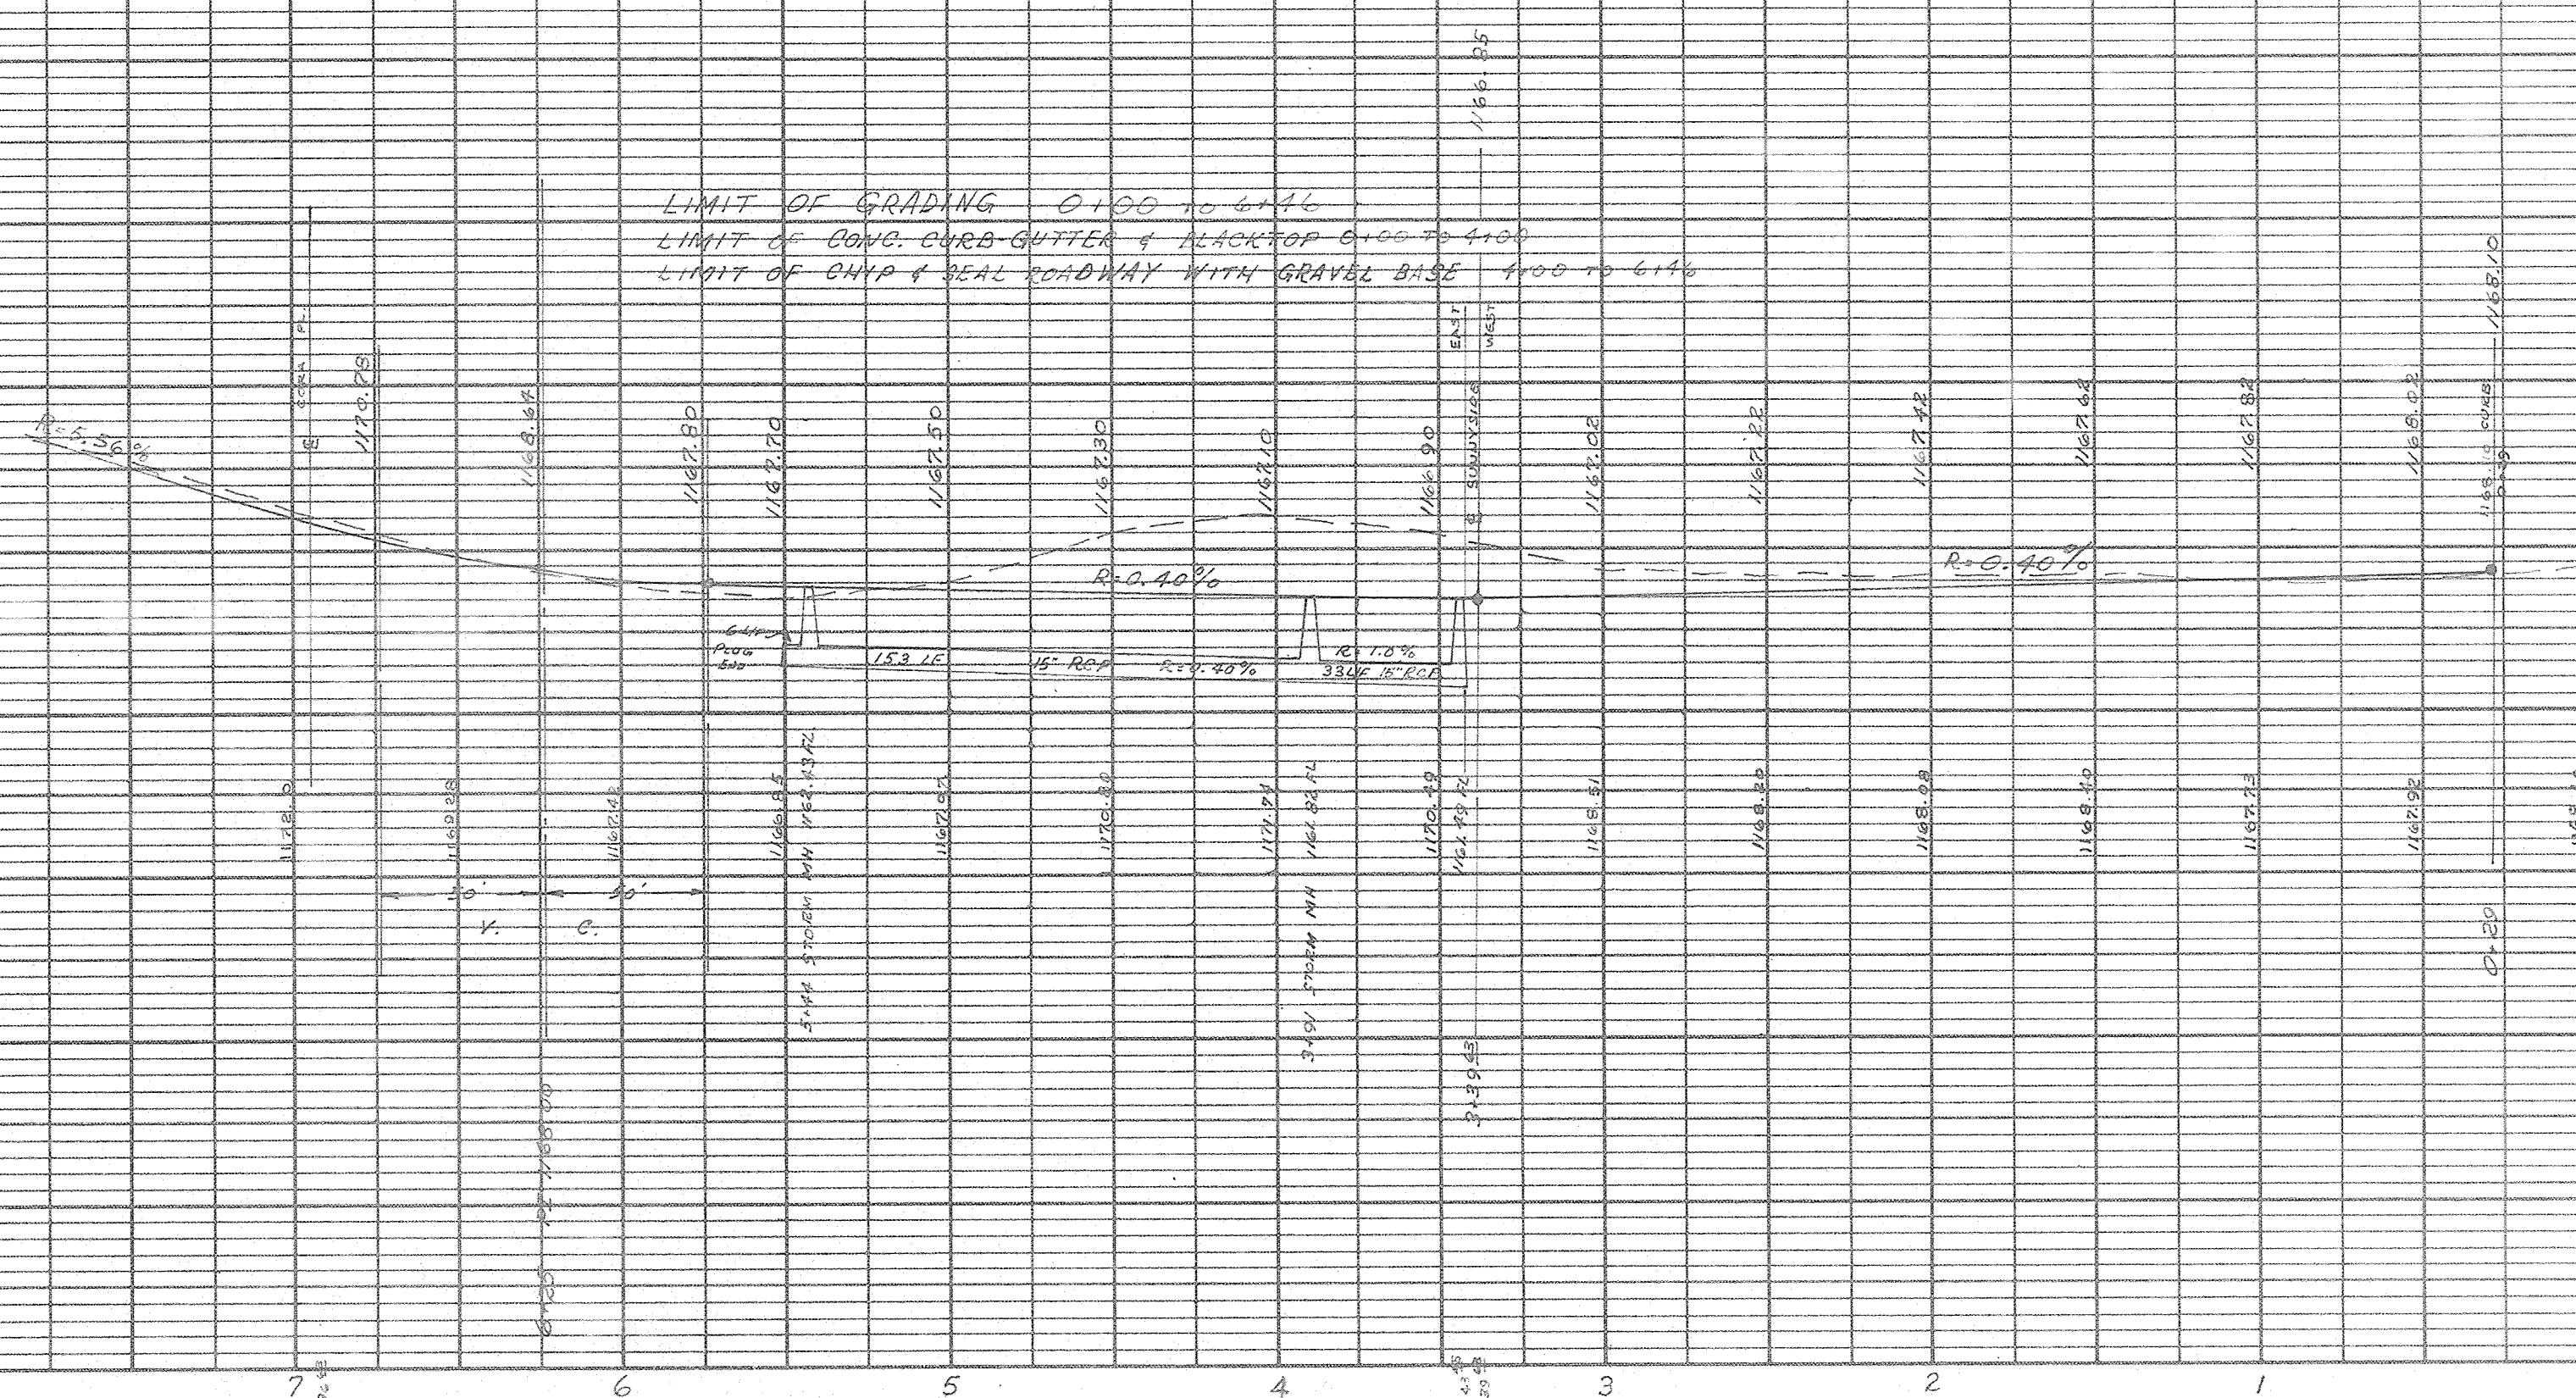


SIGNED _____ DATE _____

PLAN & PROFILE
STEFFY AVENUE SW.
VILLAGE OF HARTVILLE, OHIO
L.W.J. COOPER & ASSOCIATES
ENGINEERS & SURVEYORS
J.L. COOPER W.D. JUNKERMAN JR. R.M. MILLER W.J. MOOLA
SCALE HOR. 1"=50'
VER. 1"=10' JUNE, 1971

PLAN	DATE
SUBMITTED	BY
PLOTTED	
NOTE BOOK	
NO.	


PROFILE	DATE
SUBMITTED	BY
PLOTTED	
NOTE BOOK	
NO.	

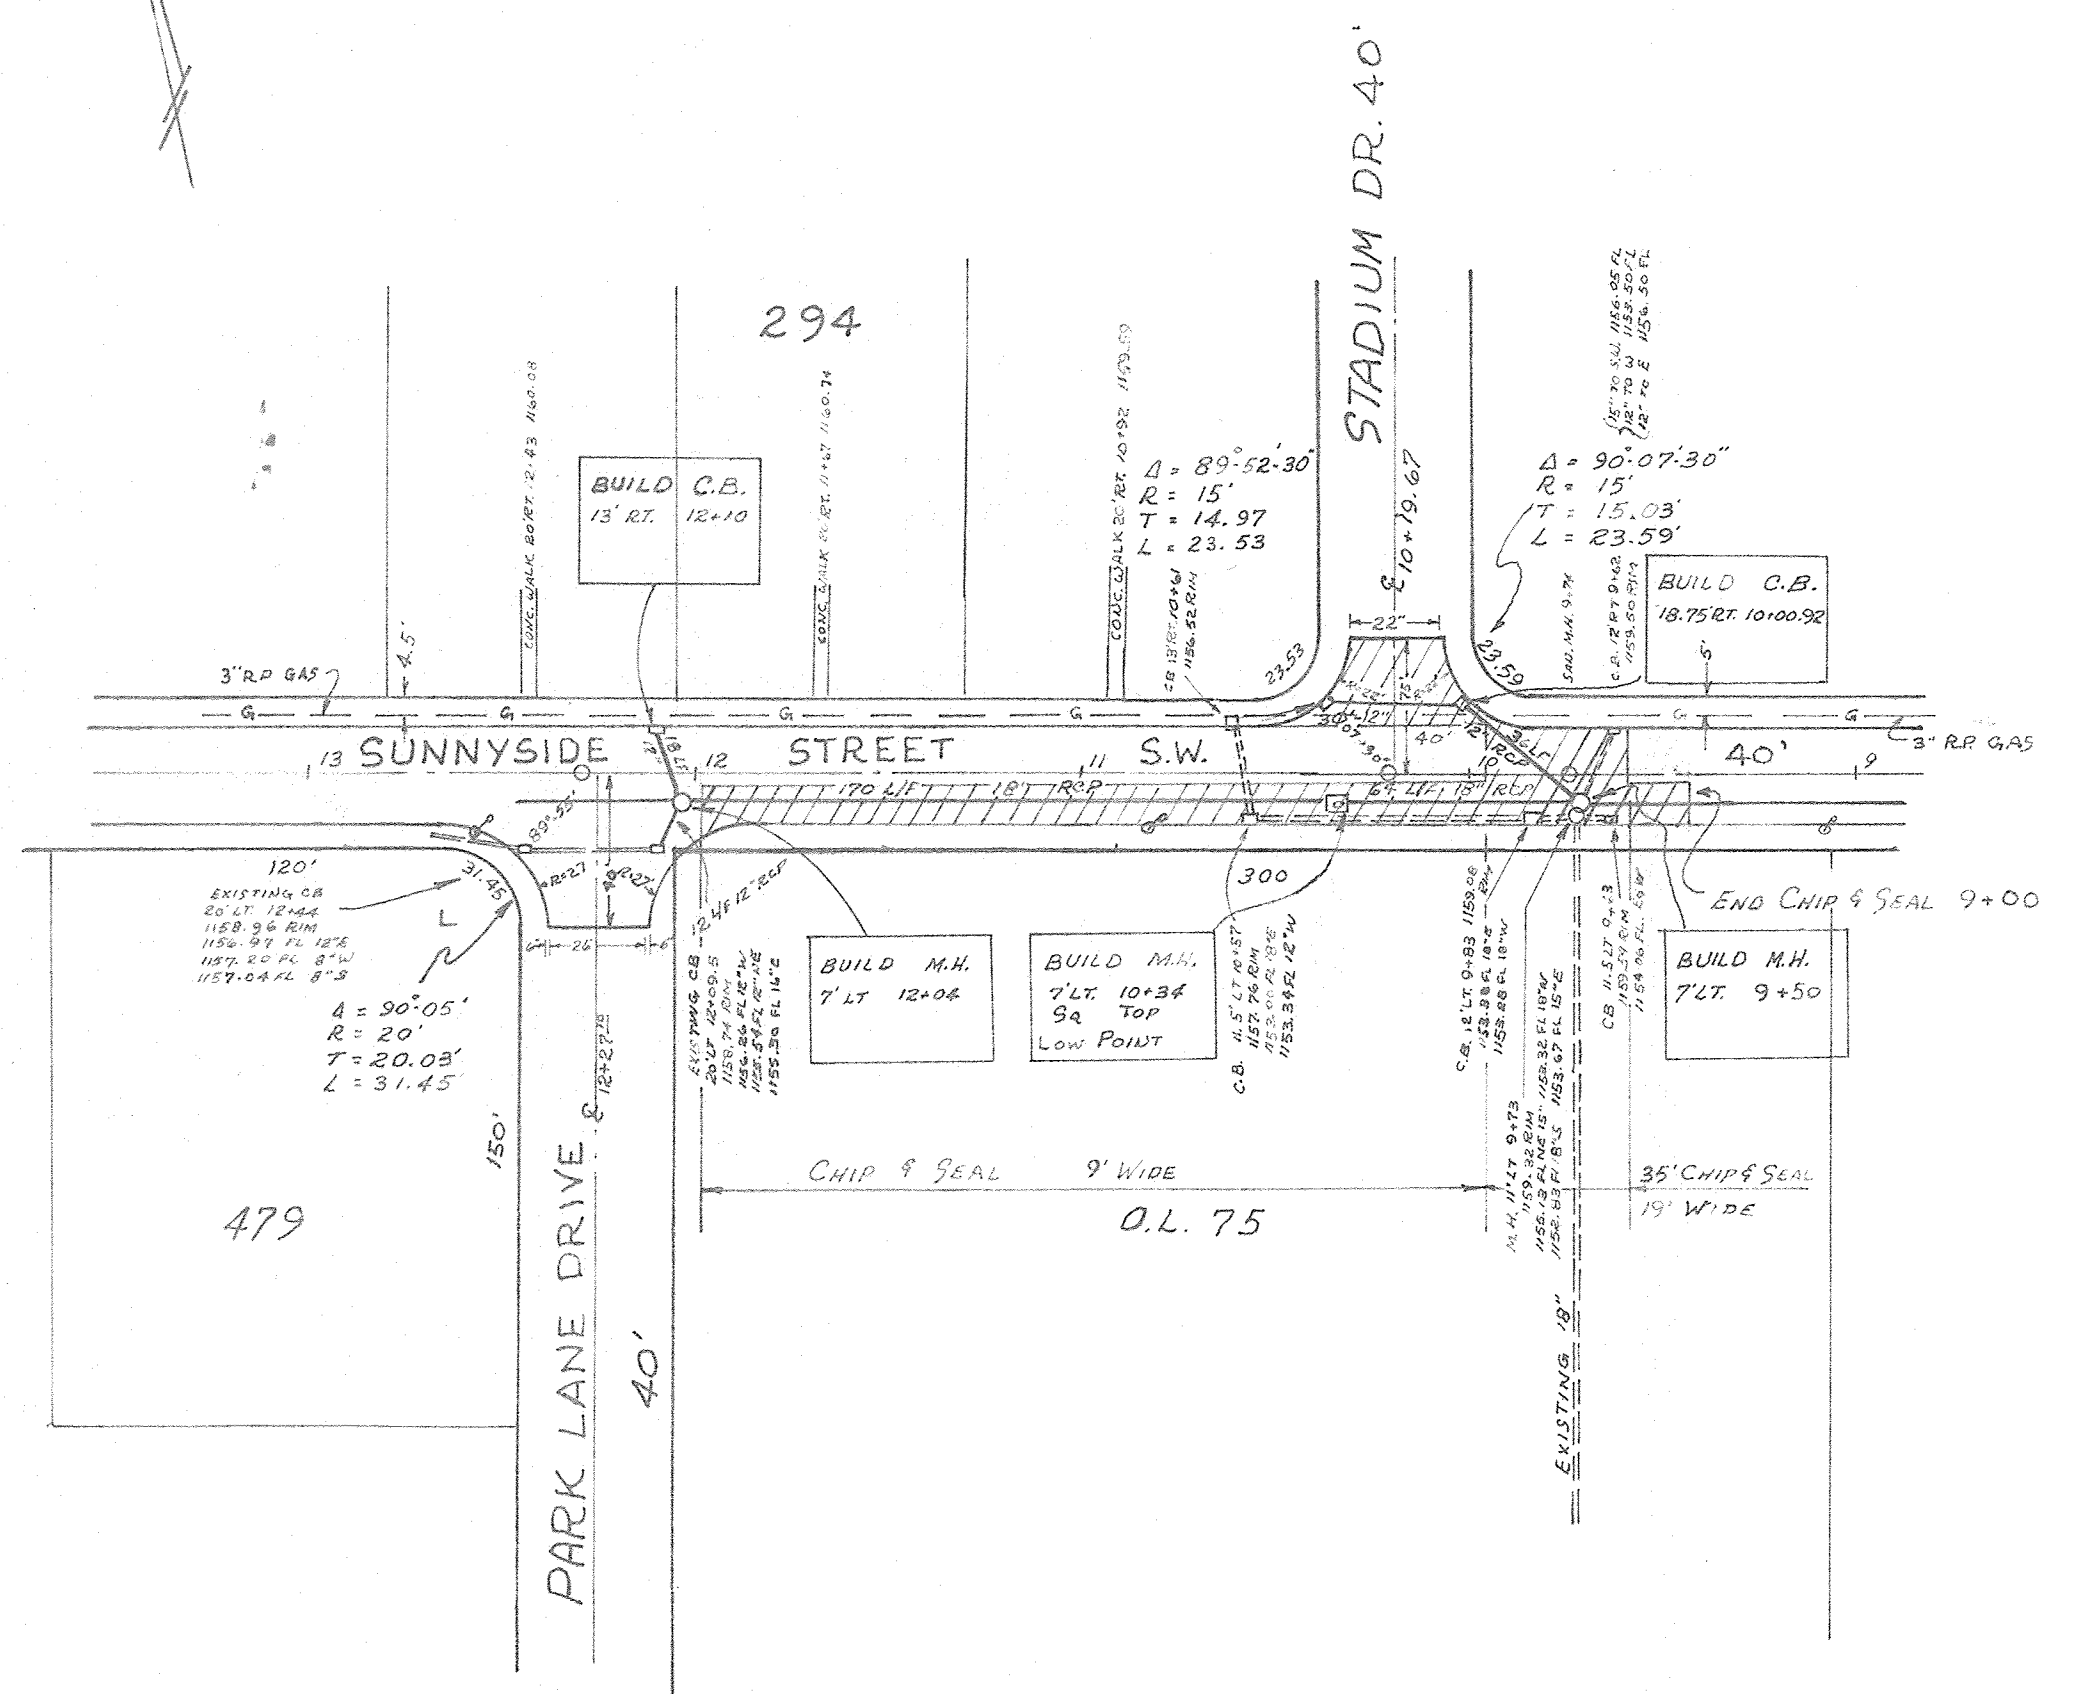


THIS PLAN APPROVED AND ACCEPTED BY THE STARK COUNTY ENGINEER

SIGNED _____ DATE _____

NOTE: DRAWING SHOWS PROJECT AS CONSTRUCTED
PROJECT COMPLETED OCTOBER, 1973

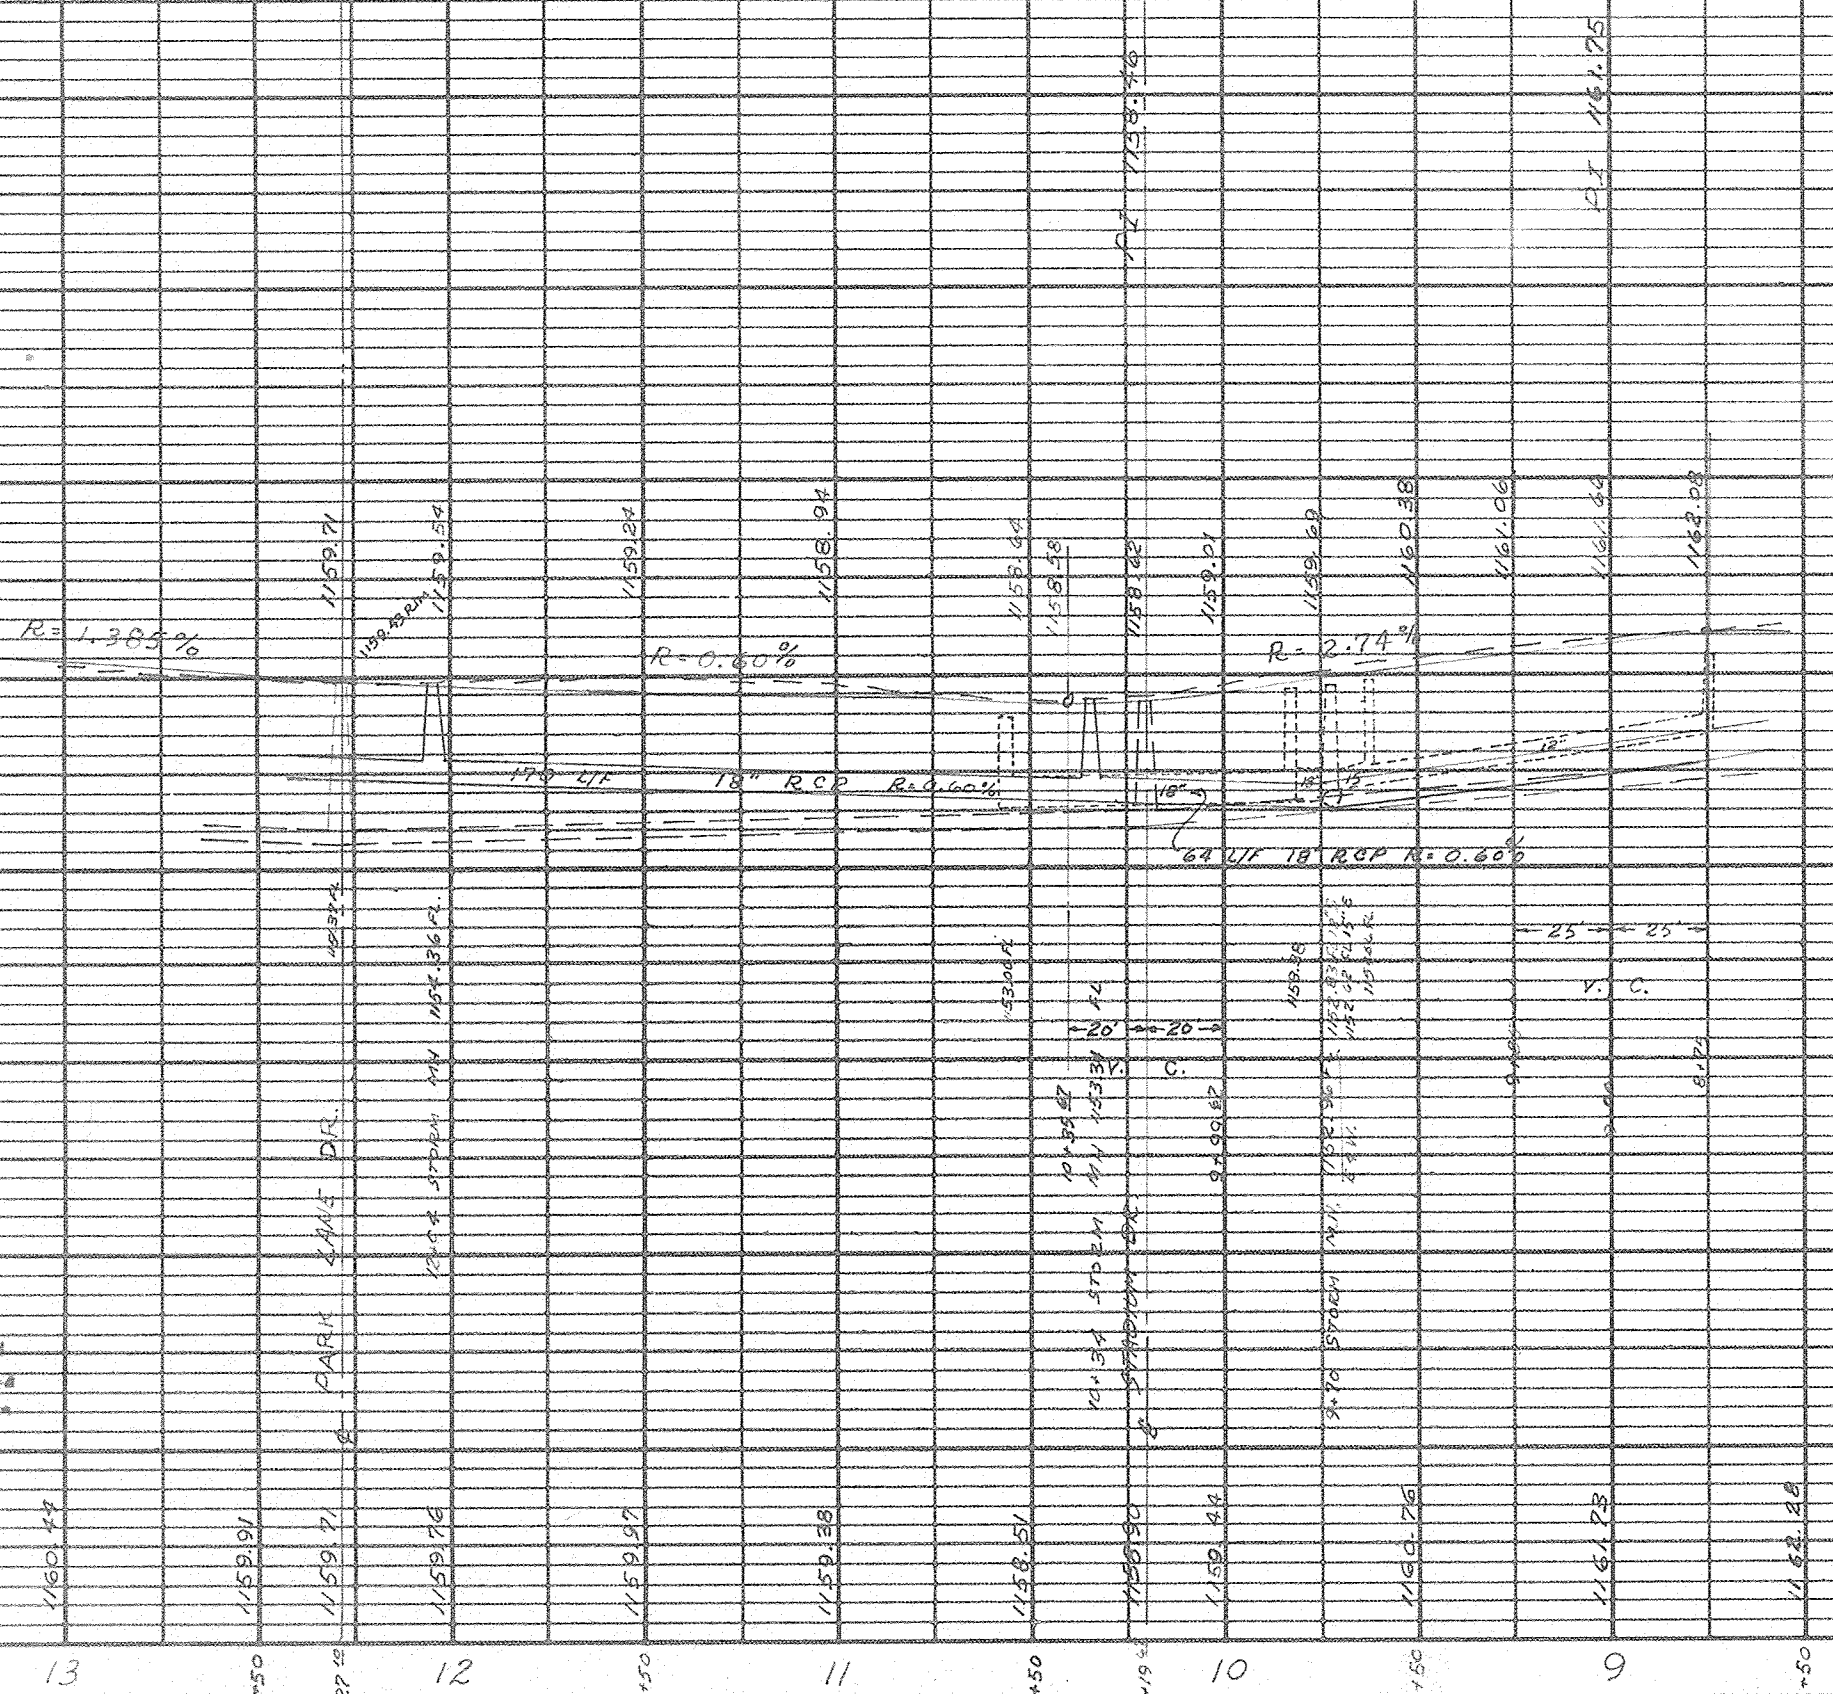


PLAN & PROFILE
SUNNYSIDE STREET S.W.
VILLAGE OF HARTVILLE, OHIO
L. W. J. COOPER & ASSOCIATES
ENGINEERS & SURVEYORS
L. W. J. COOPER, LEO J. JENNINGS JR., R. A. MILLER, W. J. MEOLA
SCALE: HORIZ. 1"=50' VERT. 1"=10' JULY, 1973

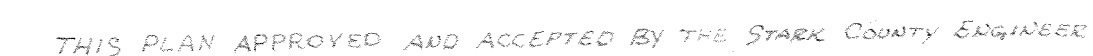

5/6 NE

DAT

NOTE: DRAWING SHOWS PROJECT AS CONSTRUCTED
PROJECT COMPLETED OCTOBER, 1973



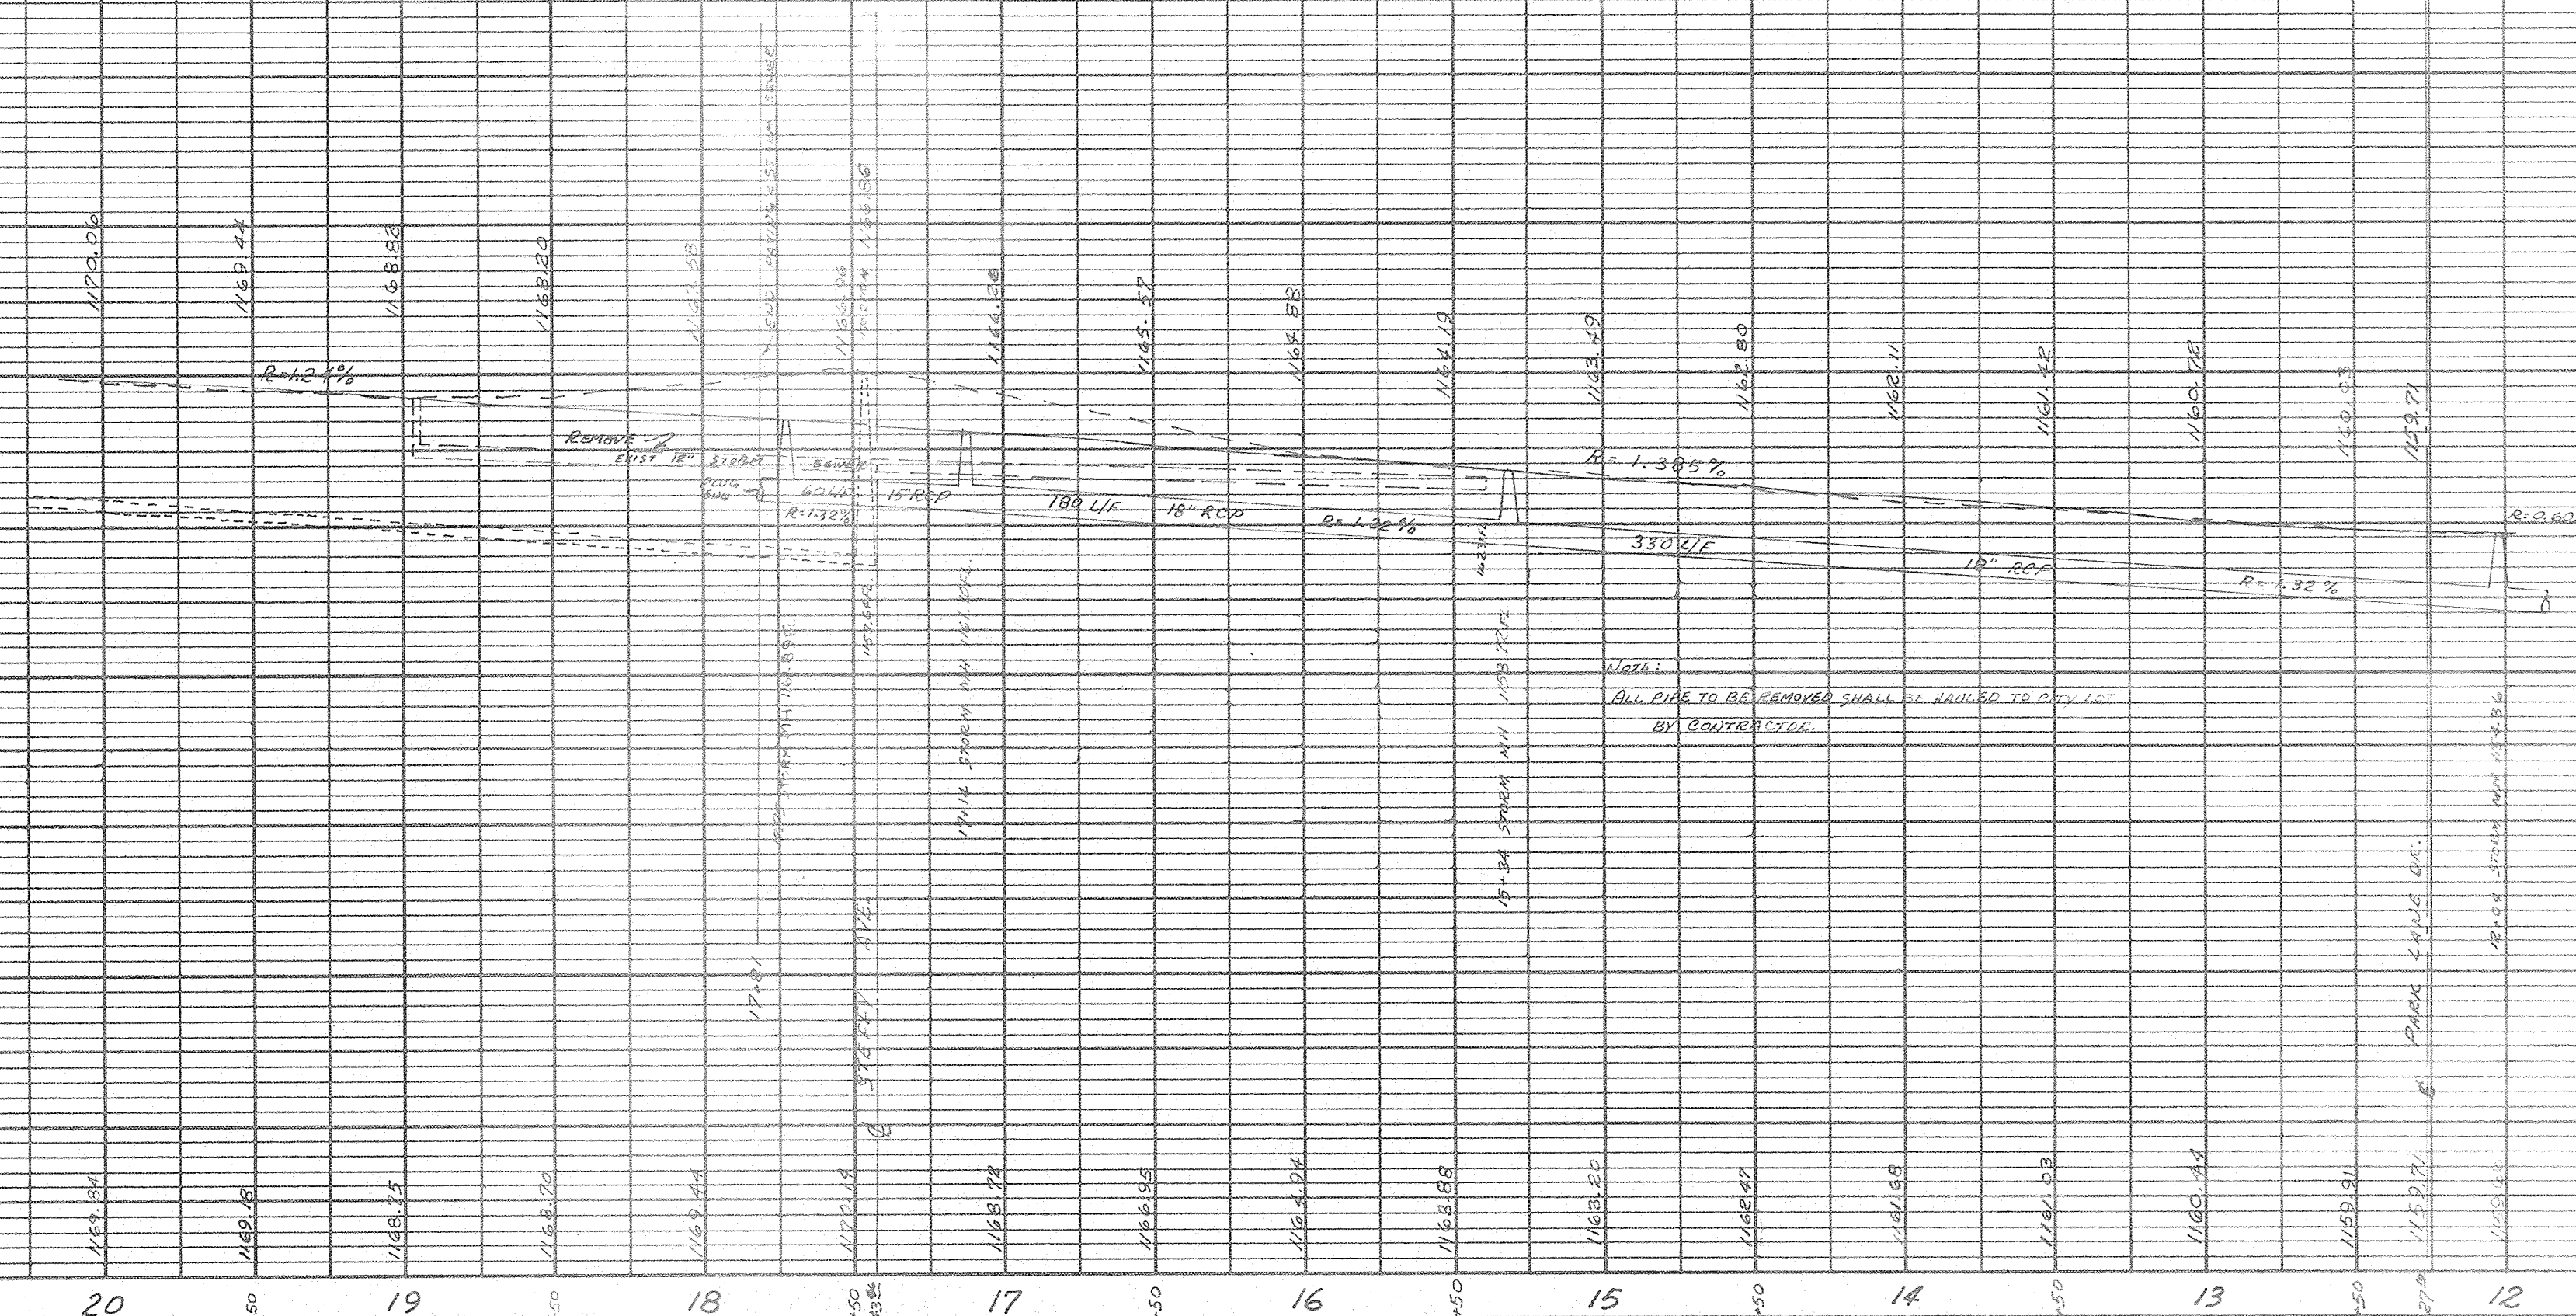


1180

1170

1166

PLAN & PROFILE
SUNNYSIDE STREET S.W.
VILLAGE OF HARTVILLE, OHIO
L. W. J. COOPER & ASSOCIATES
ENGINEERS & SURVEYORS
J. L. COOPER J. E. D. JUNGEMANN JR. R. A. MILLER W. J. M. BLO
SCALE HOR. 1" = 50'
VERT. 1" = 10' JULY, 1971

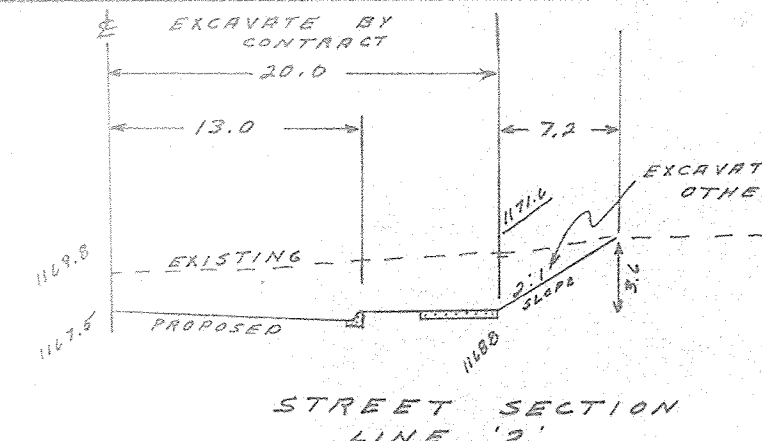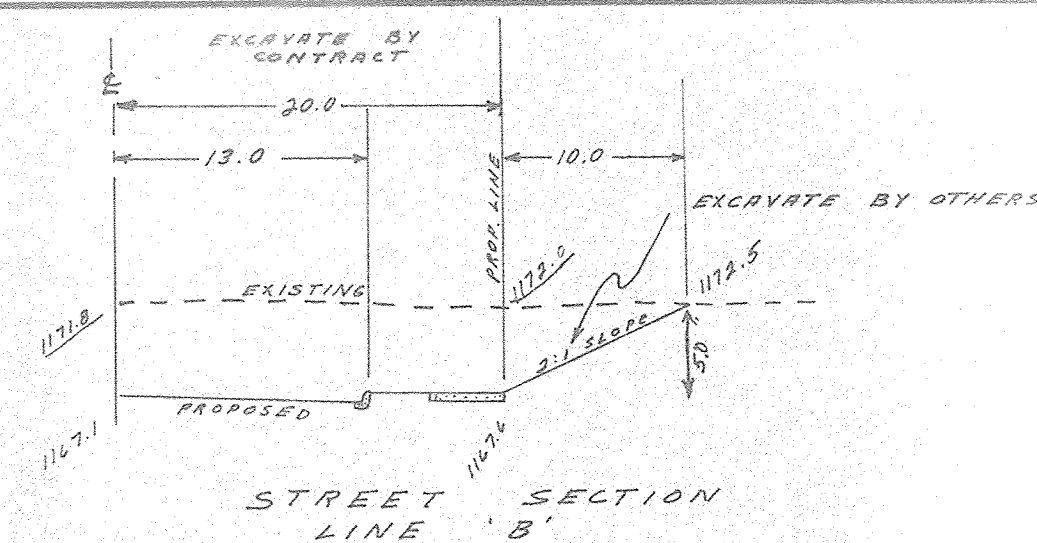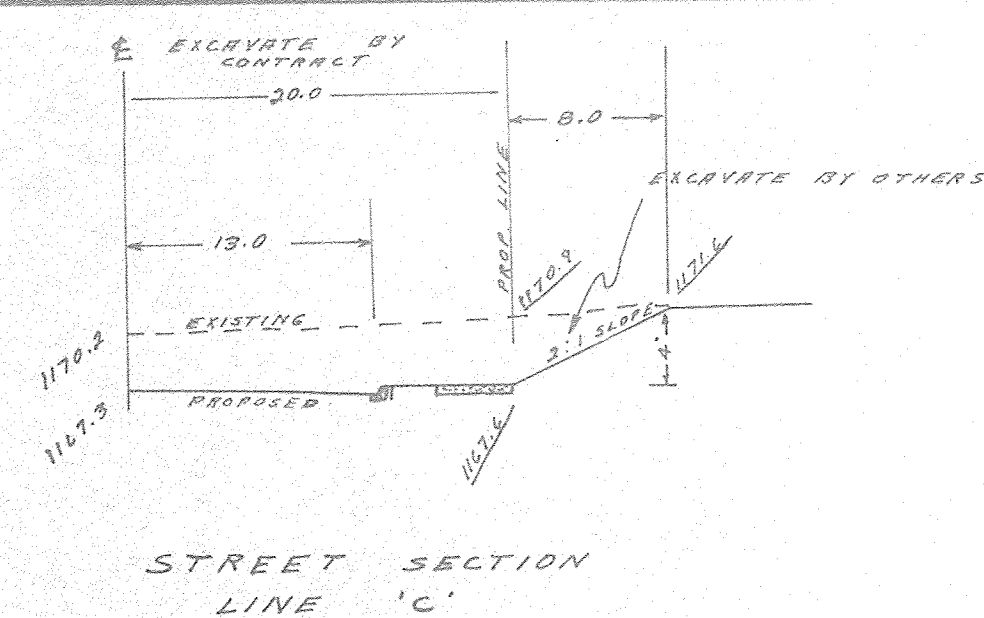




4" Gravel 20.0' Parking Lot.
Placed & Rolled by Village
Grade furnished by Village
Engineer.
PROPOSED
PARKING
LOT

Escher Lot 296







SUNNYSIDE ST.

STEFFY AVE

THIS PLAN APPROVED AND ACCEPTED BY
THE STARK COUNTY ENGINEER.

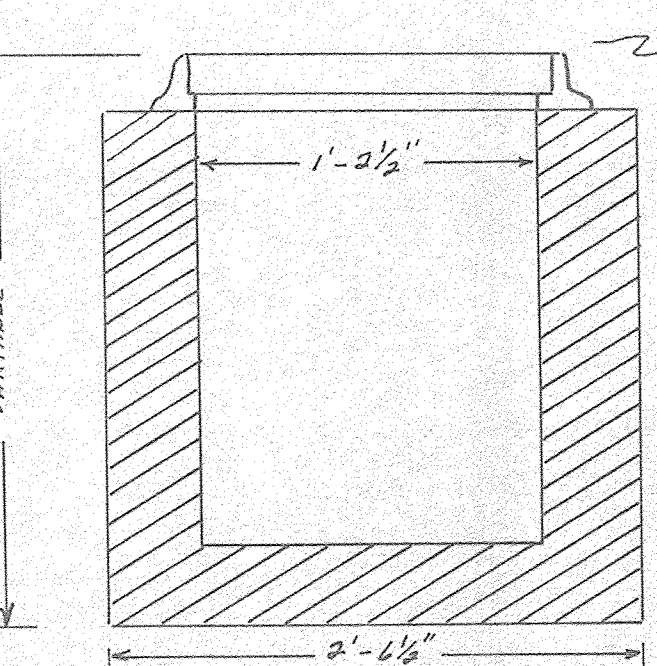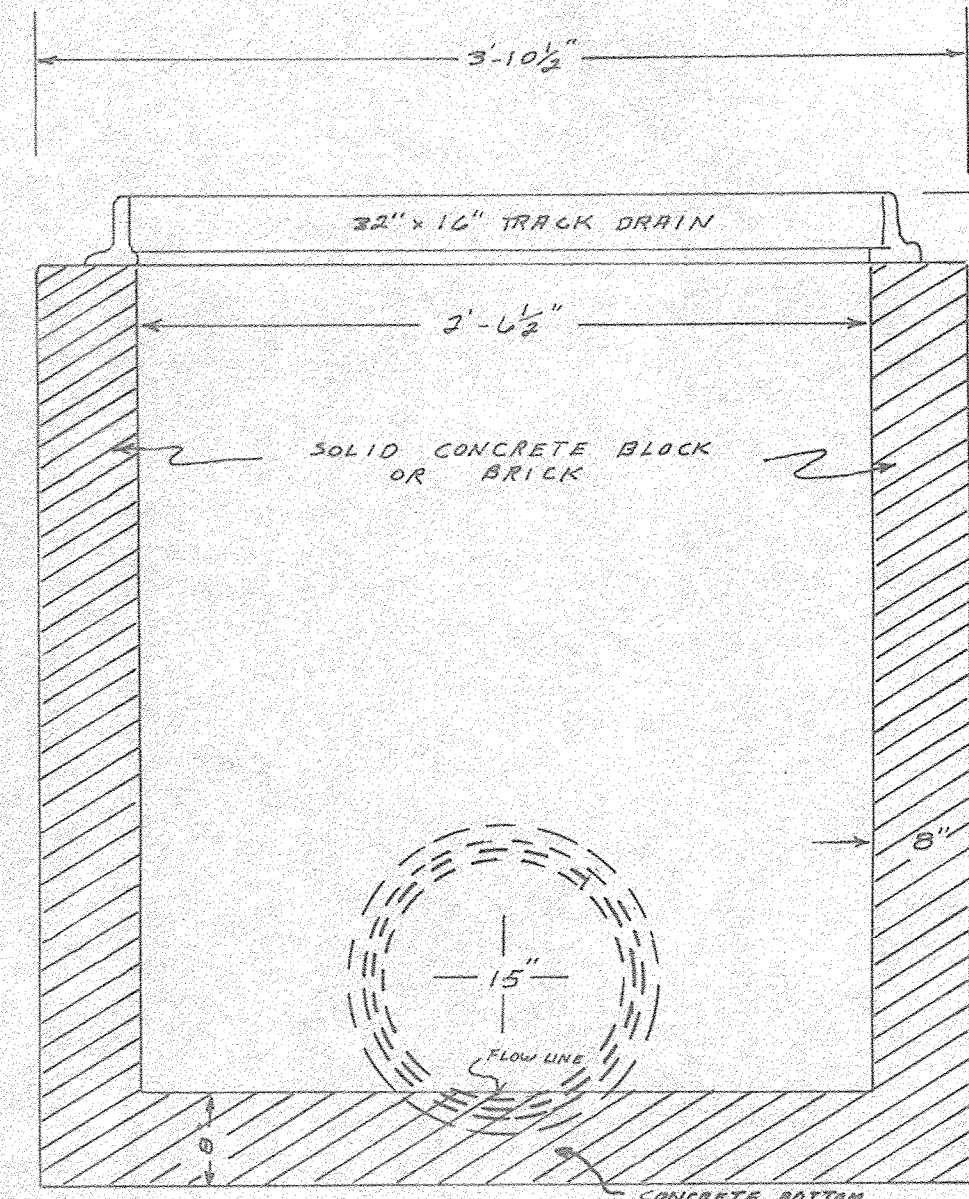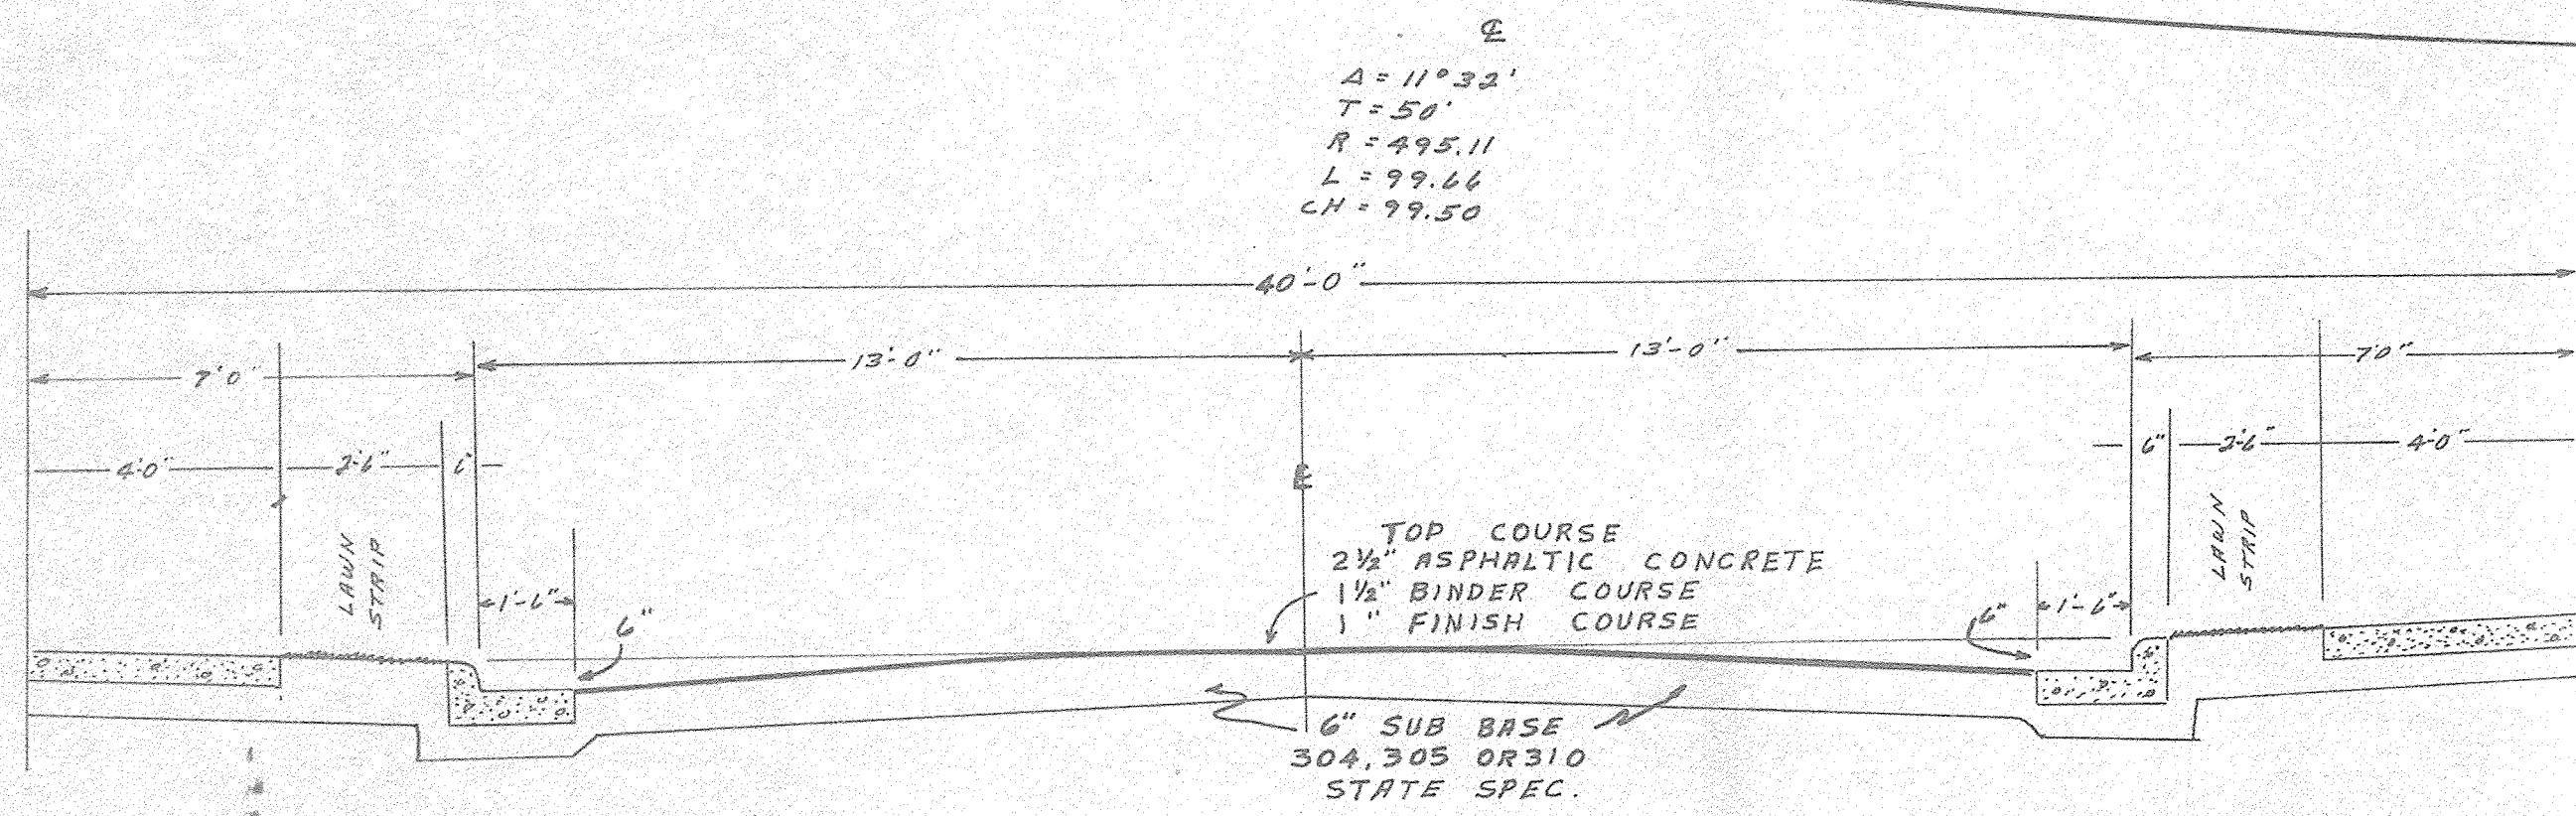

STANDARD PLAN
CATCH BASIN
FOR 32" x 16" TRACK DRAIN

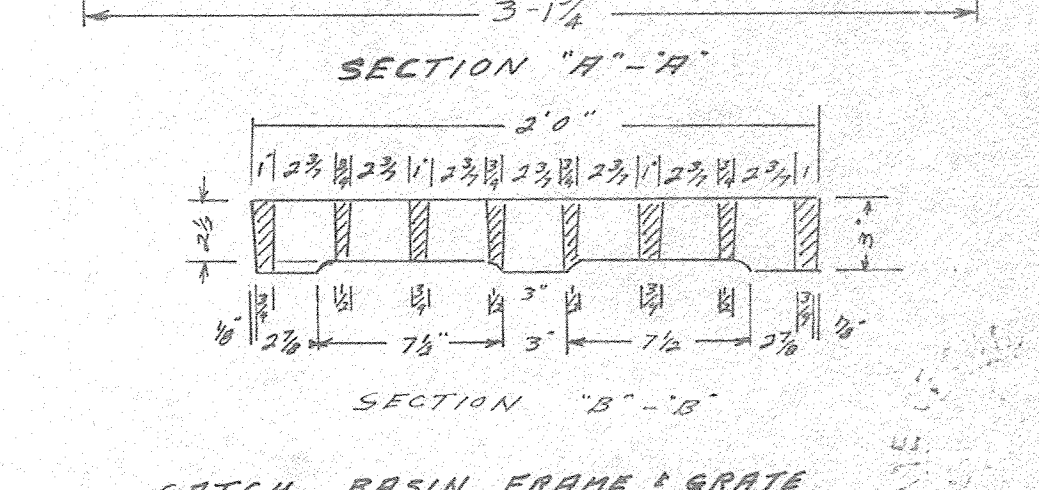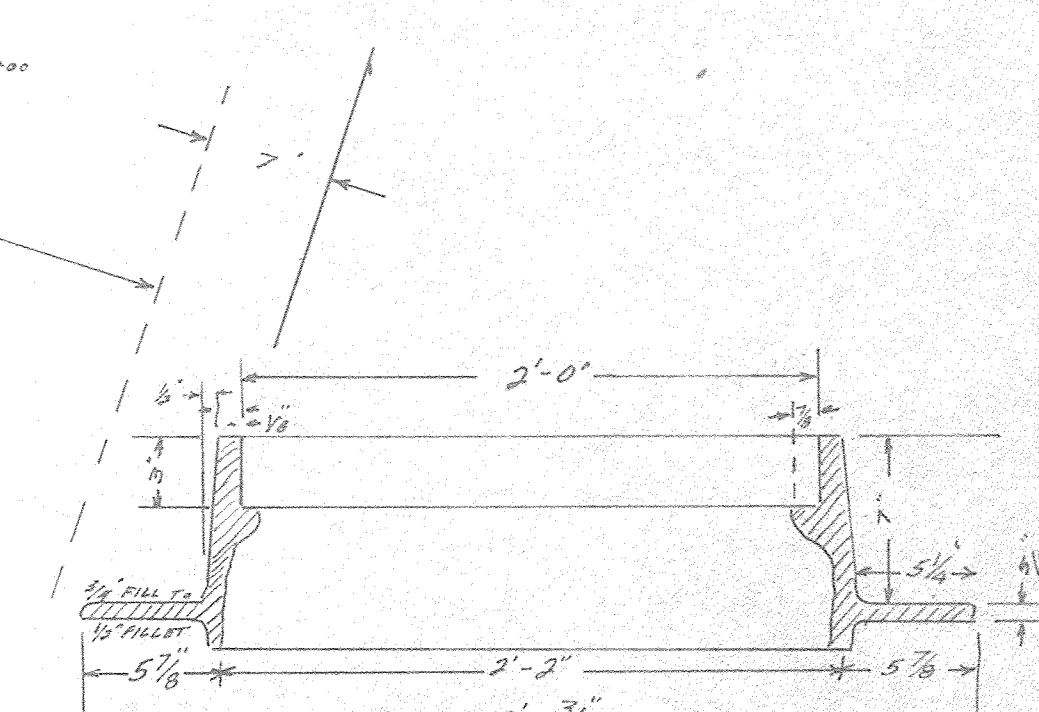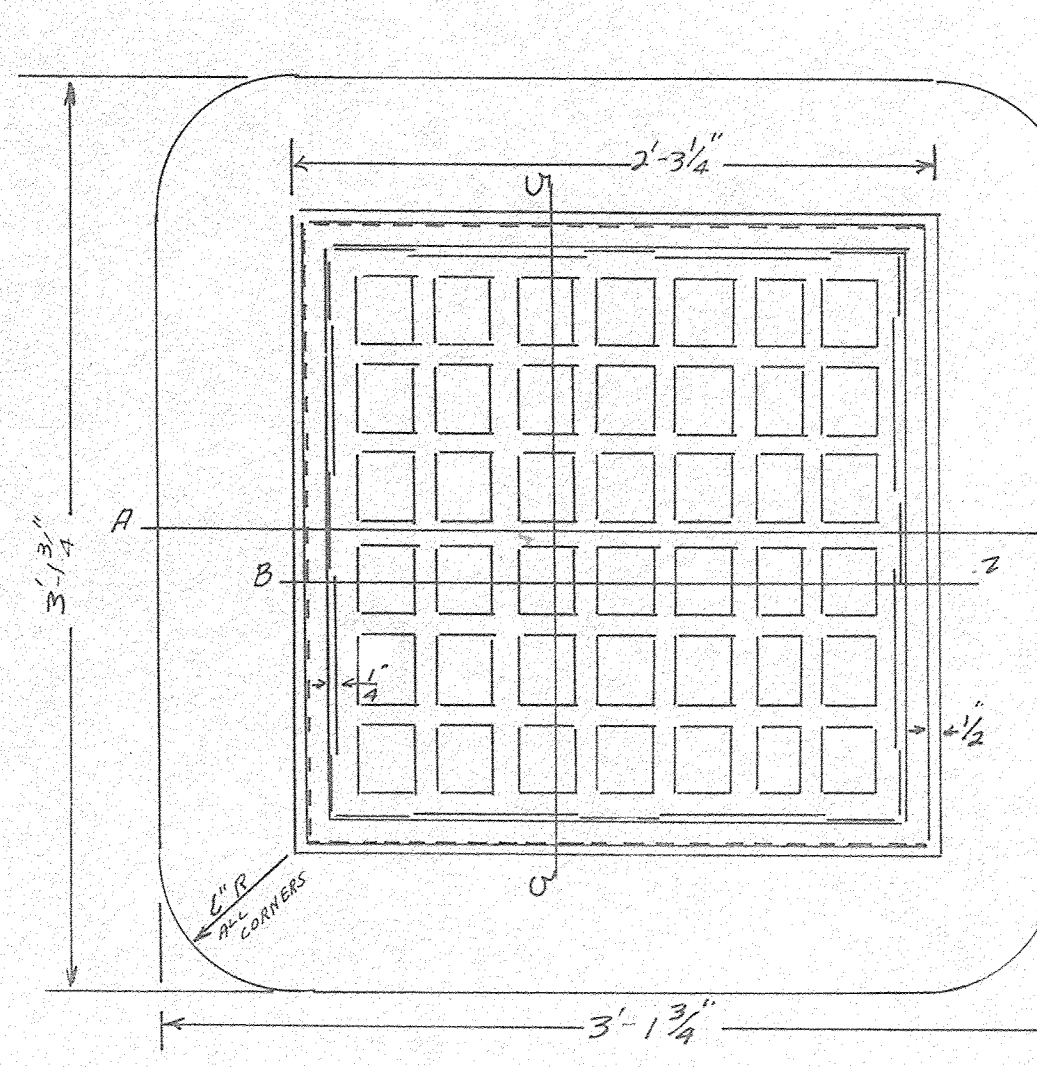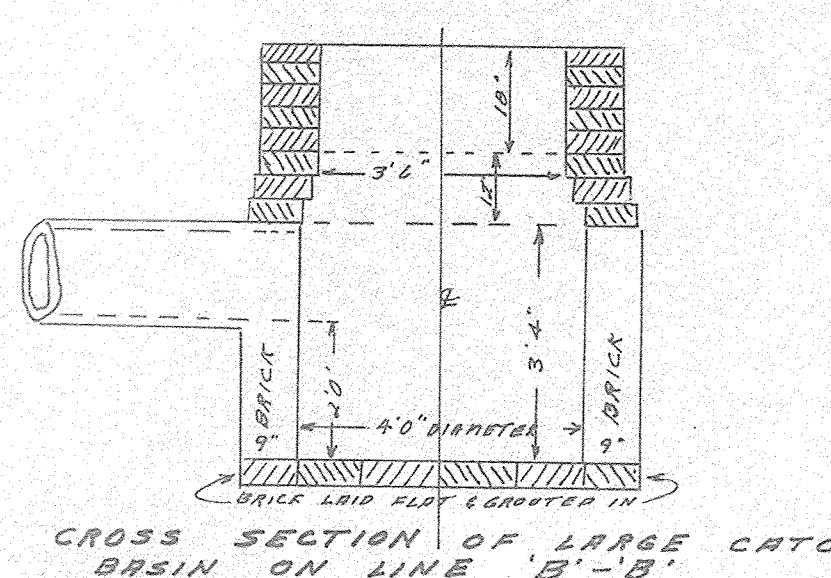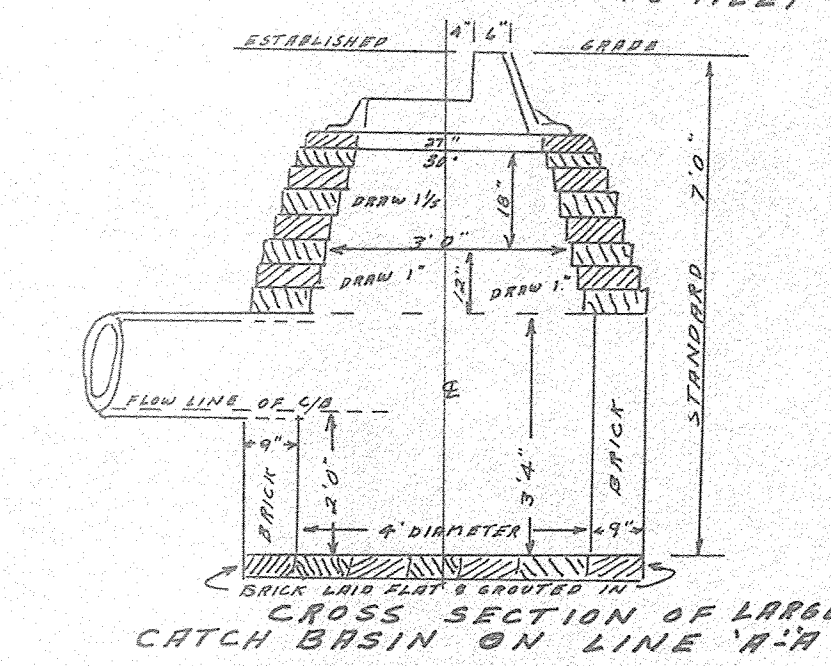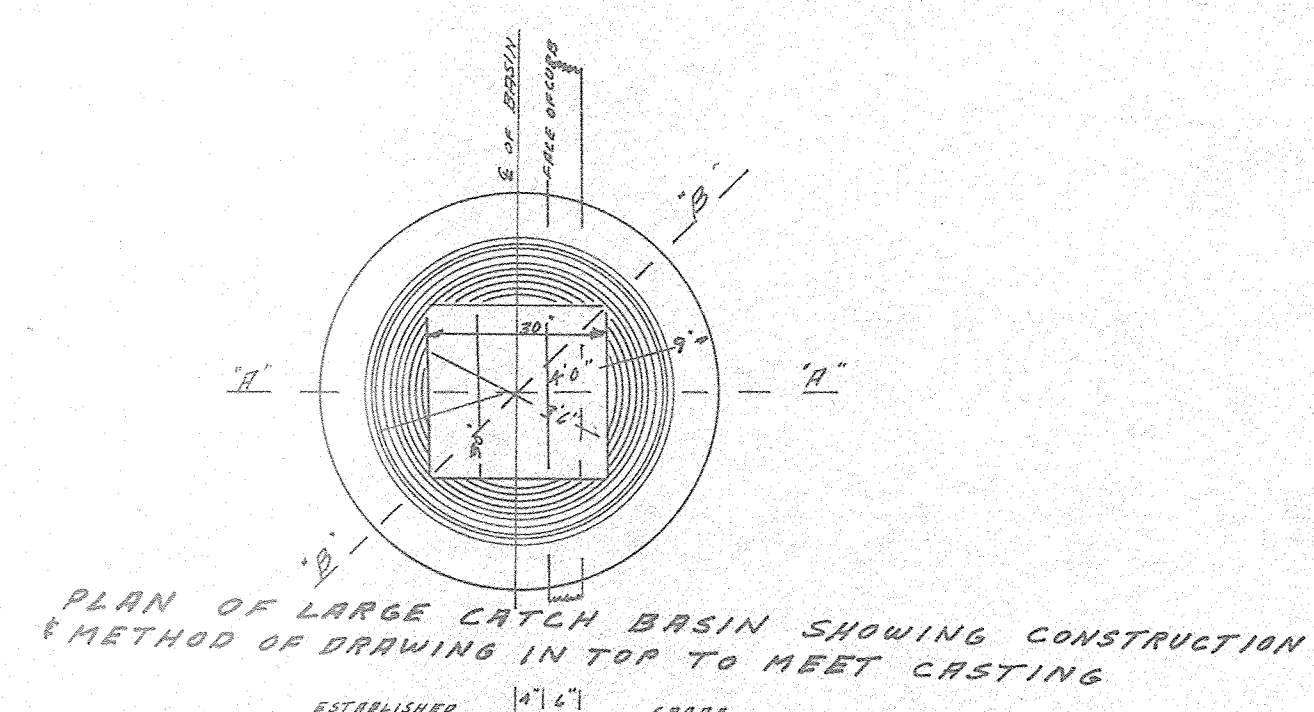

STEFFY AVE & PART OF SUNNYSIDE ST.
PAVING & SEWER IMPROVEMENTS
FOR
THE VILLAGE OF HARTVILLE, OHIO

L. W. J. COOPER & ASSOCIATES
CONSULTING ENGINEER & SURVEYORS


JAMES L. COOPER • J. ED. JUENEMANN, JR. • ROBERT A. MILLER • WILLIAM J. MEDLA
PHONE 492-3203 CANTON, OHIO 44705 201 LINCOLN AVE. N.W.

SURVEYED	PLATTED	FIELD BOOK	DATE	FILE	SCALE

225 FF. 53 N° 40A

PLAN	SUBMITTED	BY	DATE
NO. 500A	PLANNED		
	ALIGNED		
	CONSTRUCTED		
	NO. OF COPY		


PROFILE	SUBMITTED	BY	DATE
NO. 500A	PLANNED		
	ALIGNED		
	CONSTRUCTED		
	NO. OF COPY		

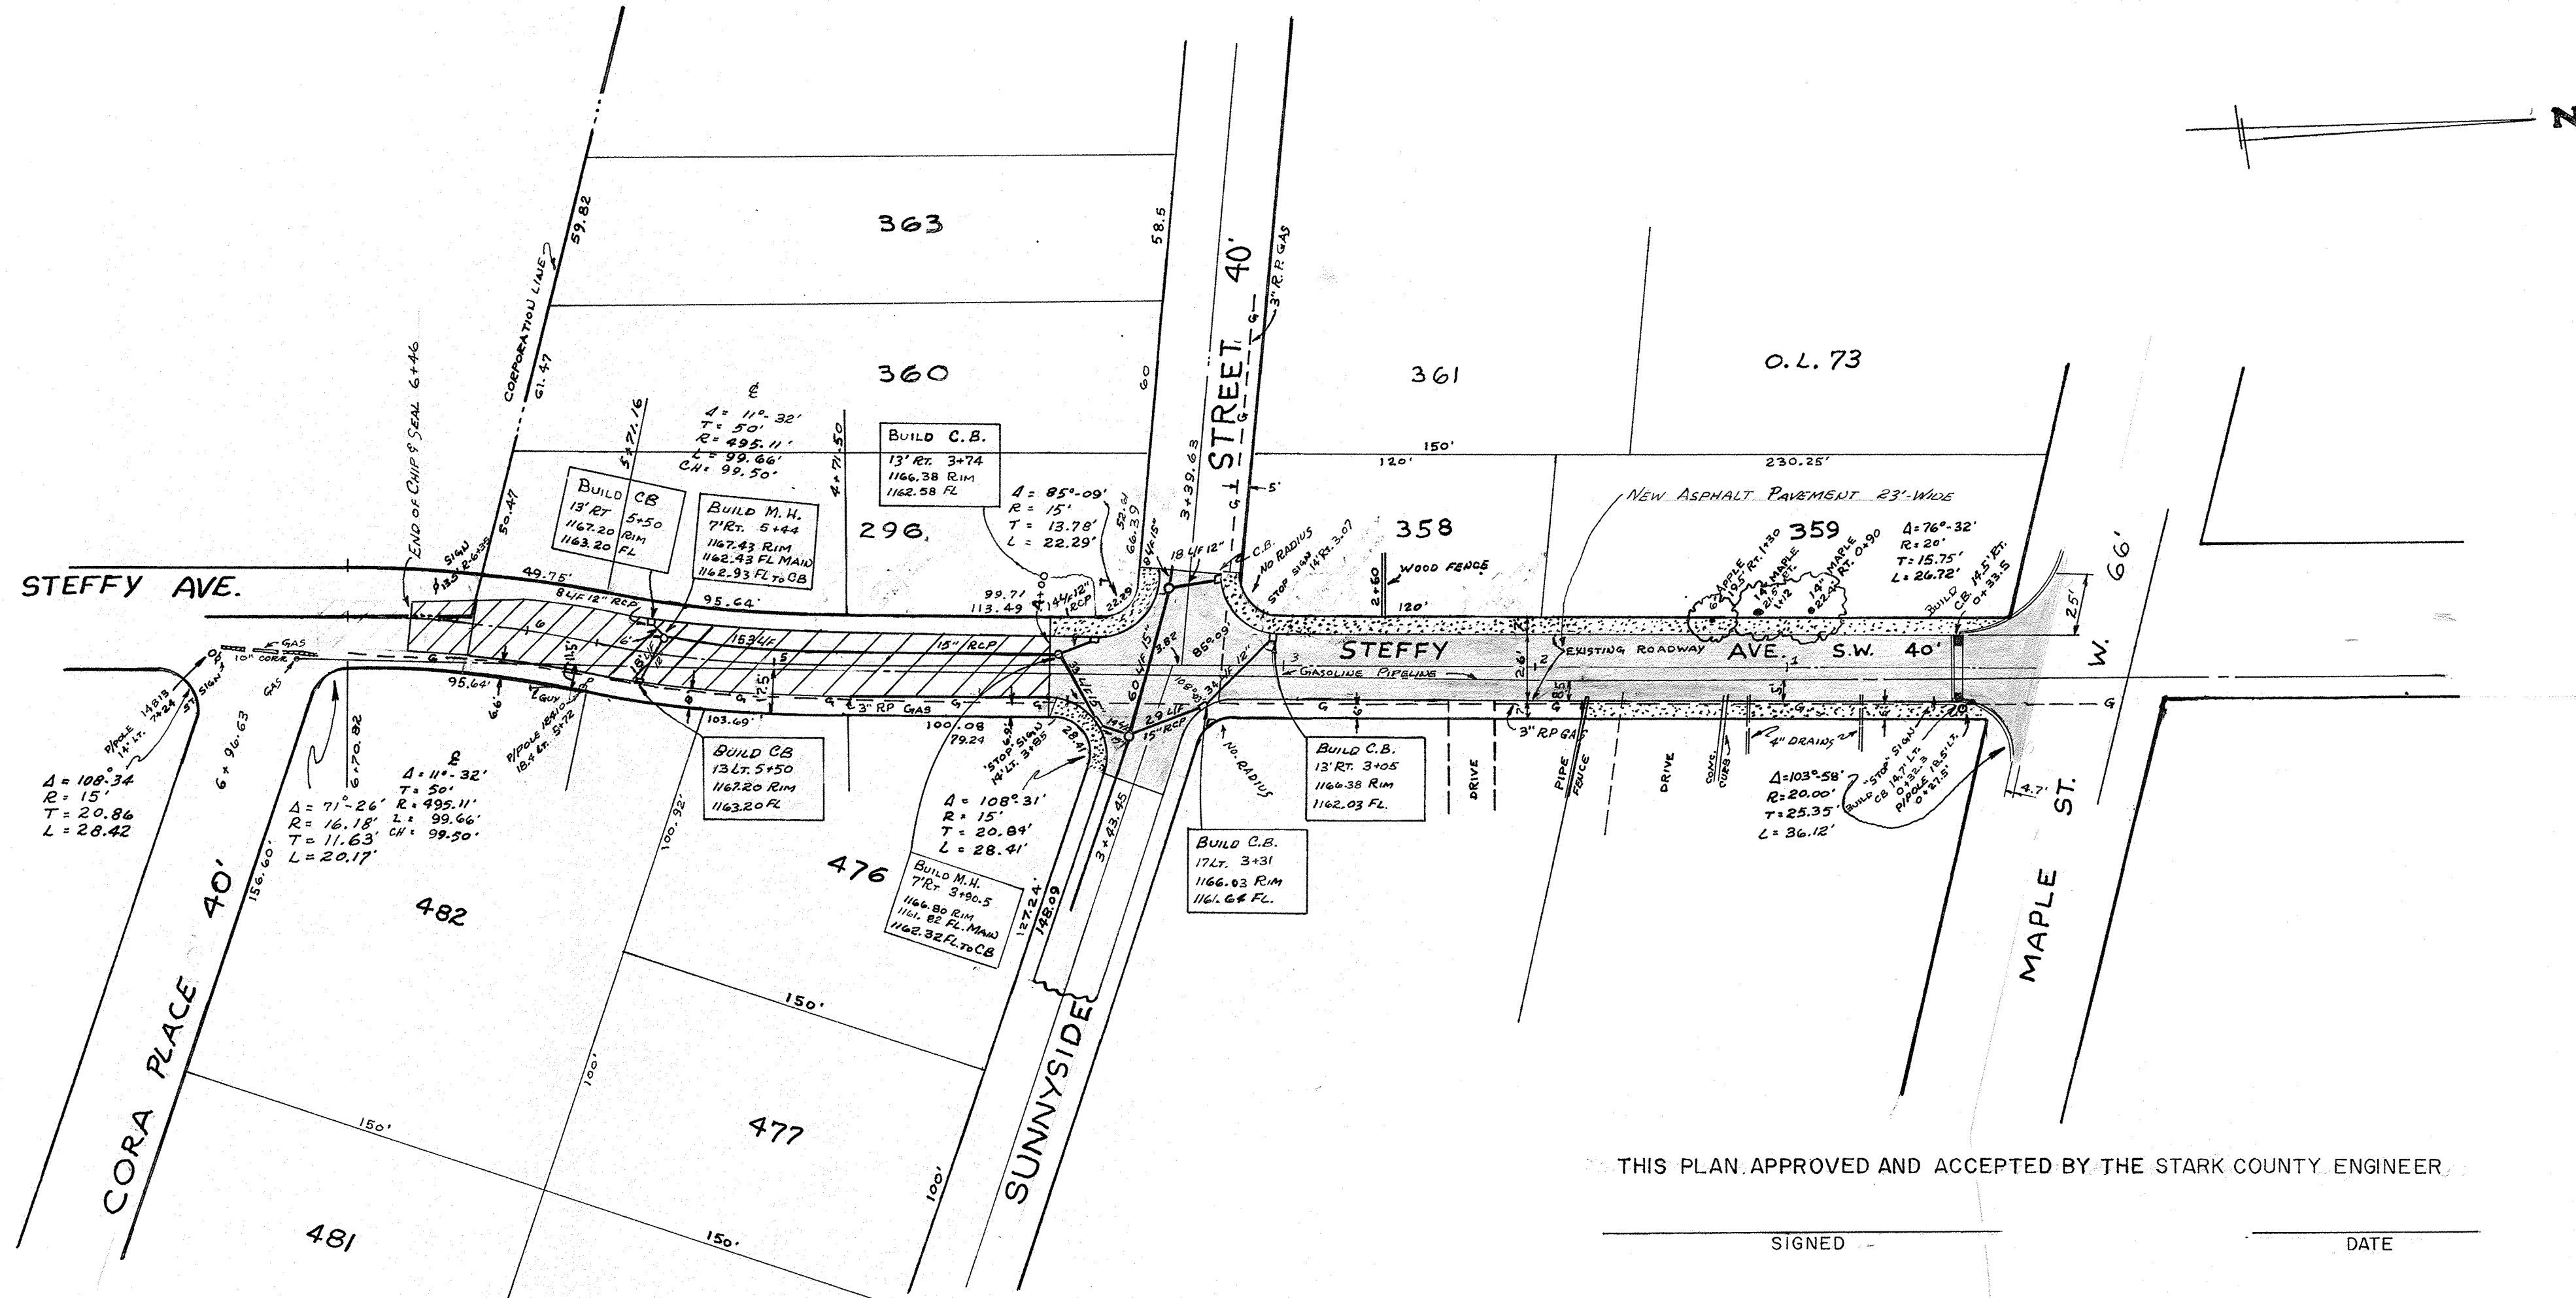

THIS PLAN APPROVED AND ACCEPTED BY THE STARK COUNTY ENGINEER


SIGNED _____ DATE _____

NOTE: DRAWING SHOWS PROJECT AS CONSTRUCTED
PROJECT COMPLETED OCTOBER, 1973

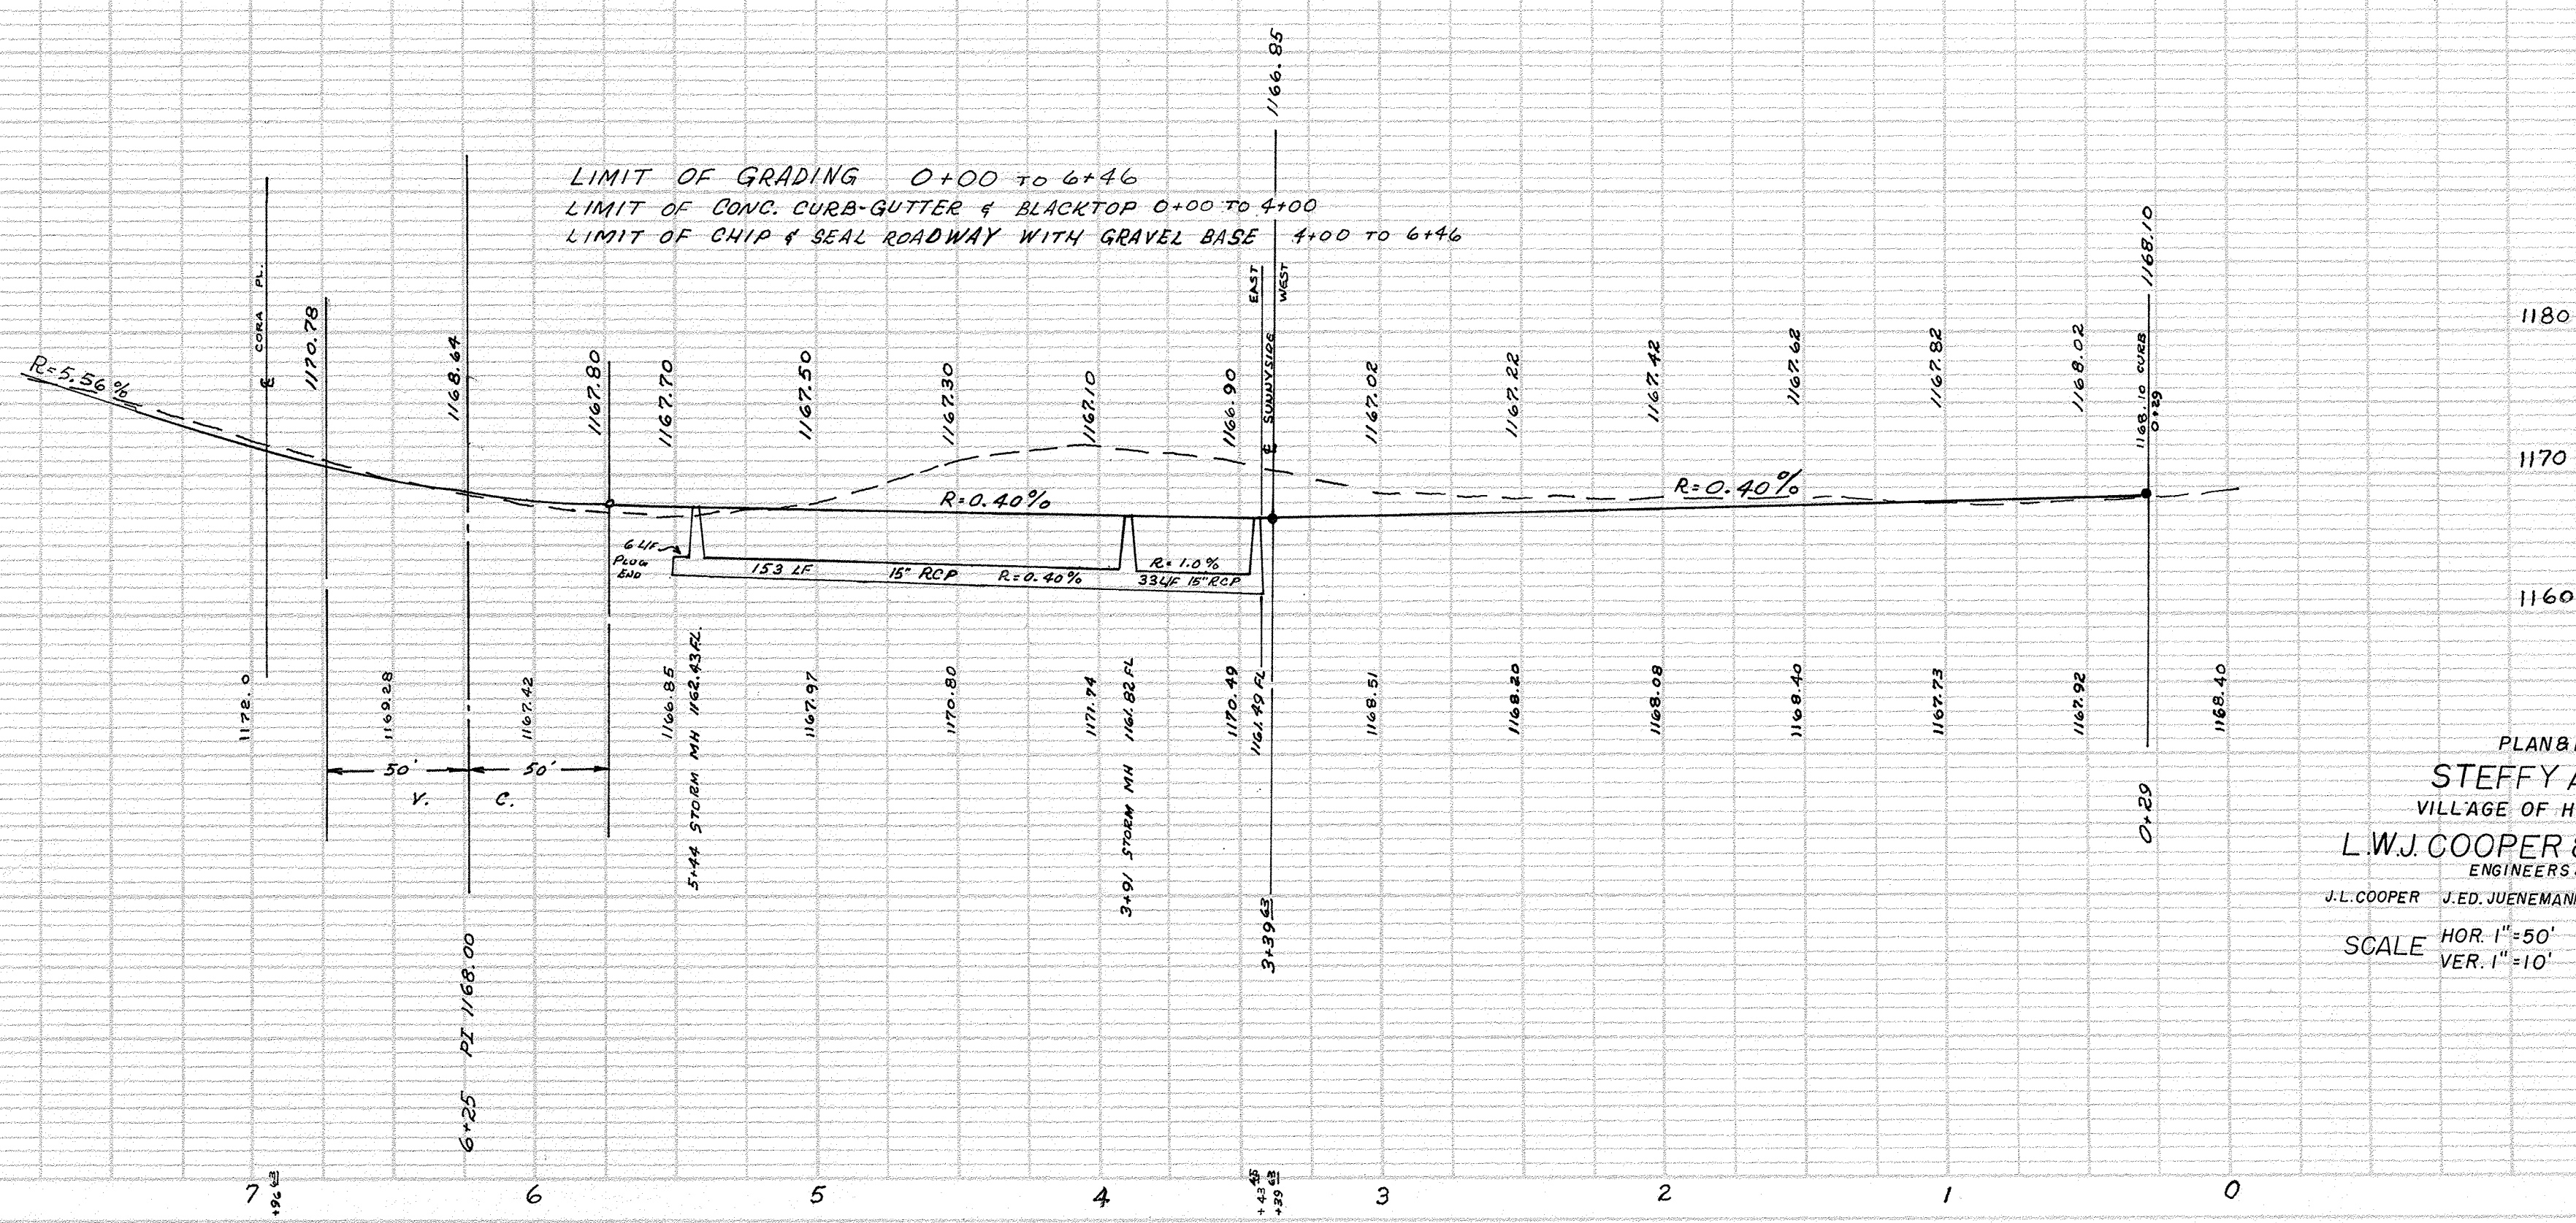

PLAN & PROFILE
STEFFY AVENUE SW.
VILLAGE OF HARTVILLE, OHIO
L.W.J. COOPER & ASSOCIATES
ENGINEERS & SURVEYORS
J.L. COOPER J. ED. JUENEMANN JR. R.A. MILLER W.J. MEOLA
SCALE HOR. 1"=50' VER. 1"=10' JUNE, 1971

PLAN	SURVEYED	BY	DATE
PLATTED			
CHECKED			
DATE			
NOTE BOOK			
NO.			

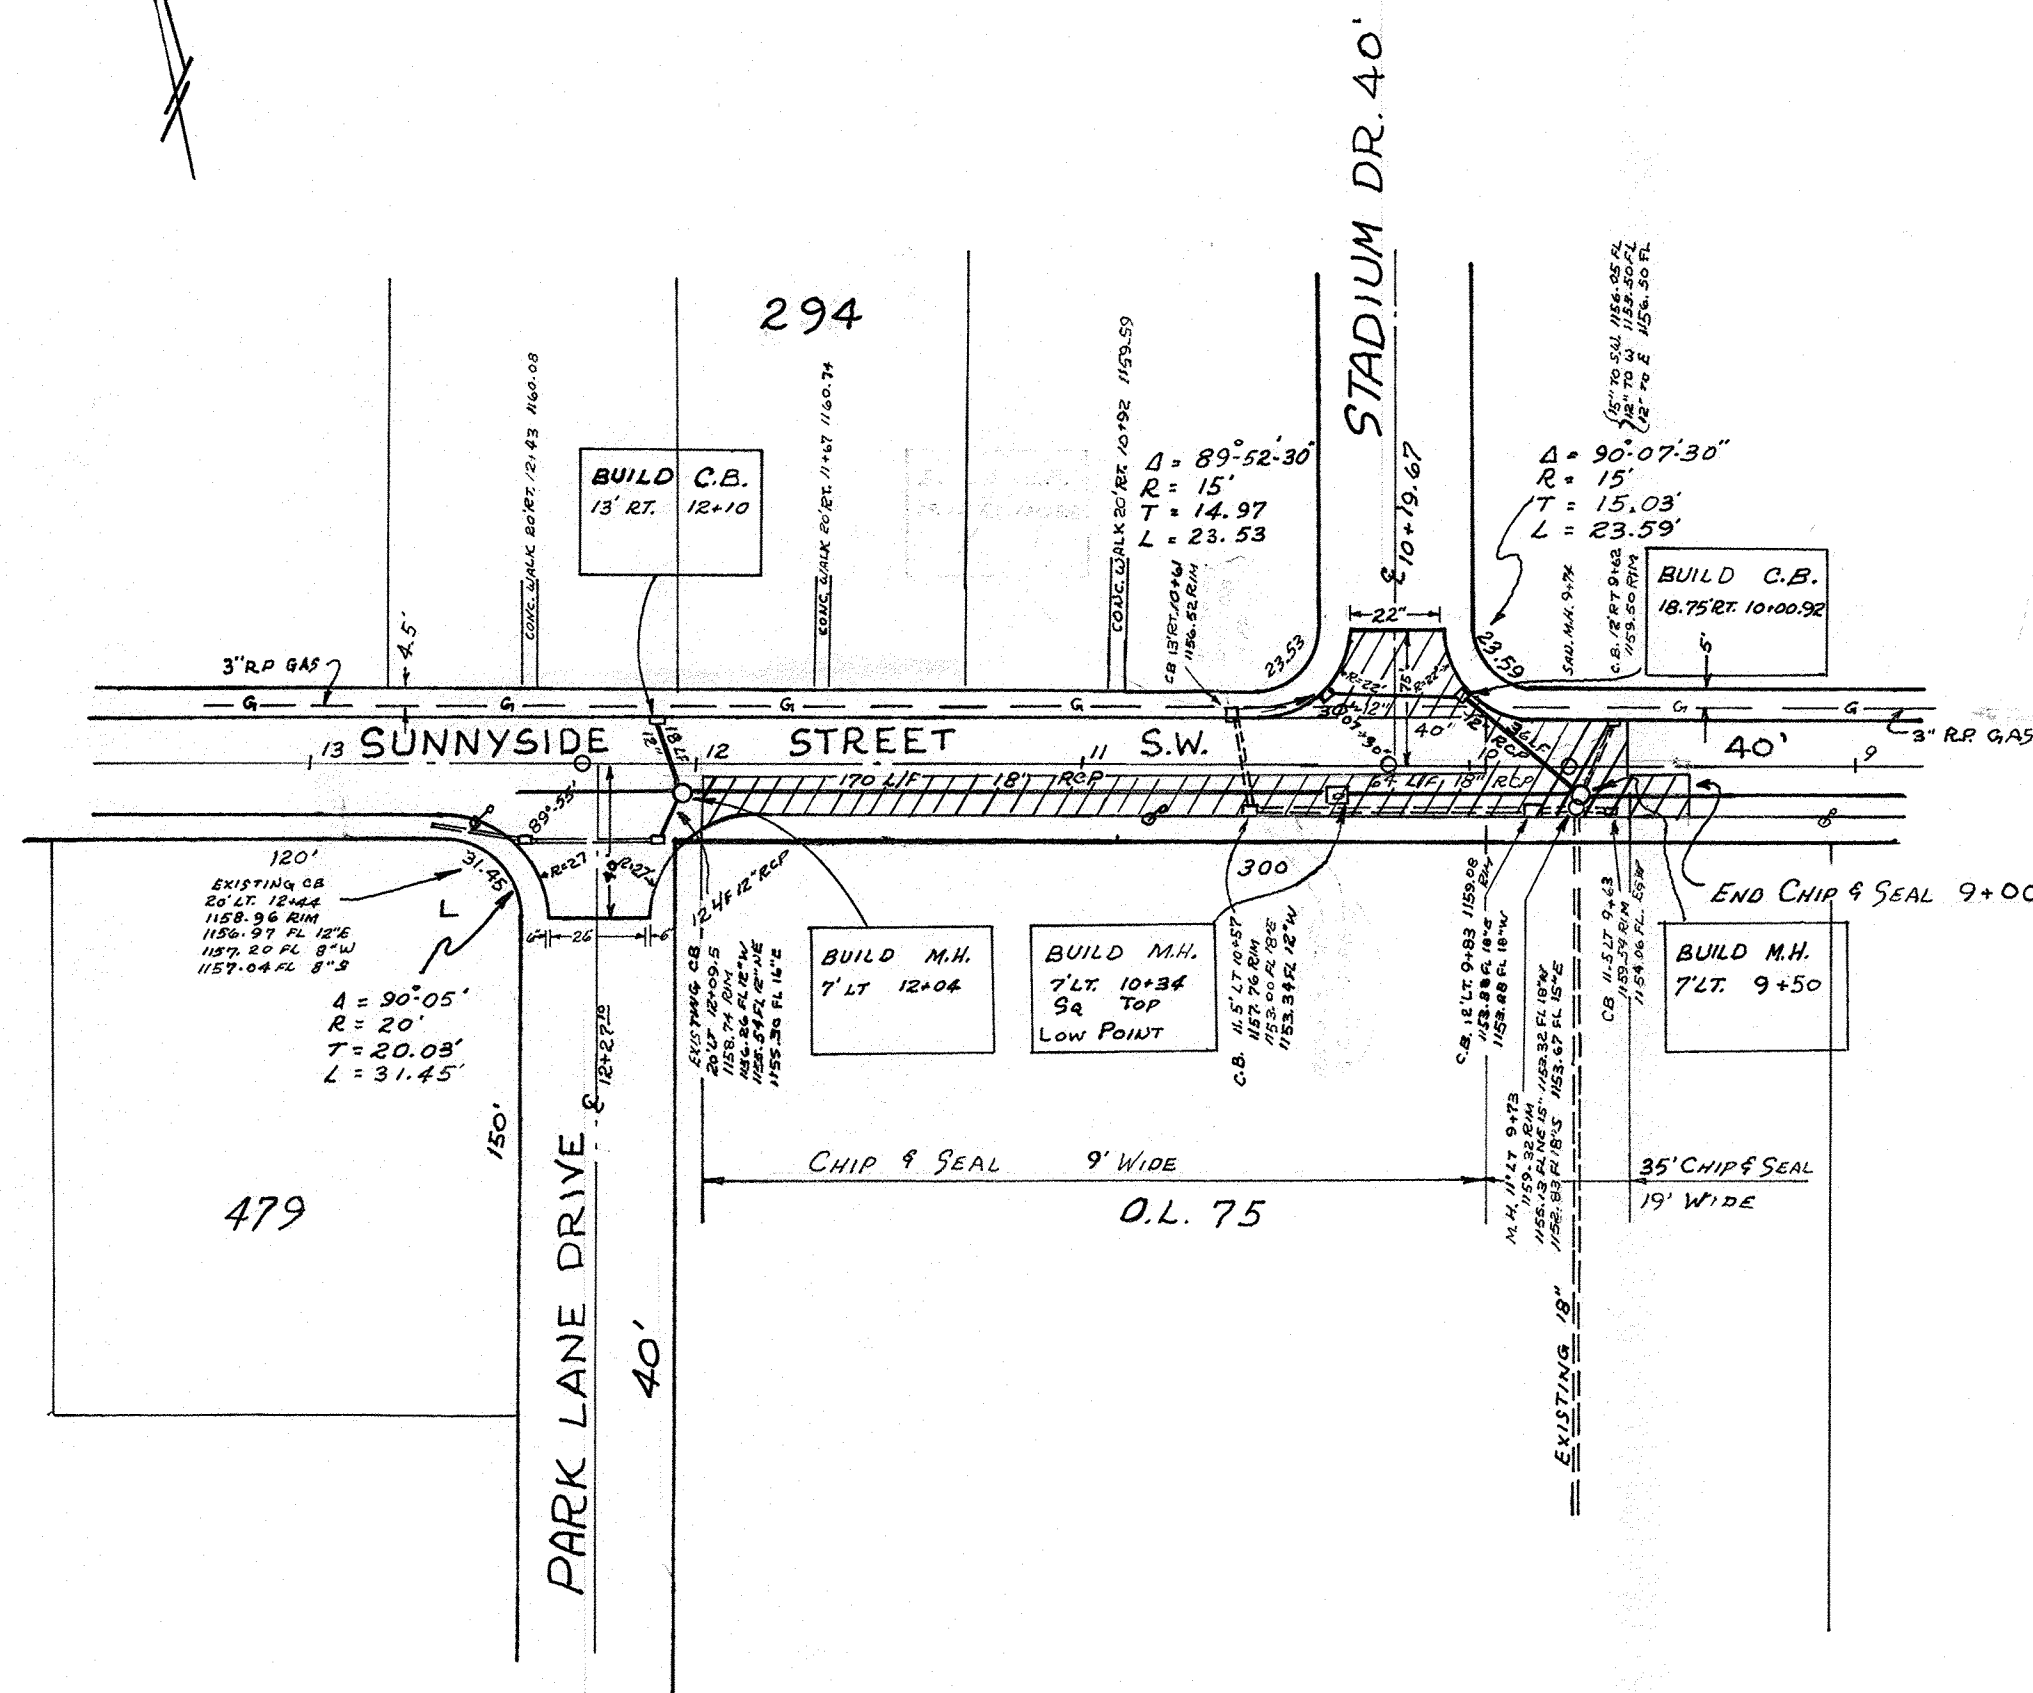


THIS PLAN APPROVED AND ACCEPTED BY THE STARK COUNTY ENGINEER

SIGNED

DATE


NOTE: DRAWING SHOWS PROJECT AS CONSTRUCTED
PROJECT COMPLETED OCTOBER, 1973

PROFILE	SURVEYED	BY	DATE
PLATTED			
CHECKED			
DATE			
NOTE BOOK			
NO.			

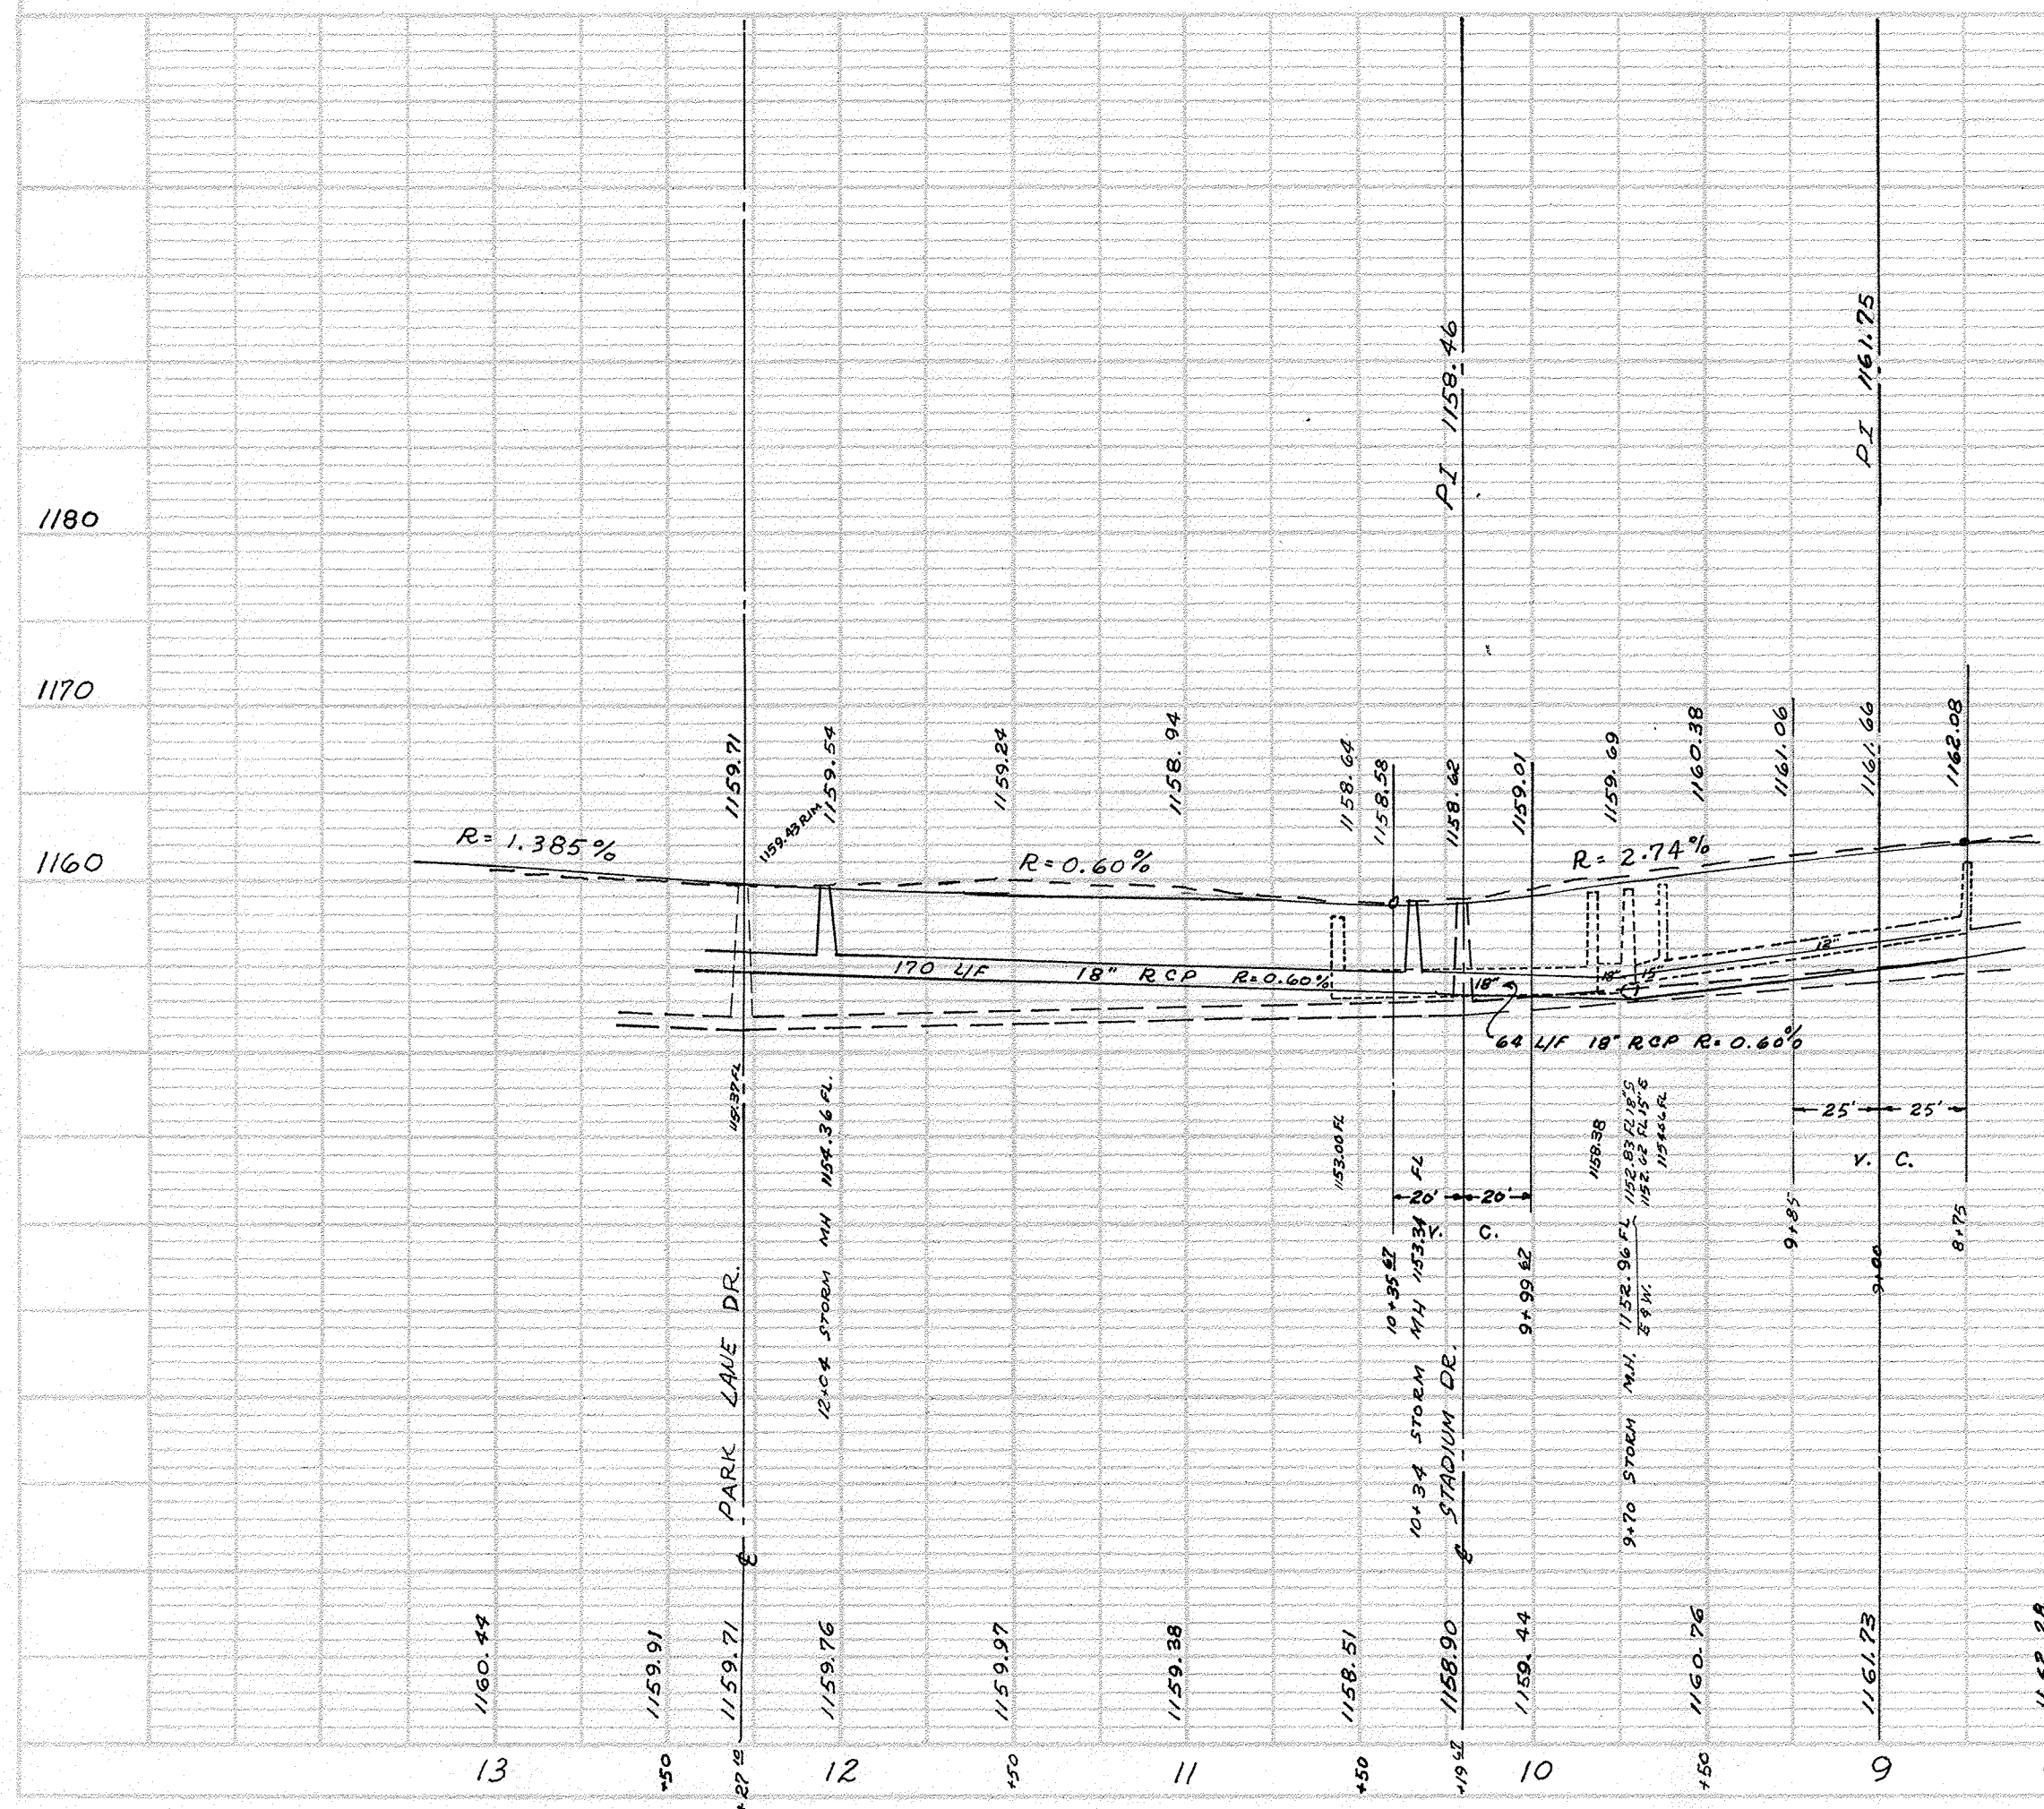

PLAN & PROFILE
SUNNYSIDE STREET S.W.
VILLAGE OF HARTVILLE, OHIO
L.W.J. COOPER & ASSOCIATES
ENGINEERS & SURVEYORS
J.L. COOPER J.E.D. JUENEMANN JR. R.A. MILLER W.J. MEOLA
SCALE HOR. 1"=50' JULY, 1973
VER. 1"=10'

PLAN	BY	DATE
SURVEYED		
PLOTTED		
NOTE BOOK		
ALIGNMENT CHECKED		
ST. OF WORK CHECKED		
NO.		

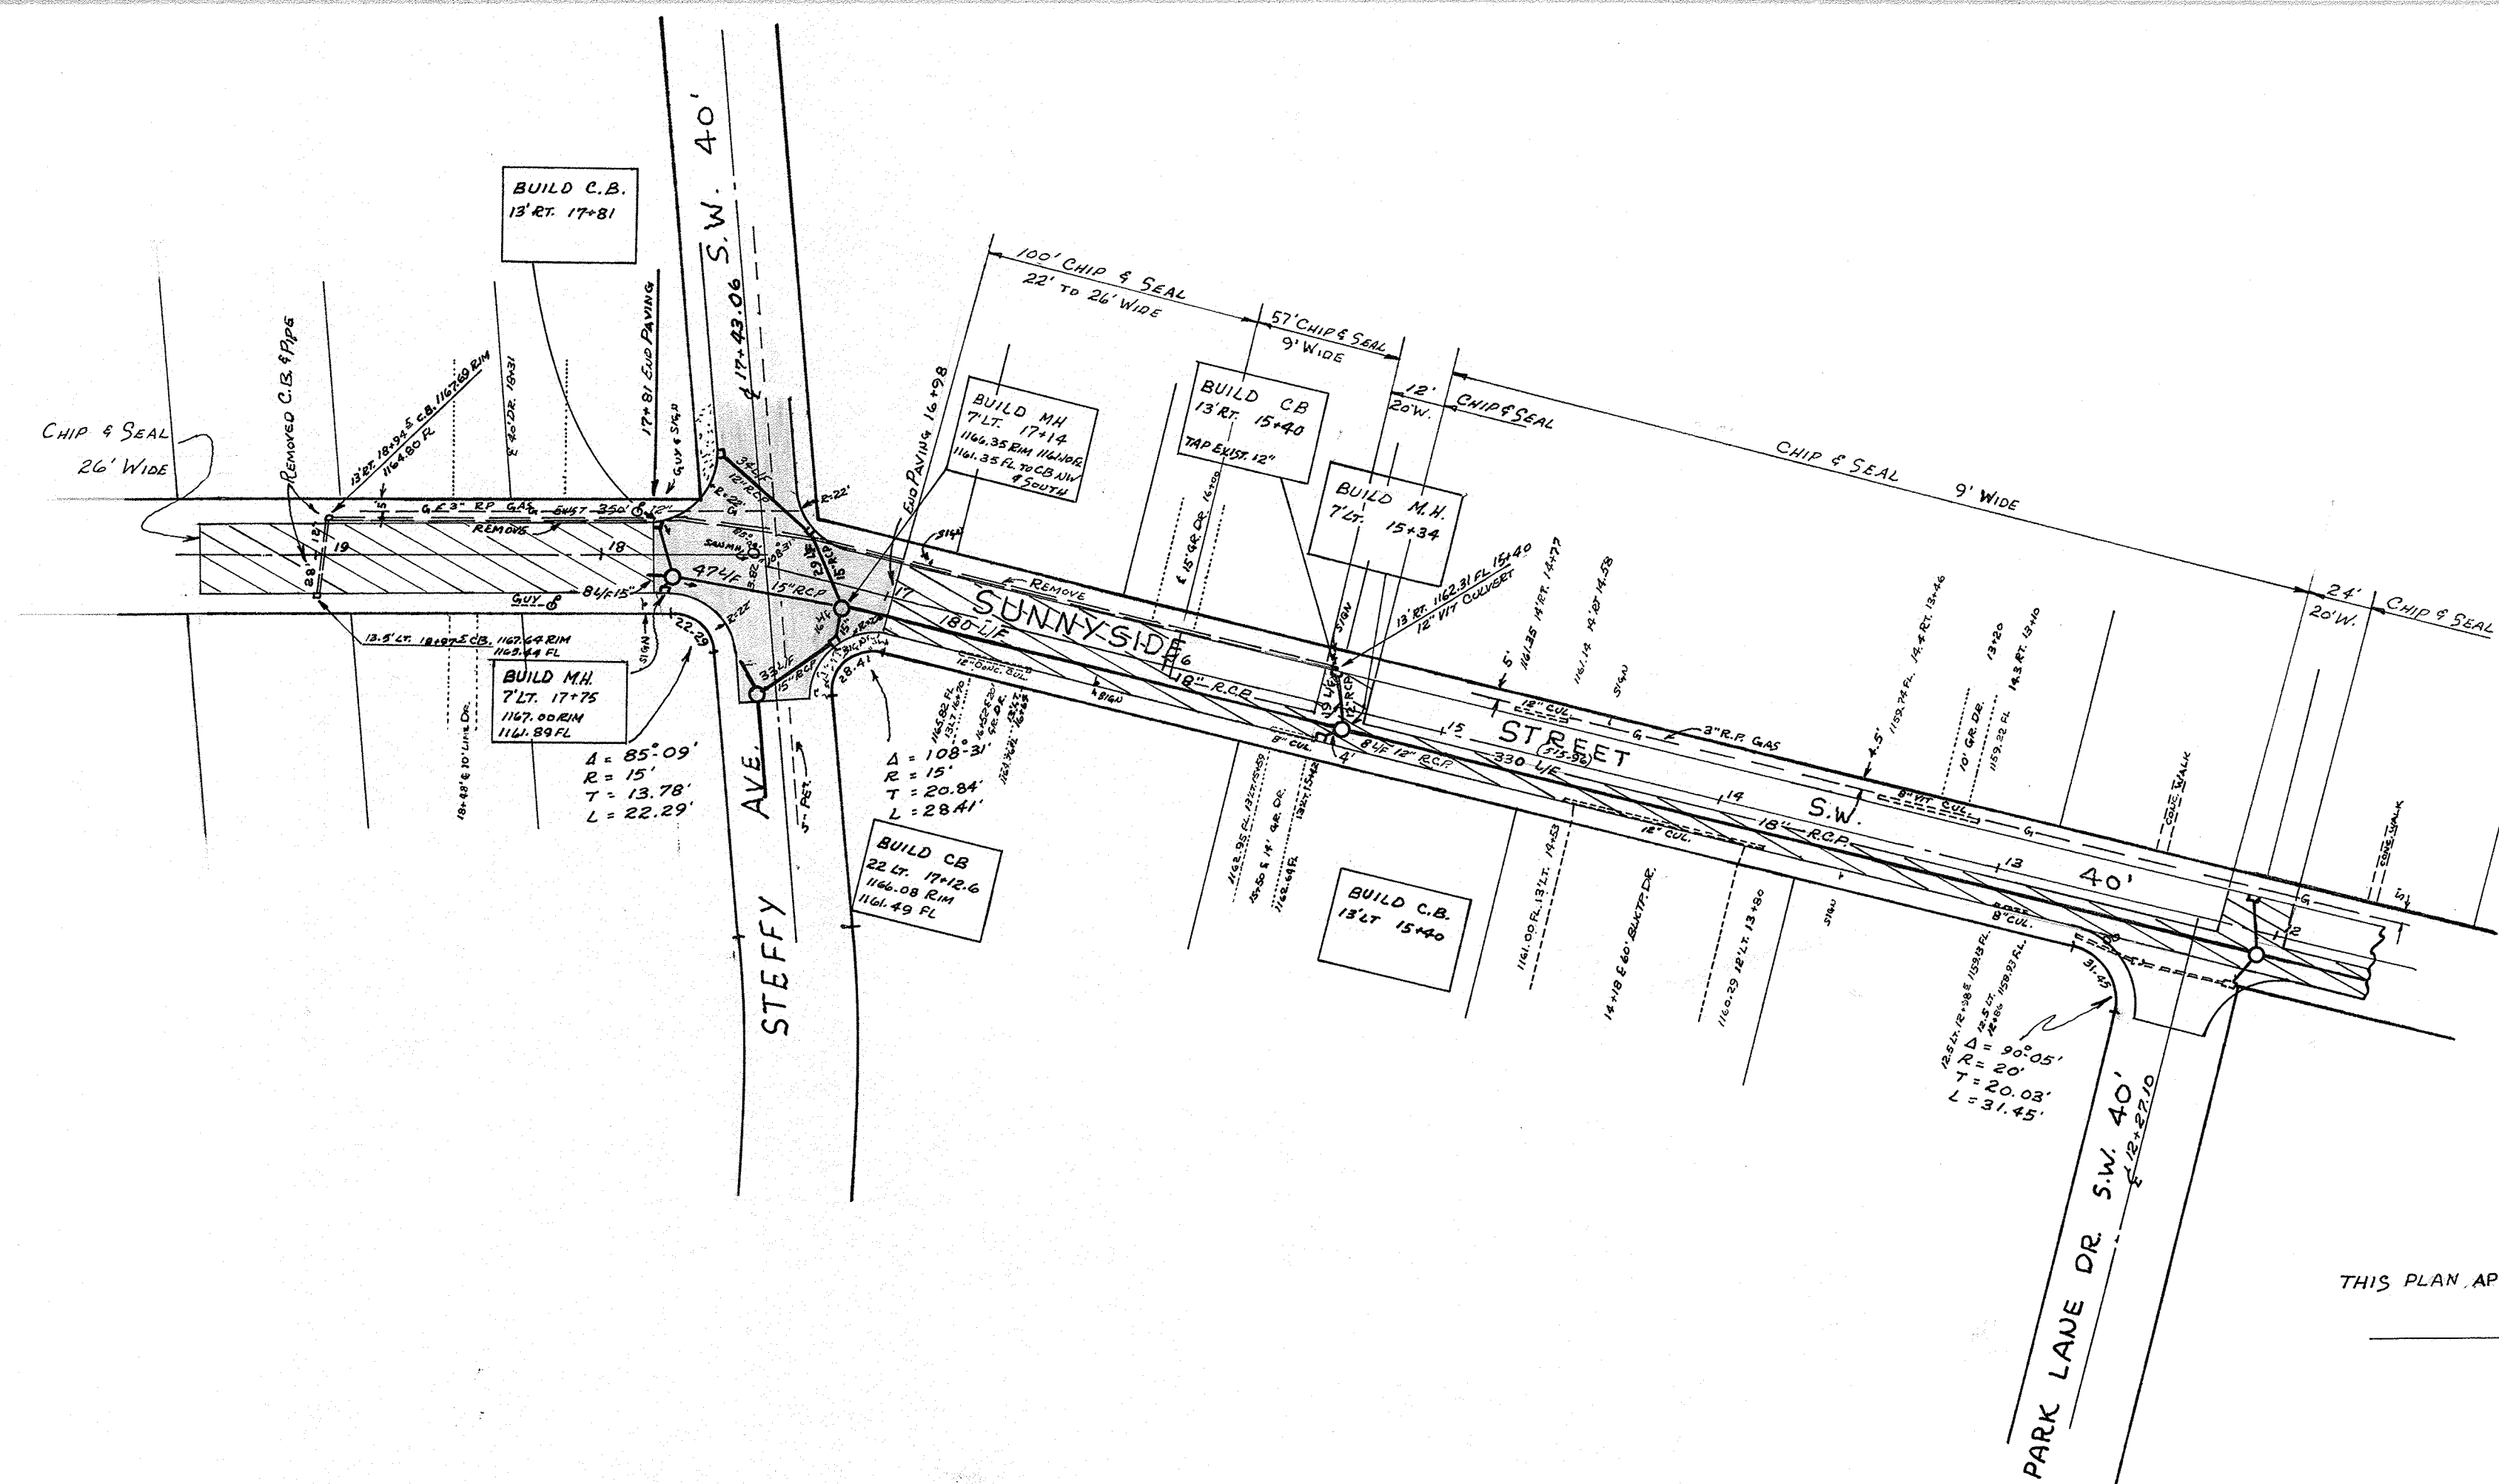


THIS PLAN APPROVED AND ACCEPTED BY THE STARK COUNTY ENGINEER

SIGNED

DATE:

NOTE: DRAWING SHOWS PROJECT AS CONSTRUCTED
PROJECT COMPLETED OCTOBER, 1973

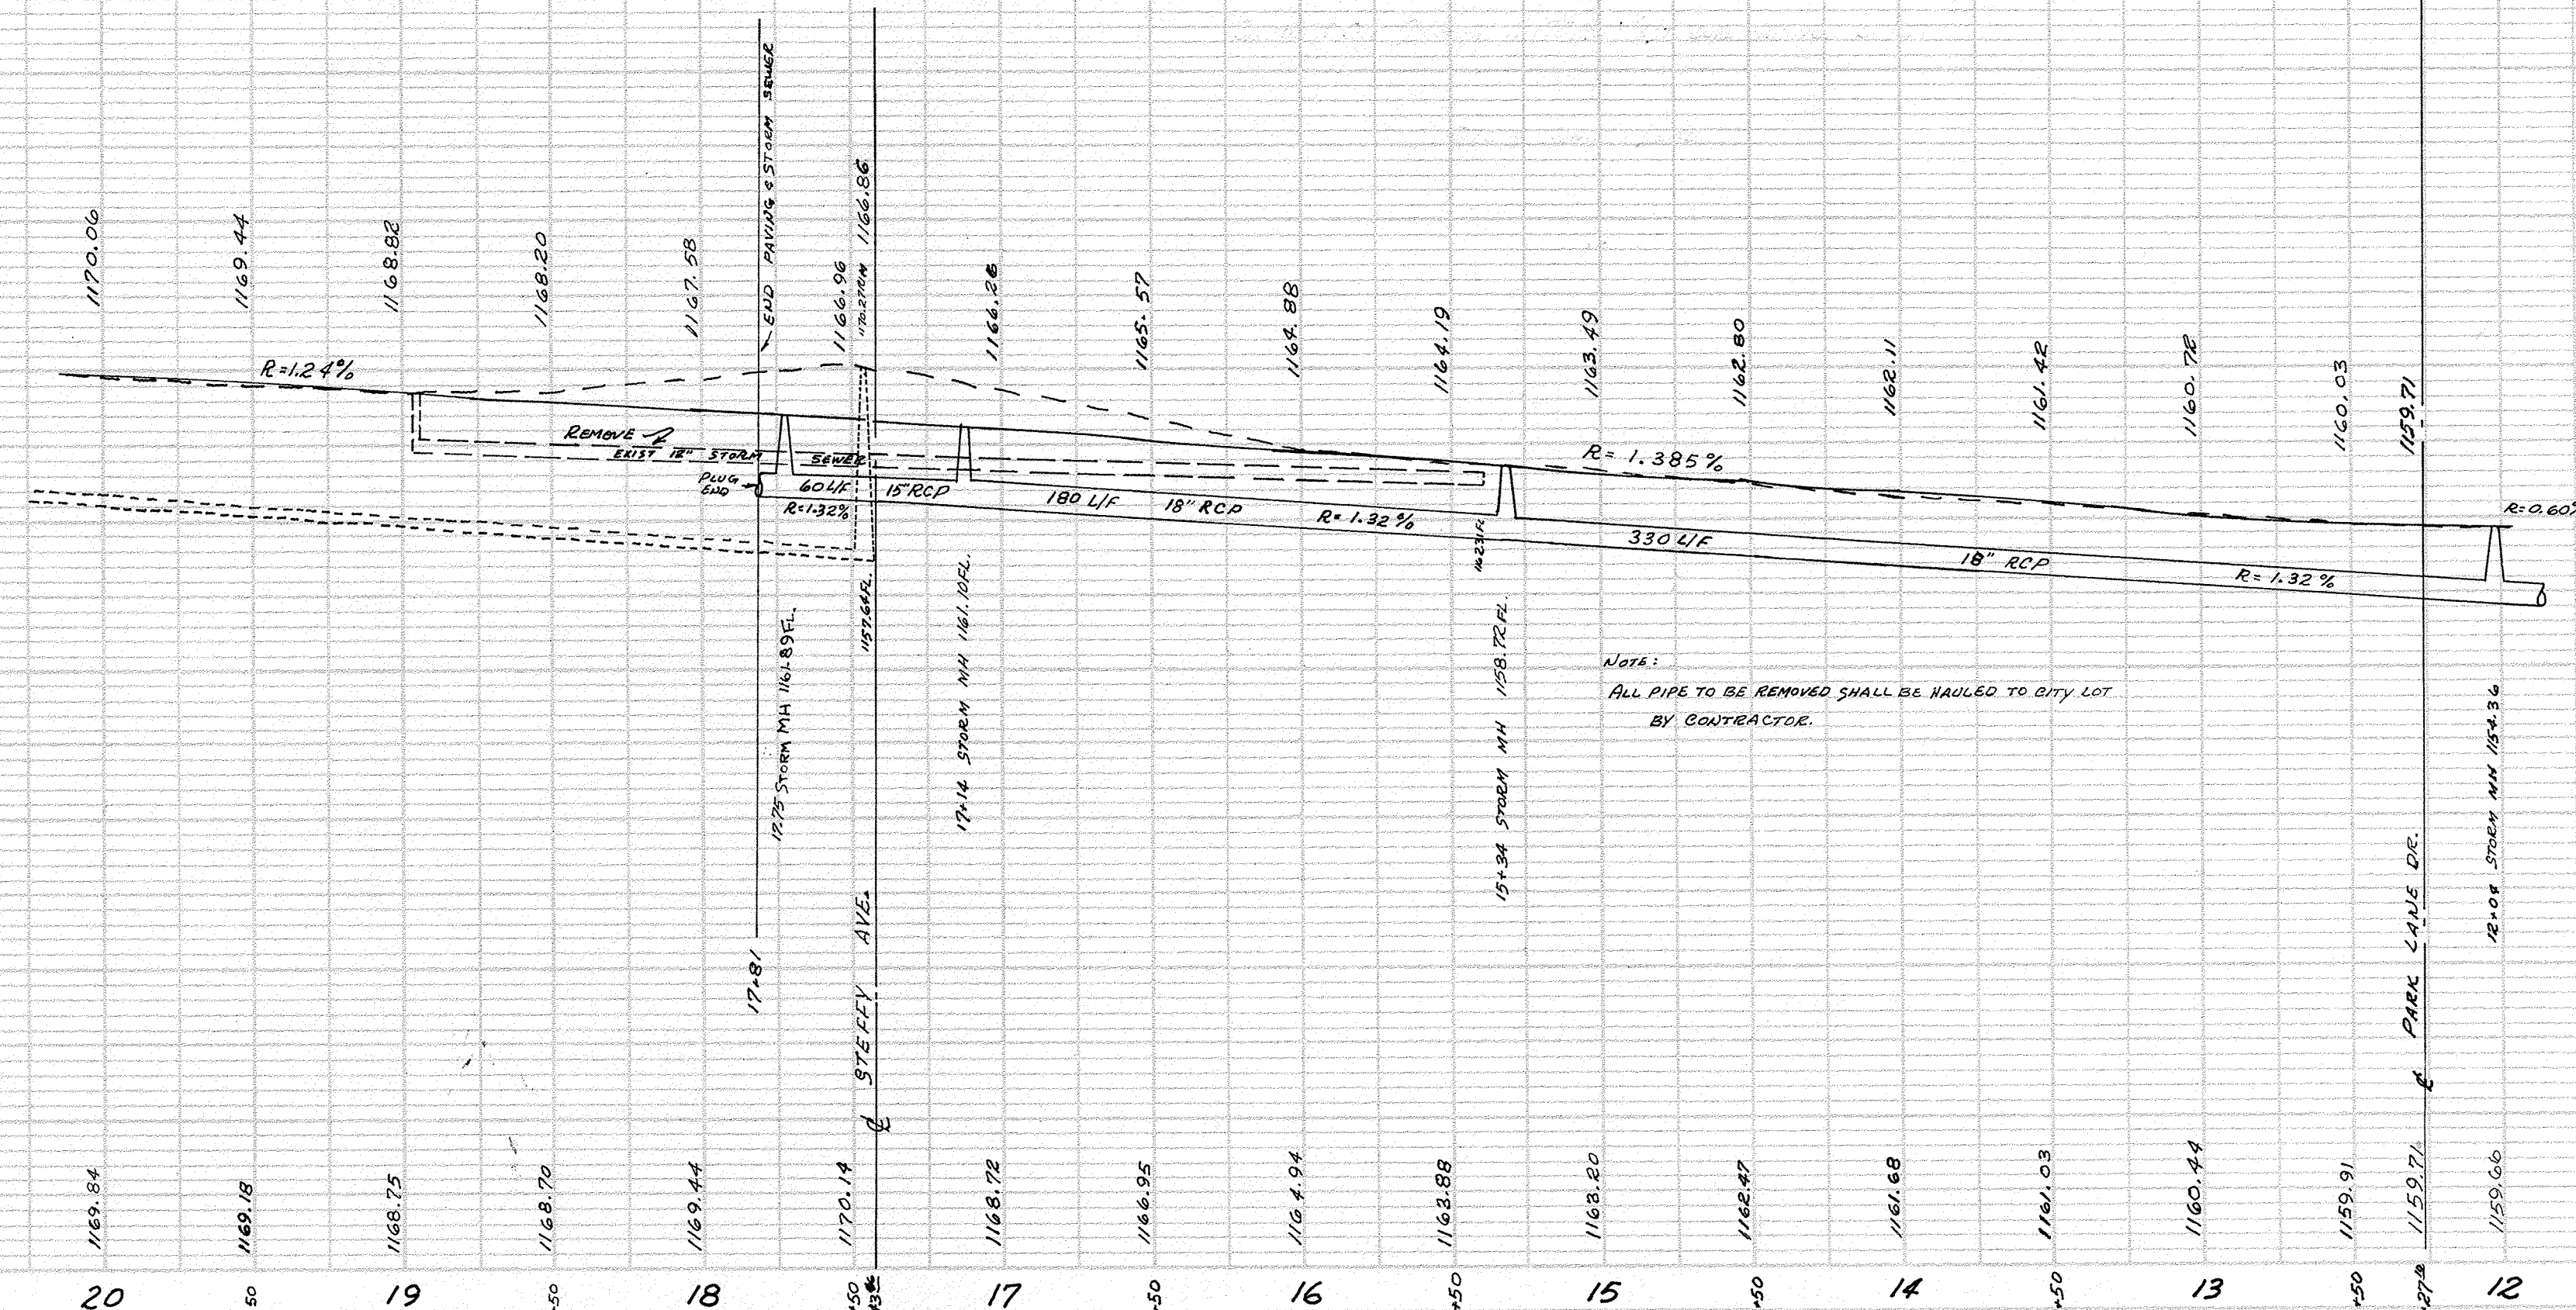

1180

1170

1160

PLAN & PROFILE
SUNNYSIDE STREET S.W.
VILLAGE OF HARTVILLE, OHIO
L.W.J. COOPER & ASSOCIATES
ENGINEERS & SURVEYORS
J.L. COOPER J.E.D. JUENEMANN JR. R.A. MILLER W.J. MEOLA
SCALE HOR. 1"=50'
VER. 1"=10' JULY, 1971

