

ADDENDUM #2

PROJECT #: 43188
PROJECT TITLE: Franklin 6th Street Resurfacing
CLIENT: City of Franklin, Ohio
Issue Date: August 7, 2026

This is to certify that you are in receipt of Addendum #2 for the above mentioned project.

Please sign and return via email to:

_____	_____	_____
Name/Title	Company	Date

Signature		

This Addendum forms a part of the contract documents and modifies the original bidding documents dated July 2026 and all previous addenda, if any. Acknowledge receipt of this addendum in the space provided in the bid forms. Failure to do so may subject the bidder to disqualification.

CLARIFICATION & QUESTIONS

- 1) During the preconstruction meeting, it was incorrectly stated that no pavers would be installed adjacent to the building at 550 S. Main Street. The sidewalk shall follow the pattern shown in the contract documents. An example of the proposed pattern can be seen along 4th Street, which was constructed as part of the previous streetscape project.
- 2) Item 301 is incidental to the pavement repair item 253 and the pavement repair item is now only included with Alt 1.
- 3) Item 301 is also incidental in the item 448 Full Depth Alley Pavement.
- 4) In alternate 2, item 301 is a stand-alone pay item for the full depth pavement on 6th Street.
- 5) Q: Will a lighting foundation template be provided?
A: No template to be provided. Contractor may create own template if needed based on Plinth Details in Decorative Lighting Foundation.

UPDATES TO PROPOSAL SHEETS

Attached are the three revised proposal sheets with item changes per Clarifications above.

UPDATES TO THE PLANS

The plans have been updated to reflect questions and clarifications discussed during the pre-proposal meeting. All changes are identified by a RevCloud. See attached plans.



6TH STREET IMPROVEMENTS 2026

CITY OF FRANKLIN, OHIO

PROJECT: 3/29/2018

DATE: 7/16/2026

Item No.	Spec. No.	Item	Estimated Quantity	Unit of Measure	Unit Cost	Total Item Cost
6TH STREET IMPROVEMENTS BASE BID						
1	202	CURB REMOVED	524	LF		
2	202	CONCRETE REMOVED	2710	SF		
3	202	GRAVEL REMOVED	1450	SF		
4	202	FULL DEPTH PAVEMENT REMOVAL, AS PER PLAN	500	SY		
5	204	SUBGRADE STABILIZATION WITH GEOGRID (PER DETAIL)*	10	SY		
6	252	SAWCUT PAVEMENT	525	LF		
7	448	FULL DEPTH ALLEY PAVEMENT (PER DETAIL)	540	SY		
8	452	CONCRETE DRIVE PAVEMENT	70	SY		
9	605	6" RIGID PVC PERFORATED UNDERDRAIN	515	LF		
10	SPL	SIDEWALK WITH PAVERBAND	1800	SF		
11	609	CURB, TYPE 6	135	LF		
12	609	CURB, TYPE 4 CURB AND GUTTER MODIFIED	158	LF		
13	609	CURB, TYPE 4 DEPRESSED	95	LF		
14	609	CURB, TYPE 4	215	LF		
15	609	CURB, TYPE 4 SHORT	15	LF		
16	609	CURB, TYPE 4 SHORT DEPRESSED	12	LF		
17	609	CURB, TYPE 2 CURB AND GUTTER MODIFIED	25	LF		
18	611	ADJUST MANHOLE TO GRADE*	12	EA		
19	611	NYLOPLAST 18" DRAIN BASIN	1	EA		
20	611	12" ODOT TYPE B CONDUIT	28	LF		
21	614	MAINTAINING TRAFFIC	1	LS		
22	623	CONSTRUCTION LAYOUT STAKES	1	LS		
23	624	MOBILIZATION	1	LS		
24	625	1.5" CONDUIT	250	LF		
25	625	4" CONDUIT	385	LF		
26	625	PULL BOX	6	EA		

**6TH STREET IMPROVEMENTS 2026**

CITY OF FRANKLIN, OHIO

PROJECT: 3/29/2018

DATE: 7/16/2026

Item No.	Spec. No.	Item	Estimated Quantity	Unit of Measure	Unit Cost	Total Item Cost
27	625	DECORATIVE LIGHTING FOUNDATION	4	EA		
28	630	REMOVE AND SALVAGE SIGNAGE	2	EA		
29	638	ADJUST METER TO GRADE*	1	EA		
30	638	ADJUST VALVE TO GRADE*	11	EA		
31	644	CROSSWALK LINES, WHITE	195	LF		
32	644	24" STOP BAR, WHITE	44	LF		
33	644	8" CHANNELIZING LINE, WHITE	215	LF		
34	644	PAVEMENT MARKING (ARROW), WHITE	6	EA		
35	644	DOUBLE CENTERLINE, YELLOW	362	LF		
36	659	SEEDING AND MULCHING	1200	SF		
NOTE: BID ITEMS WITH (*) SHALL BE A CONTINGENCY ITEMS USED AS DIRECTED BY THE CITY ENGINEER						
BASE BID TOTAL						
Item No.	Spec. No.	Item	Estimated Quantity	Unit of Measure	Unit Cost	Total Item Cost
BID ALTERNATE 1 - 6TH STREET RESURFACING						
1	202	PAVEMENT PLANING (VARIABLE DEPTH)	2025	SY		
2	204	SUBGRADE STABILIZATION WITH GEOGRID (PER DETAIL)*	20	SY		
3	253	PAVEMENT REPAIR (PER DETAIL)	250	SY		
4	407	ROADWAY TACK COAT	202	GAL		
5	441	ASPHALT CONCRETE SURFACE COURSE, TYPE 1, (448), PG64-22 (1")	175	CY		
6	441	ASPHALT CONCRETE INTERMEDIATE COURSE, TYPE 1, (448), PG64-22 (1-1/2")	275	CY		
NOTE: BID ITEMS WITH (*) SHALL BE A CONTINGENCY ITEMS USED AS DIRECTED BY THE CITY ENGINEER						
BID ALT 1 TOTAL						


**6TH STREET IMPROVEMENTS 2026****CITY OF FRANKLIN, OHIO**

PROJECT: 3/29/2018

DATE: 7/16/2026

Item No.	Spec. No.	Item	Estimated Quantity	Unit of Measure	Unit Cost	Total Item Cost
Item No.	Spec. No.	Item	Estimated Quantity	Unit of Measure	Unit Cost	Total Item Cost
BID ALTERNATE 2 - 6TH STREET FULL DEPTH REPLACEMENT						
1	202	FULL DEPTH PAVEMENT REMOVAL	2021	SY		
2	204	SUBGRADE STABILIZATION*	2021	SY		
3	252	SAWCUT PAVEMENT	152	LF		
4	301	8" ASPHALT BASE (2"-4" LIFTS)	445	CY		
5	304	8" AGGREGATE BASE	445	CY		
6	407	ROADWAY TACK COAT	202	GAL		
7	441	ASPHALT CONCRETE SURFACE COURSE, TYPE 1, (448), PG64-22 (1-1/2")	100	CY		
8	441	ASPHALT CONCRETE INTERMEDIATE COURSE, TYPE 1, (448), PG64-22 (2")	125	CY		
NOTE: BID ITEMS WITH (*) SHALL BE A CONTINGENCY ITEMS USED AS DIRECTED BY THE CITY ENGINEER						
BID ALT 2 TOTAL						

CITY OF FRANKLIN
WARREN COUNTY, OHIO
EAST SIXTH STREET IMPROVEMENT PROJECT
43188

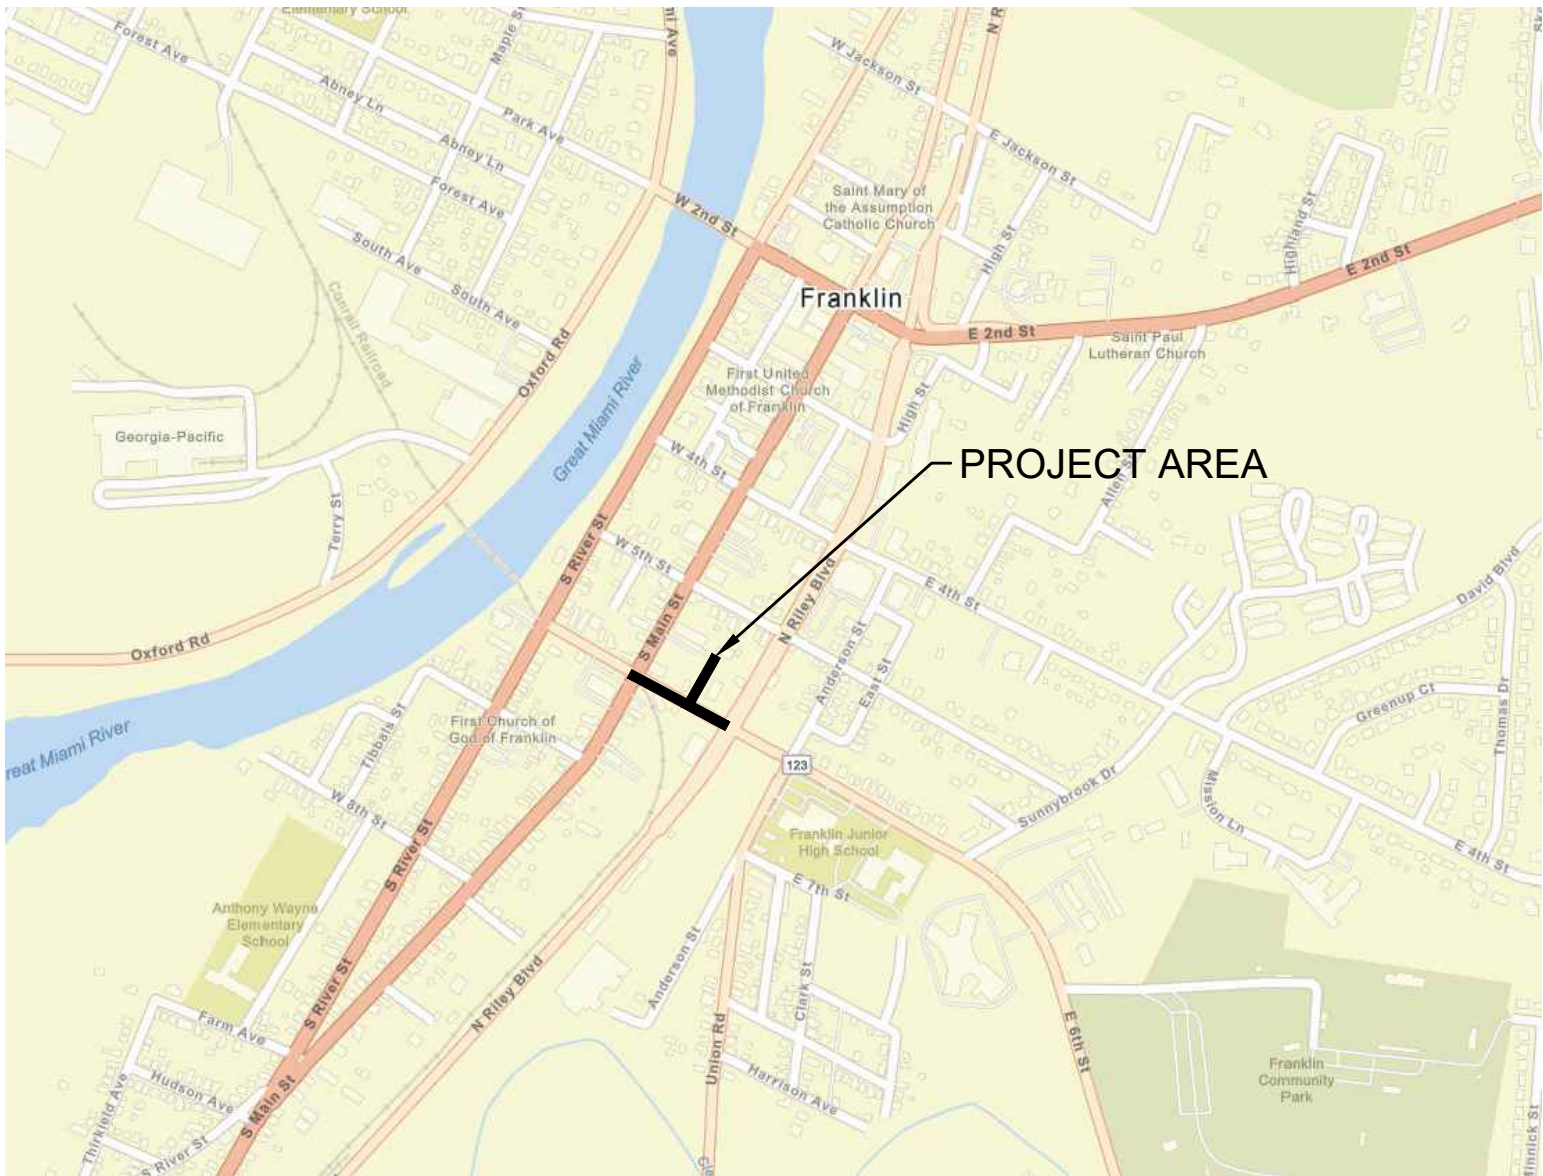

VICINITY MAP

PROJECT SPECIFICATIONS

IN GENERAL, THE PROJECT SPECIFICATIONS CONFORM TO THE JANUARY 1, 2023 STANDARD SPECIFICATIONS OF THE STATE OF OHIO, DEPARTMENT OF TRANSPORTATION, INCLUDING CHANGES AND SUPPLEMENTAL SPECIFICATIONS THERETO. THE PROJECT SPECIFICATIONS, UNDER SEPERATE COVER, PREPARED BY VERDANTAS SHALL GOVERN ALL WORK AND MATERIALS FOR THIS PROJECT.

MORK J LACHNIET, PE

PE #71746

UNDERGROUND UTILITIES

Contact Two Working Days
Before You Dig


Before You Dig

OHIO811, 8-1-1, or 1-800-362-2764
(Non members must be called directly)

SHEET LIST TABLE	
NO.	SHEET TITLE
1	TITLE
2	GENERAL NOTES
3	GENERAL NOTES CONT.
4	DETAILS
5	EXISTING CONDITIONS AND DEMO PLAN - OVERALL
6	LAYOUT PLAN - OVERALL
7	UTILITY PLAN - OVERALL
8	GRADING PLAN - OVERALL
9	STRIPING PLAN OVERALL

ODOT SCD REFERENCES		
DM-1.2	PIPE UNDERDRAINS	7/16/2021
HL-30.11	PULL BOX DETAIL	1/15/2021
BP-5.1	CONCRETE CURBS AND COMBINED CURB & GUTTER	7/15/2022
HL-20.11	MISC. LIGHT POLE FOUNDATIONS & TRENCH DETAILS	10/21/2022
HL-30.22	ROADWAY CONDUIT DETAILS II	1/15/2021
TC-71.10	WORD AND SYMBOL PAVEMENT MARKINGS	4/21/2023

verdantas

PROJECT NO.
43188

DISCIPLINE
CIVIL

SHEET NAME
TTL

SHEET
1

OF
9

EAST 6TH STREET IMPROVEMENT PROJECT
CITY OF FRANKLIN
WARREN COUNTY, OHIO

TITLE

NO

DATE

REVISION

PER ADDENDUM #2

ISSUE DATE:
05/28/2026

SCALE:
AS SHOWN

DESIGNED BY:
JHOO

DRAWN BY:
AJAC

CHECKED BY:
MLAC

PAY ITEMS

EXCAVATION AND EMBANKMENT TO ESTABLISH SUBGRADE, SUBGRADE STABILIZATION AND PROOF ROLLING OF SUBGRADE OUTSIDE OF THE ASPHALT PAVING AND OVERLAY SHALL ALL BE INCIDENTAL TO THE BID ITEMS. SUBSEQUENT HAUL OFF OR IMPORTING OF MATERIAL SHALL ALSO BE INCIDENTAL TO THE BID ITEMS.

THIS ITEM SHALL CONSIST OF OVER EXCAVATING POOR SOILS AND BACKFILLING THE AREAS WITH A COMBINATION OF STONE, GEORGRID MATERIAL AND ASPHALT PER THE DETAILS INDICATED IN THESE PLANS. DURING THE PROOF-ROLL TEST OF THE SUBGRADE THE ENGINEER SHALL MARK AREAS IN THE FIELD WHERE OBSERVED DEFLECTIONS EXCEED 0.5" OR CAUSE SUBSTANTIAL RUTTING OF THE SUBGRADE. THESE MARKINGS WILL BE FIELD MEASURED AND AGREED UPON PRIOR TO PERFORMING THE WORK. THE UNIT PRICE SHALL INCLUDE EXCAVATION AND REMOVAL OF POOR SOILS, BACKFILLING WITH 304 STONE AND COMPACTION OF SUCH ITEMS AND ITEM 301 PER THE DETAIL.

THIS ITEM SHALL CONSIST OF OVER EXCAVATING POOR SOILS AND BACKFILLING THE AREAS WITH A COMBINATION OF STONE MATERIAL AND ASPHALT. DURING THE PROOF-ROLL TEST OF THE SUBGRADE THE ENGINEER SHALL MARK AREAS IN THE FIELD WHERE OBSERVED DEFLECTIONS EXCEED 0.5" OR CAUSE RUTTING OF THE SUBGRADE. THESE MARKINGS WILL BE FIELD MEASURED AND AGREED UPON PRIOR TO PERFORMING THE WORK. THE UNIT PRICE SHALL INCLUDE EXCAVATION AND REMOVAL OF POOR SOILS, BACKFILLING WITH 304 STONE AND COMPACTION OF SUCH ITEMS AND 8" OF ITEM 301 APPLIED IN 2 EQUAL LIFTS OF 4".

THIS ITEM SHALL CONSIST OF OVER EXCAVATING POOR SOILS AND BACKFILLING THE AREAS WITH A COMBINATION OF STONE, GEORGID MATERIAL AND ASPHALT PER THE DETAILS INDICATED IN THESE PLANS. DURING THE PROOF-ROLL TEST OF THE SUBGRADE THE ENGINEER SHALL MARK AREAS IN THE FIELD WHERE OBSERVED DEFLECTIONS EXCEED 0.5" OR CAUSE SUBSTANTIAL RUTTING OF THE SUBGRADE. THESE MARKINGS WILL BE FIELD MEASURED AND AGREED UPON PRIOR TO PERFORMING THE WORK. THE UNIT PRICE SHALL INCLUDE EXCAVATION AND REMOVAL OF POOR SOILS, BACKFILLING WITH 304 STONE AND COMPACTION OF SUCH ITEMS AND ITEM 301 PER THE DETAIL.

THIS ITEM SHALL CONSIST OF PAVEMENT REMOVAL AND OVER EXCAVATION OF SUBGRADE AND BACKFILLING THE AREAS WITH A COMBINATION OF STONE AND ASPHALT MATERIAL PER THE DETAILS INDICATED IN THESE PLANS. AFTER THE PAVEMENT IS MILLED AND DURING THE PROOF-ROLL TEST OF THE PAVEMENT THE ENGINEER SHALL MARK AREAS IN THE FIELD WHERE OBSERVED DEFLECTIONS EXCEED 0.5" OR CAUSE CRACKING OR PUMPING OF THE ASPHALT. THESE MARKINGS WILL BE FIELD MEASURED AND AGREED UPON PRIOR TO PERFORMING THE WORK. THE UNIT PRICE SHALL INCLUDE EXCAVATION AND REMOVAL OF POOR SLOIS, BACKFILLING AND COMPACTION OF STONE AND ITEM 301.

THIS ITEM SHALL CONSIST OF INSTALLING A DRIVEWAY APRON PER THE PROVIDED DETAILS. THE CONTRACTOR SHALL EXCAVATE THE AREA TO SUBGRADE THEN POUR A CONTINUOUS CURB AND GUTTER AT THE DRIVEWAY SECTION. WHEN THE DRIVEWAY CURB AND GUTTER IS COMPLETE, THE CONTRACTOR SHALL PROCEED TO THE DRIVEWAY SECTION. ONCE THE CURB AND GUTTER IS HARD ENOUGH TO CONTINUE CONSTRUCTION, CONTRACTOR SHALL HAND FORM THE TRANSITION PIECE FROM THE BACK OF CURB THROUGH THE PAVEMENT BAND AND TRANSITION THE EXPOSED HEIGHT OF THE CURB FROM THE TYPICAL TO FLUSH HEIGHT AT THE BACK OF THE PAVERS. ONCE THE TRANSITION PIECE HAS SUFFICIENTLY HARDENED THE REMAINDER OF THE CONCRETE BETWEEN THE DRIVEWAY AND DRIVEWAY APRON SHALL BE CAST. THE DRIVEWAY APRON SHALL BE CAST ON THE DRIVEWAY PAVEMENT SHALL BE PROVIDED BETWEEN THE DRIVEWAY AND THE CONCRETE PAVEMENT. THE UNIT SHALL INCLUDE EXCAVATION, COMPACTION, FORM WORK AND CONSTRUCTION JOINTING PER THE DETAIL.

THIS ITEM SHALL CONSIST OF HAND FORMING AND POUR SECTION OF CURB BETWEEN DIFFERENT TYPES OF CURB AND GUTTER SECTIONS AS INDICATED ON THE PLANS. THE CONTRACTOR SHALL FORM OUT THE TRANSITION SECTIONS OF CURB FROM ONE TYPE OF CURB, THROUGH ANY RADIUS TO ANOTHER TYPE OF CURB USING A UNIFORM SLOPE BETWEEN THE TWO POINTS AS INDICATED BY THE GRADING PLAN. CONCRETE WILL THEN BE POURED INTO THE FORMWORK USING AN APPROVED CONCRETE MIX DESIGN. CONTRACTOR SHALL HAND SMOOTH AND SHAPE THE CONCRETE TO PROVIDE A UNIFORM TRANSITION BETWEEN THE TWO CURB TYPES. THE UNIT PRICE SHALL INCLUDE EXCAVATION TO ESTABLISH SUBGRADE, FORMWORK, AND CONCRETE WORK.

THIS ITEM SHALL CONSIST OF CONSTRUCTING A SIDEWALK WITH PAVER BANS ALONG THE BACK OF CURB AND INSTALLING ON THE PLANS. CONTRACTOR SHALL EXCAVATE THE AREA TO SUBGRADE AND CONSTRUCT THE CURB AND SIDEWALK. AFTER THIS ITEM SINCE THIS ITEM WILL BE PLACED ON TOP OF THE CURB, AFTER ESTABLISHING SUBGRADE, CONTRACTOR SHALL PLACE 3" OF COMPACTED SAND. CONTRACTOR SHALL CONSTRUCT A CONCRETE SIDEWALK. AFTER THE CONCRETE SIDEWALK IS SOLID AND HAS CURED FOR A MINIMUM OF 3 DAYS, CONTRACTOR SHALL PLACE BITUMINOUS SETTING BED, TACK COAT AND PAVERS. PAVERS SHALL BE INSTALLED PER THE PATTERNS AND COLORS INDICATED ON THE LANDSCAPING PLANS AND SPECIFICATIONS. CONTRACTOR SHALL PLACE 1" OF SAND OVER THE PAVERS. THE SPECIFICATIONS UNIT PRICE SHALL INCLUDE EXCAVATION TO ESTABLISH SUBGRADE, SUBGRADE COMPACT, SIDEWALK, BITUMINOUS SETTING BED, TACK COAT, PAVERS, PAVES EDGING AND INFILL SAND.

THIS ITEM SHALL CONSIST OF CONSTRUCTING THE TYPICAL ROADWAY SECTION AS INDICATED ON THE PLAN BY MEANS OF PLANNING THE EXISTING ASPHALT TO THE PROPOSED SUBGRADE AND PLACING ASPHALTING CONCRETE PAVEMENT ON TOP OF THE MILLED ASPHALT. UNIT PRICE FOR ASPHALT PAVEMENT PLANNING AND OVERLAY SHALL INCLUDE PAVEMENT PLANNING, NON-TRACKING TACK COAT, AND PLACING AND COMPACTING ASPHALTING CONCRETE.

THIS ITEM SHALL CONSIST OF CONSTRUCTING THE TYPICAL ROADWAY SECTION AS INDICATED ON THE PLAN
UNIT PRICE FOR THIS ITEM SHALL INCLUDE ESTABLISH SUBGRADE, SUBGRADE COMPACTION, ASPHALT BASE
INTERMEDIATE COURSE, SURFACE COURSE, NON-TRACKING TACK COAT, AND PROOF ROLLING

THIS ITEM SHALL CONSIST OF CONSTRUCTING THE TYPICAL ROADWAY SECTION AS INDICATED ON THE PLAN
UNIT PRICE FOR THIS ITEM SHALL INCLUDE ESTABLISH SUBGRADE, SUBGRADE COMPACTION, ASPHALT BASE
SURFACE COURSE, NON-TRACKING TACK COAT, AND PROOF ROLLING

ALL UNPAVED AREAS DISTURBED BY THE CONTRACTORS ACTIVITIES SHALL BE SEEDED AND MULCHED IN ACCORDANCE WITH THE PROJECT SPECIFICATIONS. COMMERCIAL FERTILIZER SHALL BE INCLUDED IN THE UNIT BID PRICE FOR ITEM 659 SEEDING AND MULCHING, CLASS 1, AS PER PLAN.

THIS ITEM SHALL CONSIST OF INSTALLING A PERFORATED UNDERDRAIN PIPE WITH GRANULAR BACKFILL AND FILTER FABRIC BENEATH THE CURB LINE. THE CONTRACTOR SHALL EXCAVATE AND ESTABLISH SUBGRADE FOR BOTTOM OF THE UNDERDRAIN, PLACE A SEPARATION GEOTEXTILE PER ITEM 712.09 A ON THE BOTTOM AND SIDES OF THE EXCAVATION, BED THE PIPE WITH ITEM 703.11 TYPE 2 OR 3, BEND THE PIPE, BACKFILL AROUND THE PIPE WITH ITEM 703.11 TYPE 2 OR 3 AND WRAP THE GEOTEXTILE OVER TOP OF THE STONE. THE PIPE ENDS WILL BE CONNECTED INTO THE SIDE OF THE CATCH BASIN WHENEVER THEY ARE ENCOUNTERED. THE UNIT PRICE SHALL INCLUDE EXCAVATION, GEOTEXTILE, PIPE, CONNECTION TO CATCH BASINS AND BACKFILL OF THE ITEM.

THIS ITEM SHALL CONSIST OF ADJUSTING THE TOPS OF EXISTING VALVE BOXES, MANHOLES AND METER PIT TO GRADE. MULTI-PIECE GRAY IRON VALVE BOXES SHALL BE CHIPPED OUT AND ROTATED TO ADJUST THE TOP OF THE BOX TO BE WITHIN 1/4" OF FINAL GRADE. MANHOLES SHALL HAVE THEIR TOP CASTING REMOVED AND REPLACED WITH NEW CASTING. HEIGHT ADJUSTMENTS SHALL BE DONE WITH PRECAST CONCRETE GRADE RINGS TO BE WITHIN 1/4" OF FINAL GRADE. METER BOXES THAT ARE TO BE ADJUSTED TO GRADE SHALL BE EXCAVATED AROUND AND HAVE PRE-CAST CEMENT BLOCKS PLACED UNDER THE METER BOX TO ADJUST TO THE NEW GRADE. METER BOXES SHALL BE WITHIN 1/4" OF FINAL GRADE. THE UNIT PRICE SHALL INCLUDE EXCAVATION, ADJUSTMENTS, CASTINGS, GRADE RINGS OR BLOCKS AND BACKFILL OF VOID SPACES.


THIS ITEM SHALL CONSIST OF EXCAVATING AND BACKFILLING OF TRENCHES USED FOR UTILITY CONDUITS. CONTRACTOR SHALL EXCAVATE TO THE BOTTOM OF THE TRENCH TYPICAL SECTION TO ESTABLISH GRADE. AFTER GRADE IS ESTABLISHED AND CONDUITS ARE PLACED IN THE TRENCH, CONTRACTOR SHALL BACKFILL AROUND THE CONDUIT(S) WITH CONCRETE, SAND OR LOW STRENGTH MORTAR AS INDICATED IN THE TYPICAL SECTION. AFTER THE INITIAL BACKFILL AROUND THE CONDUITS CONTINUE TO BACKFILL THE TRENCH TO SUBGRADE WITH STRUCTURAL BACKFILL OR FLOWABLE FILL AS INDICATED BY THE TYPICAL SECTION. AFTER BACKFILL COVER THE TRENCH PER THE TYPICAL TRENCH REPAIR DETAIL. THE UNIT PRICE SHALL INCLUDE EXCAVATION, CONCRETE, SAND, LOW STRENGTH MORTAR, SURFACE RESTORATION AND MARKING TAPE.

ALL CHAIR RAILS, ELBOWS, COUPLINGS, TEES, PULL STRINGS, GLUE JOINTS, UPTURNS, INSPECTIONS, TEMPORARY CAPS AND MARKERS SHALL BE CONSIDERED INCIDENTAL TO THE COST OF THE CONDUIT BEING INSTALLED. THE CITY WILL BE PROVIDING 4,200 L.F. OF 10' LONG 6" SCH 40 PVC CONDUITS FOR INSTALLATION BY THE CONTRACTOR.

Item No.	Spec. No.	Item	Estimated Quantity	Unit of Measure
BID ALTERNATE 1 - 6TH STREET RESURFACING				
1	202	PAVEMENT PLANING (VARIABLE DEPTH)	2025	SY
2	204	SUBGRADE STABILIZATION WITH GEOGRID (PER DETAIL)*	20	SY
3	253	PAVEMENT REPAIR (PER DETAIL)	250	SY
4	407	ROADWAY TACK COAT	202	GAL
5	441	ASPHALT CONCRETE SURFACE COURSE, TYPE 1, (448), PG64-22 (1")	175	CY
6	441	ASPHALT CONCRETE INTERMEDIATE COURSE, TYPE 1, (448), PG64-22 (1-1/2")	275	CY

NOTE: BID ITEMS WITH (*) SHALL BE A CONTINGENCY ITEMS USED AS DIRECTED BY THE CITY ENGINEER

NOTE: BID ITEMS WITH (*) SHALL BE A CONTINGENCY ITEMS USED AS DIRECTED BY THE CITY ENGINEER








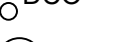
	EXISTING FLAGPOLE		PROPOSED FLAGPOLE
	EXISTING MAILBOX		PROPOSED MAILBOX
	EXISTING SIGN		PROPOSED SIGN
	EXISTING CABLE PEDESTAL		PROPOSED CABLE PEDESTAL
	EXISTING ELECTRIC PEDESTAL		PROPOSED ELECTRIC PEDESTAL
	EXISTING PULL BOX		PROPOSED PULL BOX
	EXISTING GROUND LIGHT		PROPOSED GROUND LIGHT
	EXISTING LIGHT POLE		PROPOSED LIGHT POLE
	EXISTING ELECTRIC METER		PROPOSED ELECTRIC METER
	EXISTING ELECTRIC MANHOLE		PROPOSED ELECTRIC MANHOLE
	EXISTING GAS METER		PROPOSED GAS METER
	EXISTING GAS VALVE		PROPOSED GAS VALVE
	EXISTING GAS BOX		PROPOSED GAS BOX
	EXISTING UTILITY POLE		PROPOSED UTILITY POLE
	EXISTING GUY WIRE / ANCHOR		PROPOSED GUY WIRE / ANCHOR
	EXISTING SANITARY MANHOLE		PROPOSED SANITARY MANHOLE
	EXISTING SANITARY CLEANOUT		PROPOSED SANITARY CLEANOUT
	EXISTING STORM MANHOLE		PROPOSED STORM MANHOLE
	EXISTING SINGLE / DOUBLE CURB INLET		PROPOSED SINGLE / DOUBLE CURB INLET
	EXISTING CATCH BASIN		PROPOSED CATCH BASIN
	EXISTING STORM CLEANOUT		PROPOSED STORM CLEANOUT
	EXISTING TELEPHONE MANHOLE		PROPOSED TELEPHONE MANHOLE
	EXISTING TELEPHONE PEDESTAL		PROPOSED TELEPHONE PEDESTAL
	EXISTING FIRE HYDRANT		PROPOSED FIRE HYDRANT
	EXISTING WATER METER		PROPOSED WATER METER
	EXISTING WATER MANHOLE		PROPOSED WATER VALVE
	EXISTING WATER VALVE		REMOVE EXISTING BUSH / TREE
	EXISTING BUSHES / TREES		PROPOSED SLOPE DIRECTION

ISSUE DATE:	05/29/2026
SCALE:	AS SHOWN
DESIGNED BY:	JHOO
DRAWN BY:	AJAC
CHECKED BY:	MLAC

EAST 6TH STREET IMPROVEMENT PROJECT
CITY OF FRANKLIN
WARREN COUNTY, OHIO


GENERAL NOTES CONT.

PROJECT NO.	
43188	
DISCIPLINE	
CIVIL	
SHEET NAME	
GEN2	
SHEET	OF
3	9

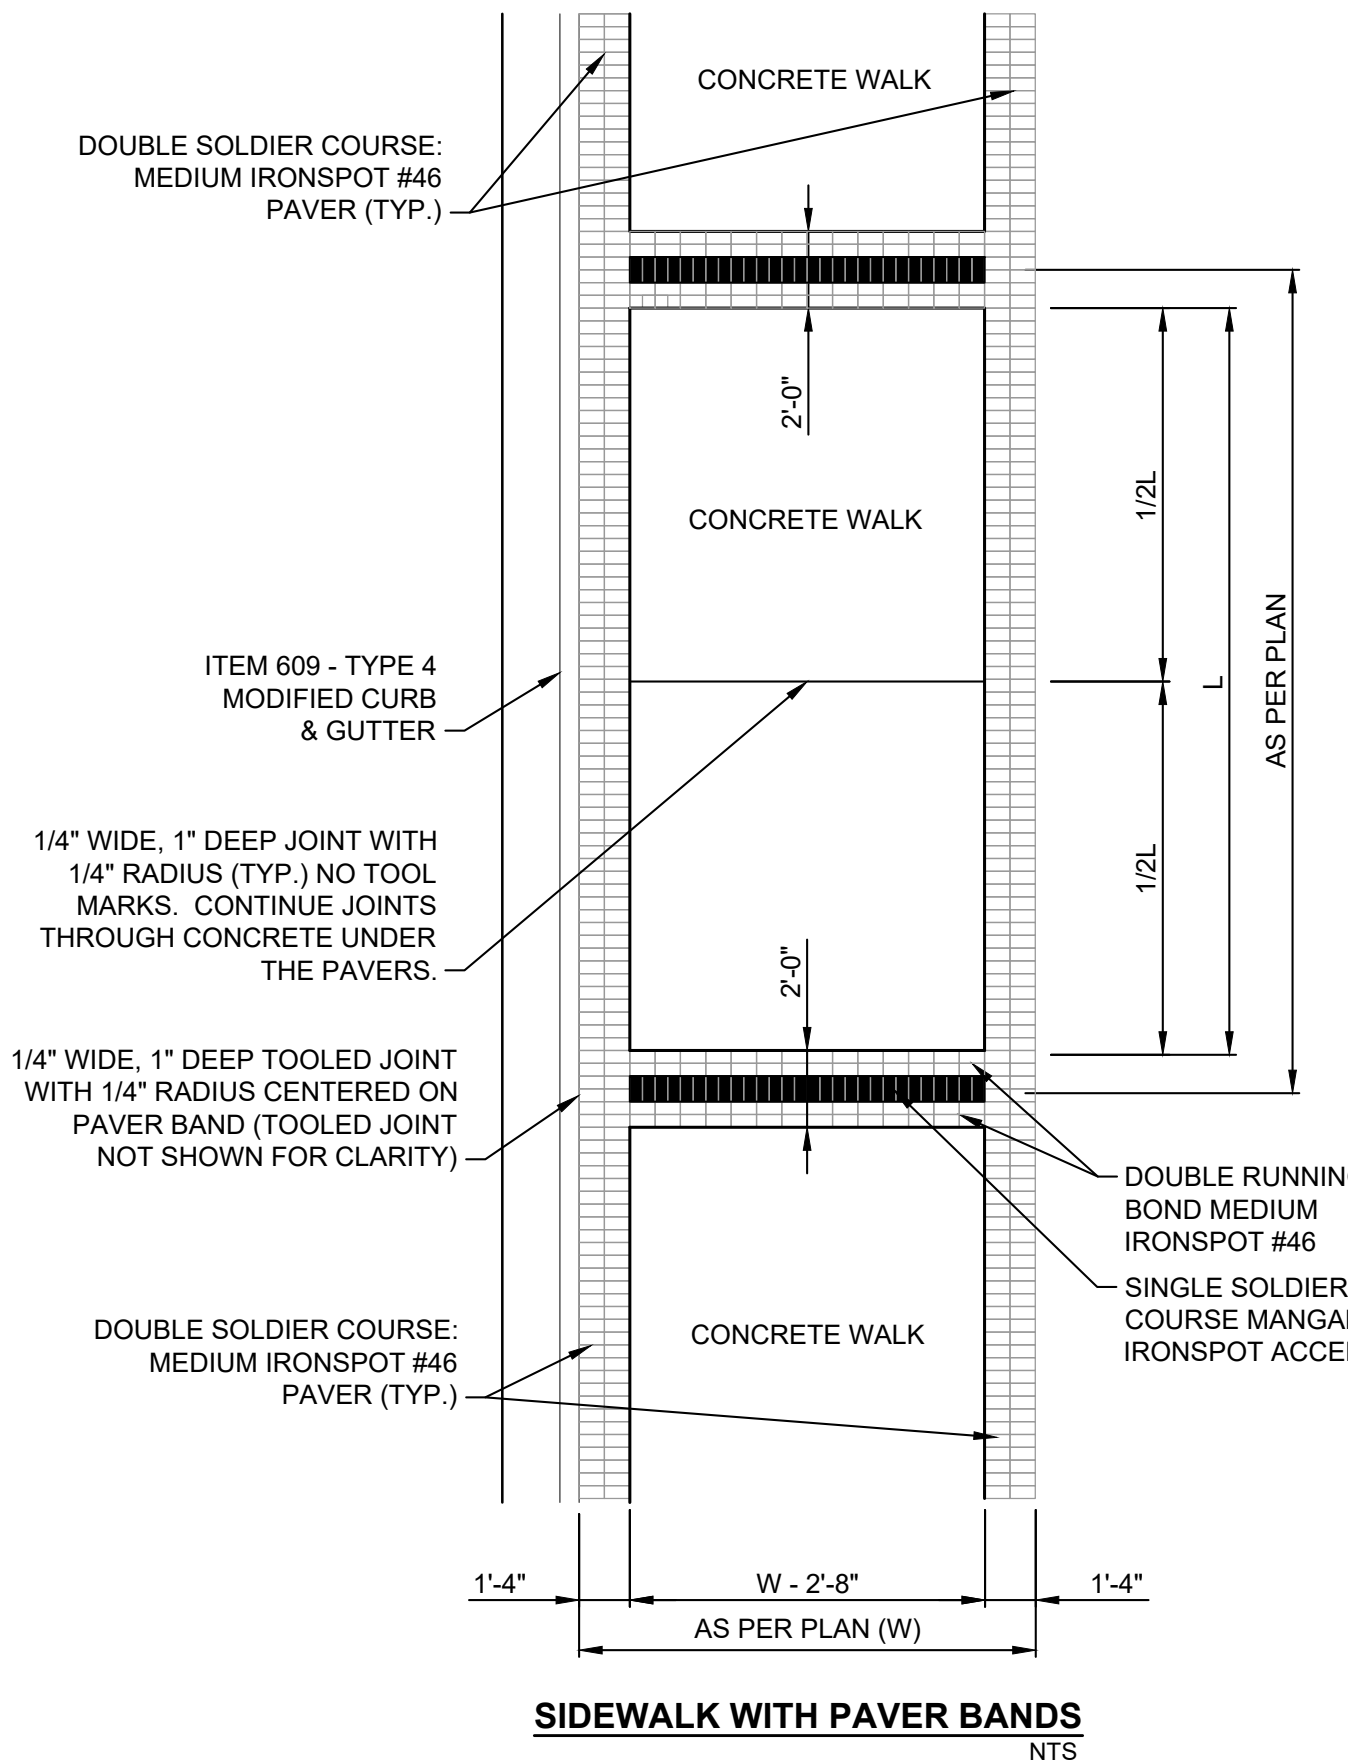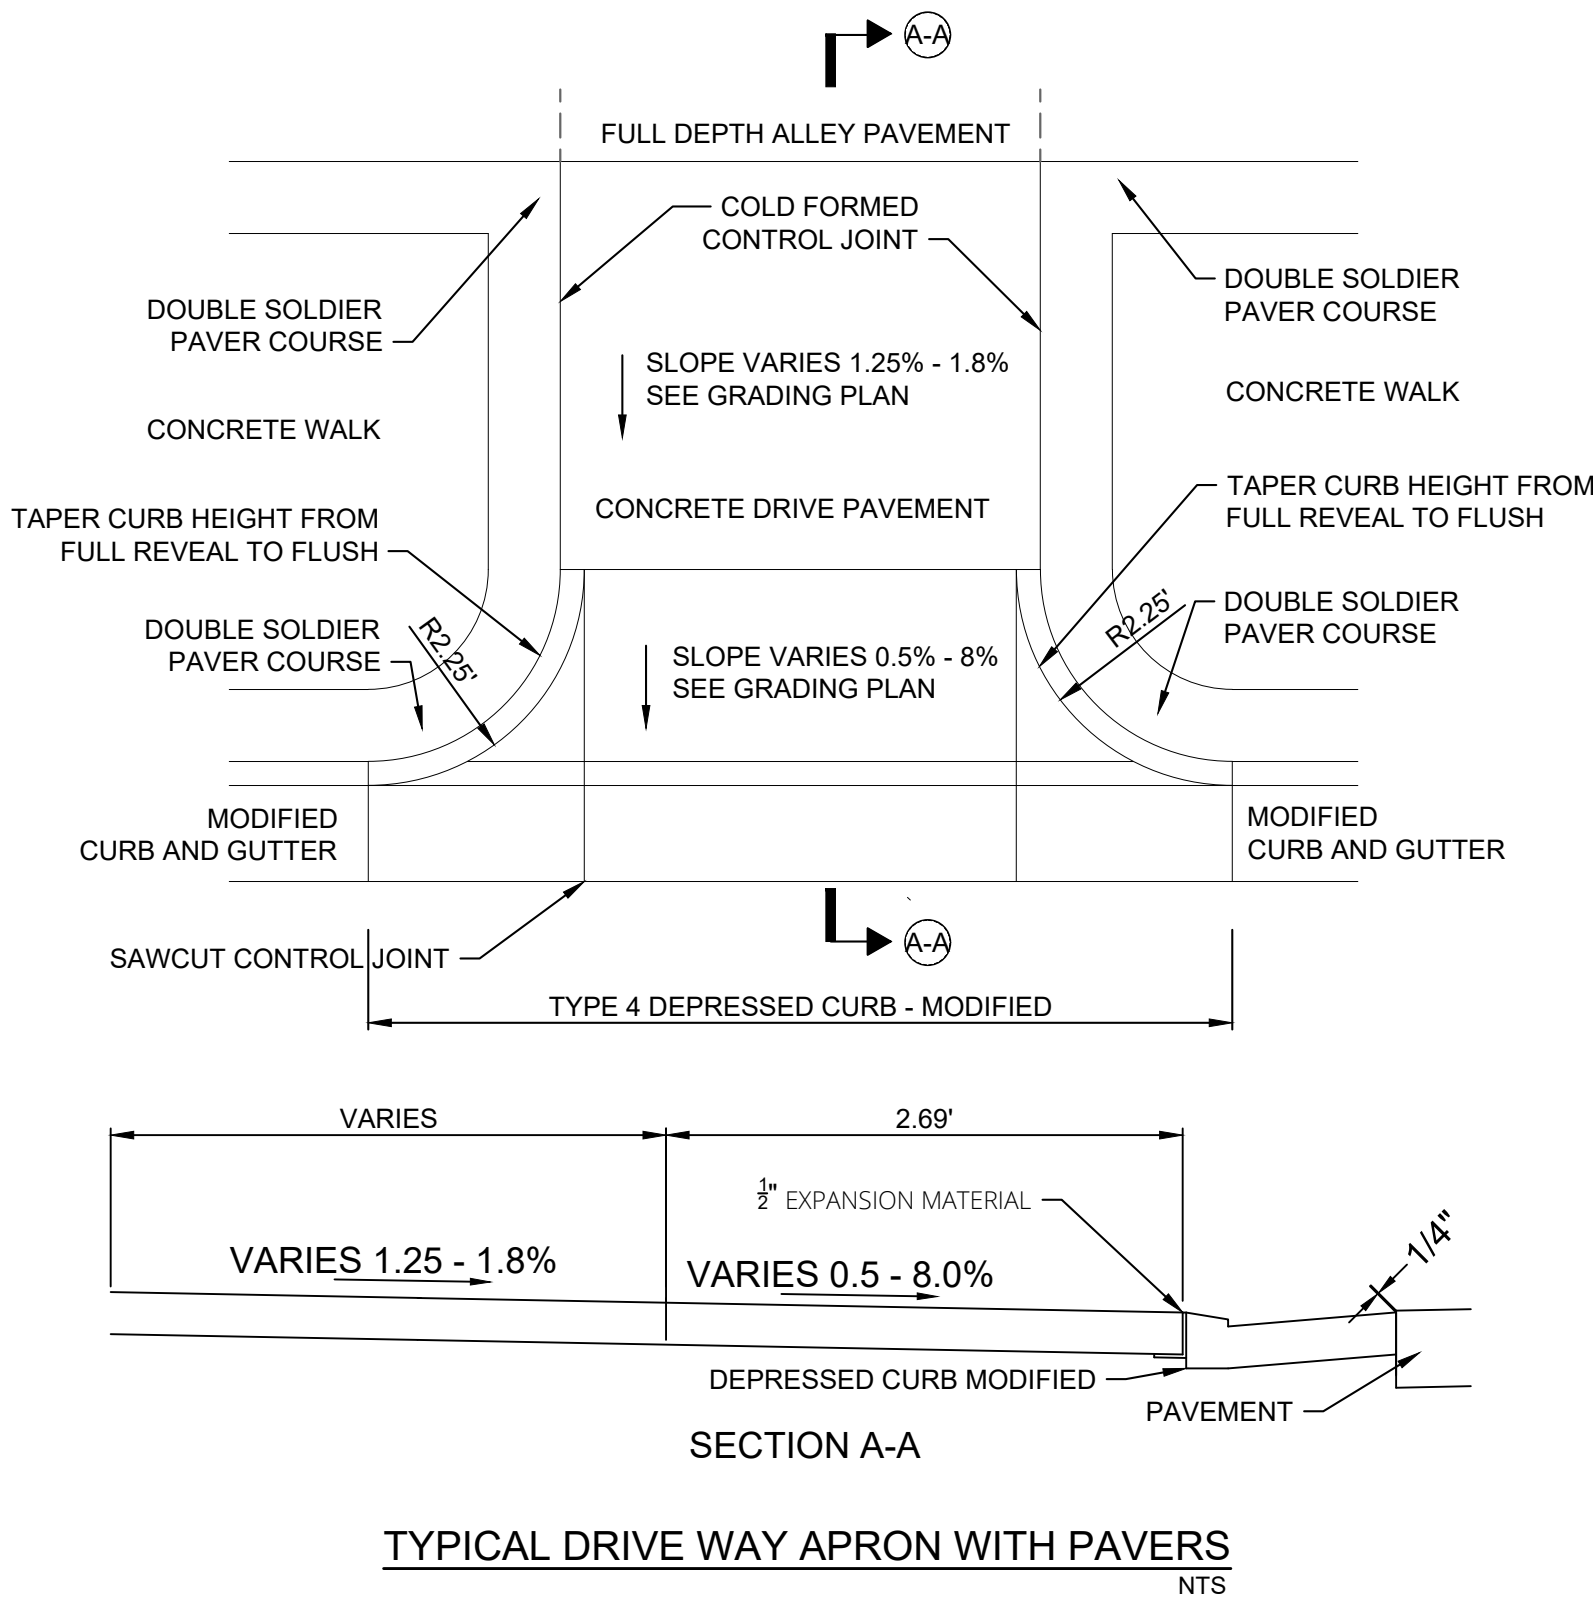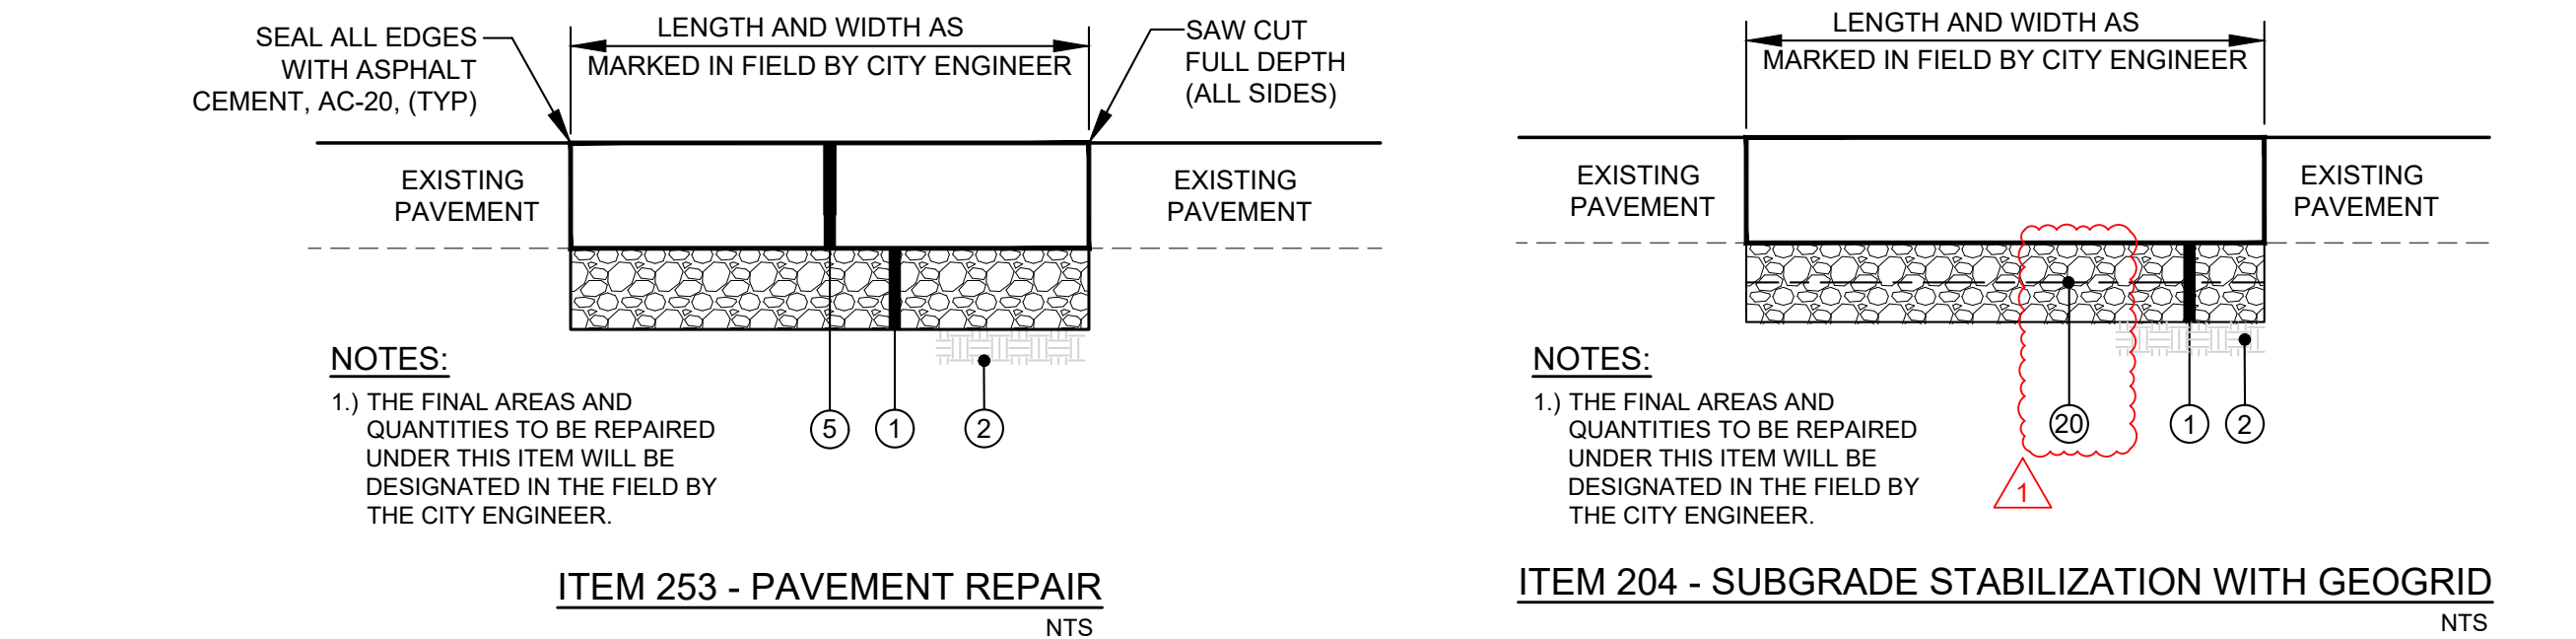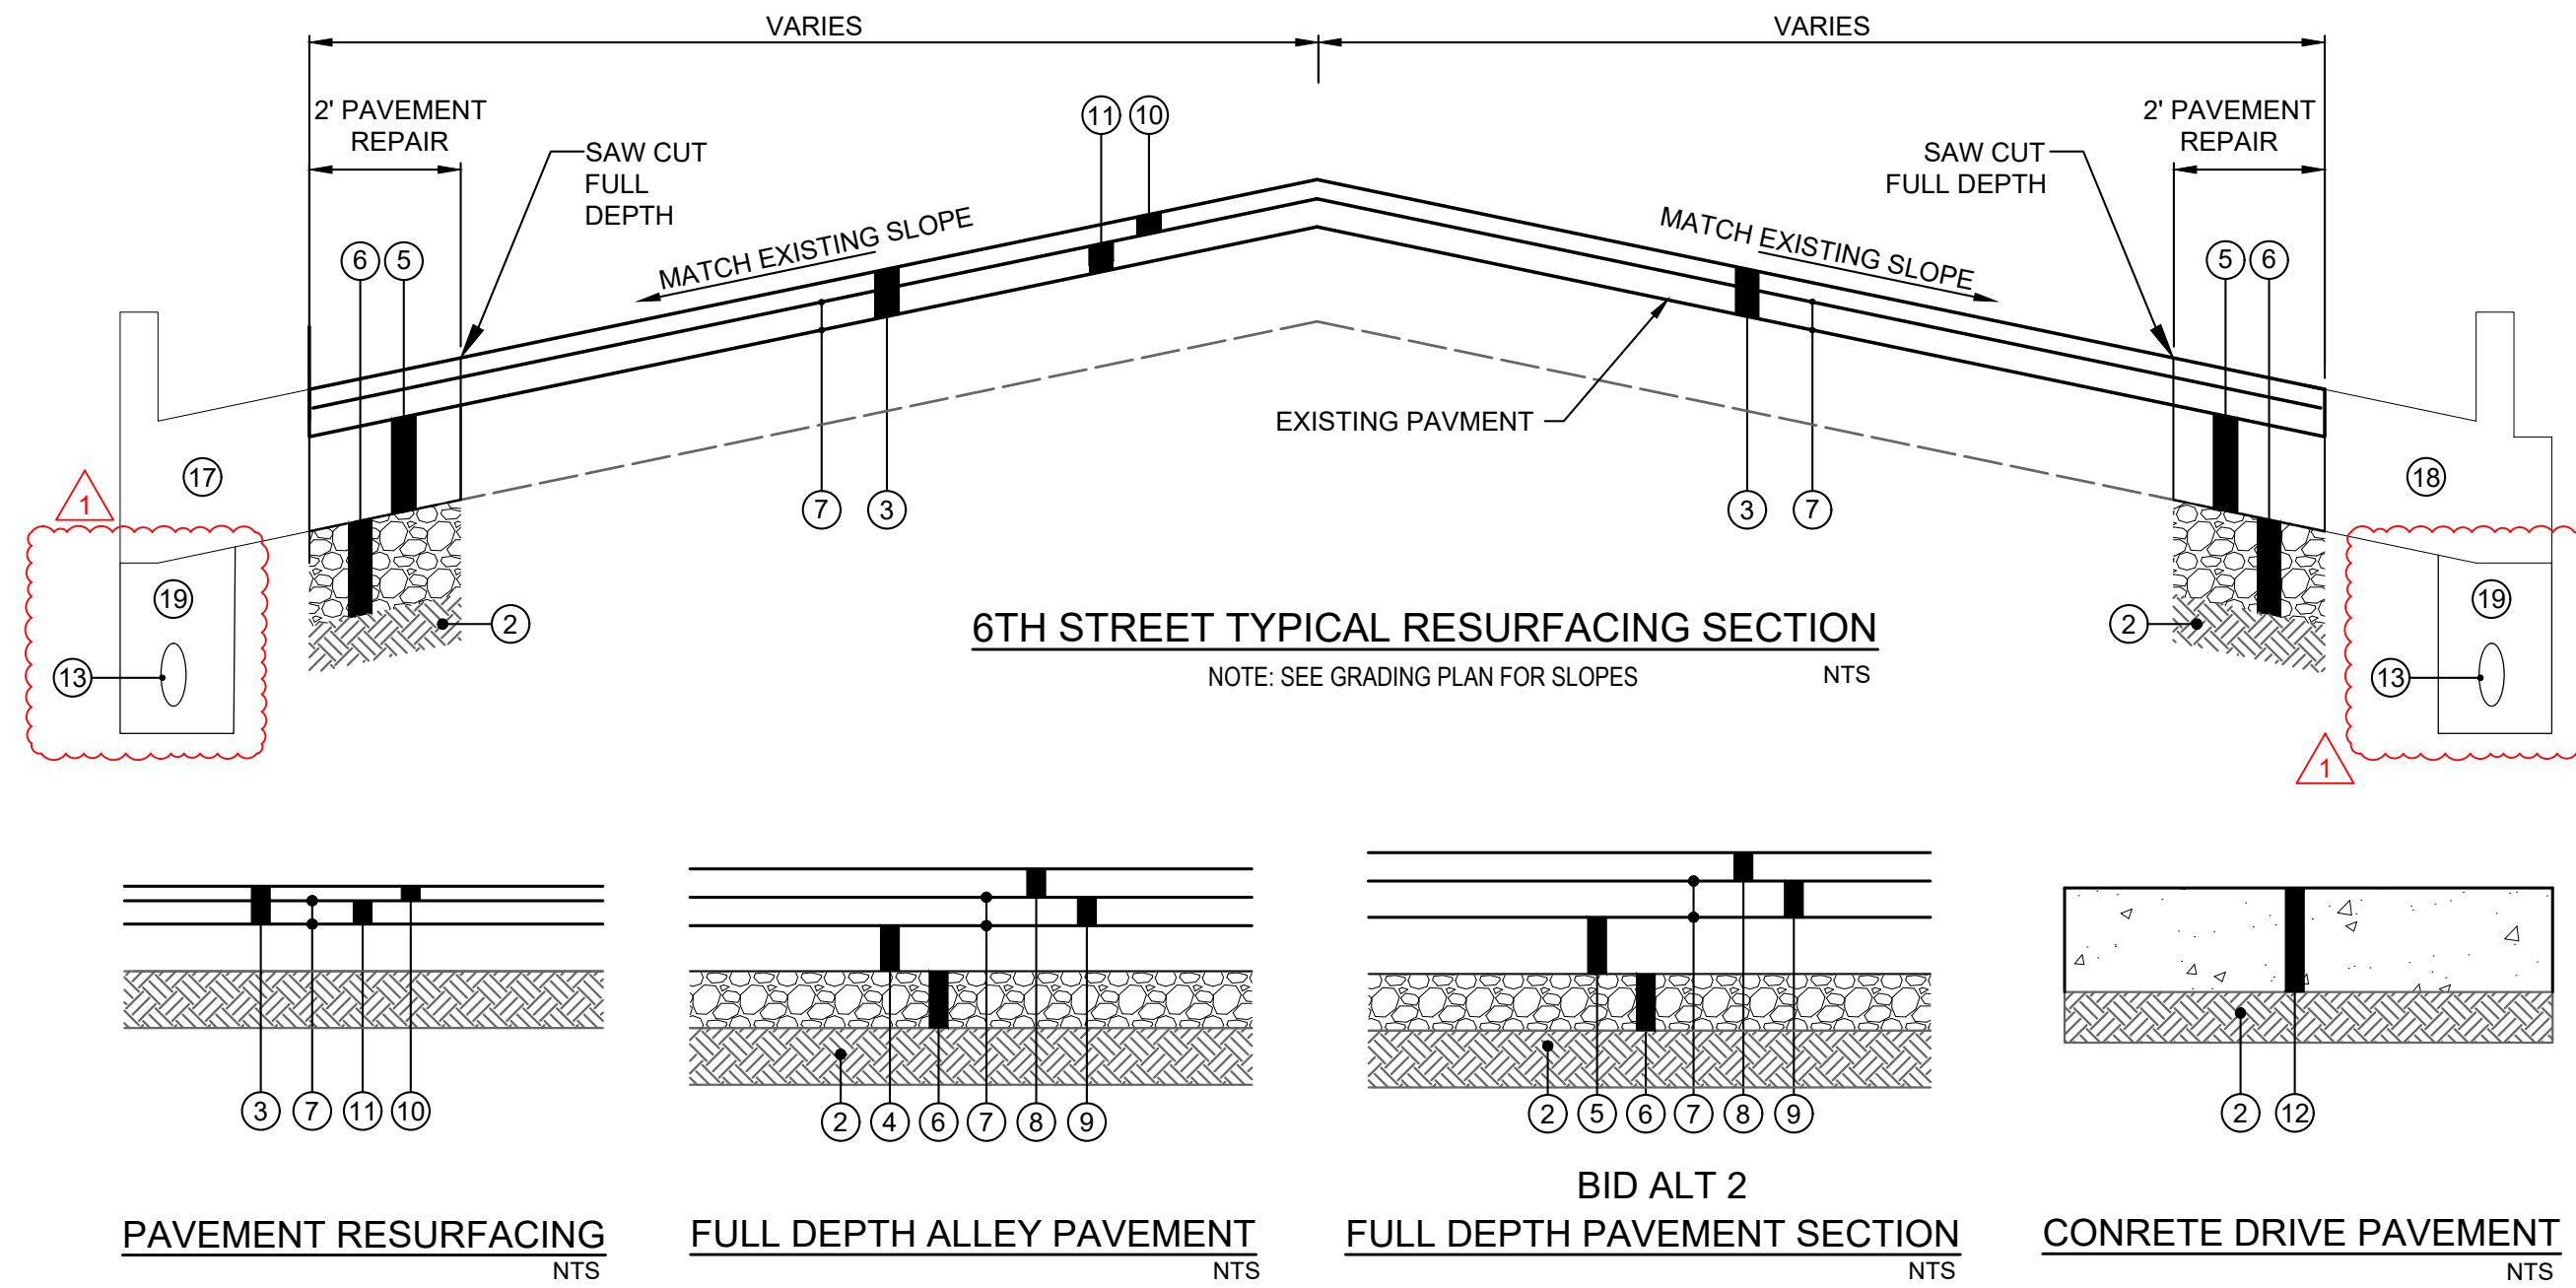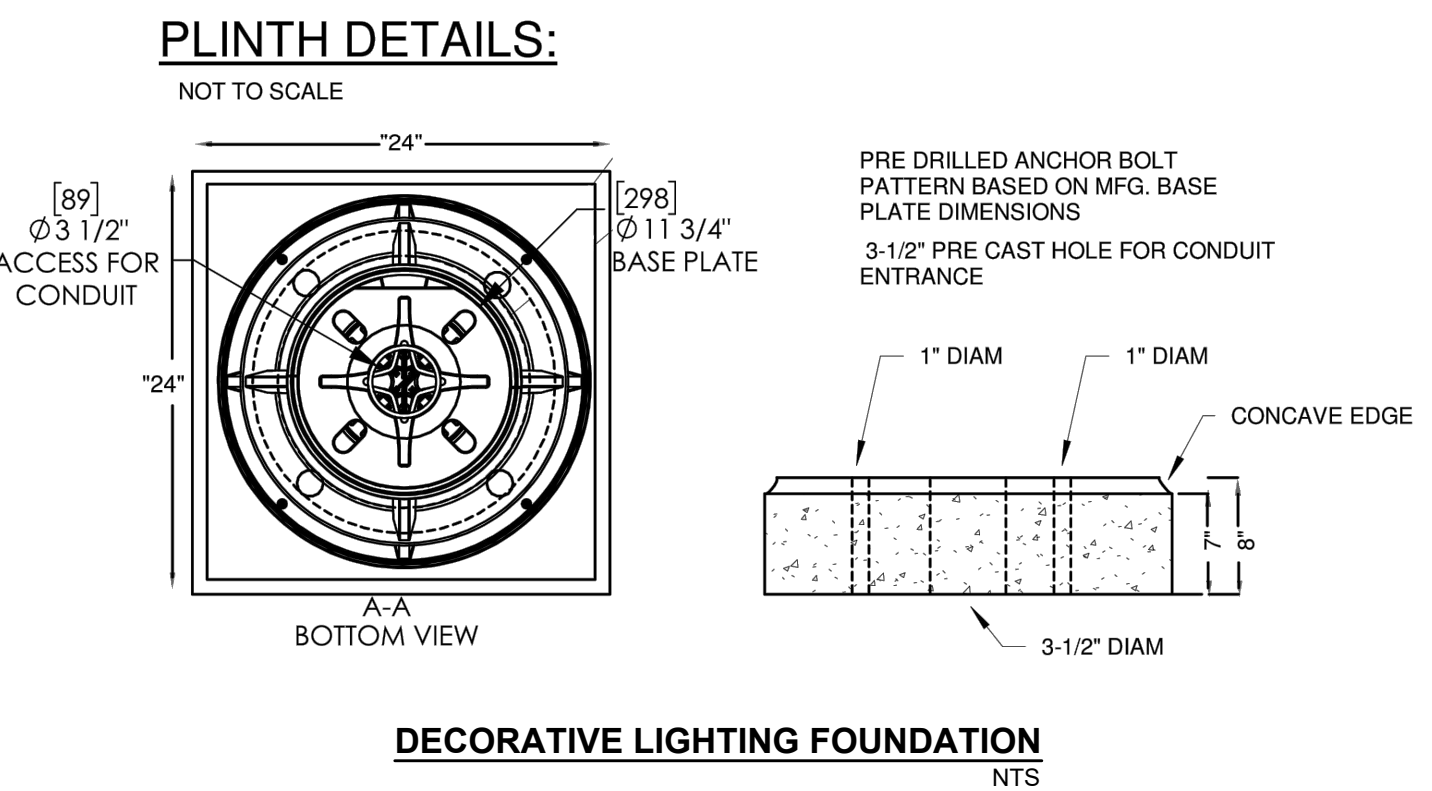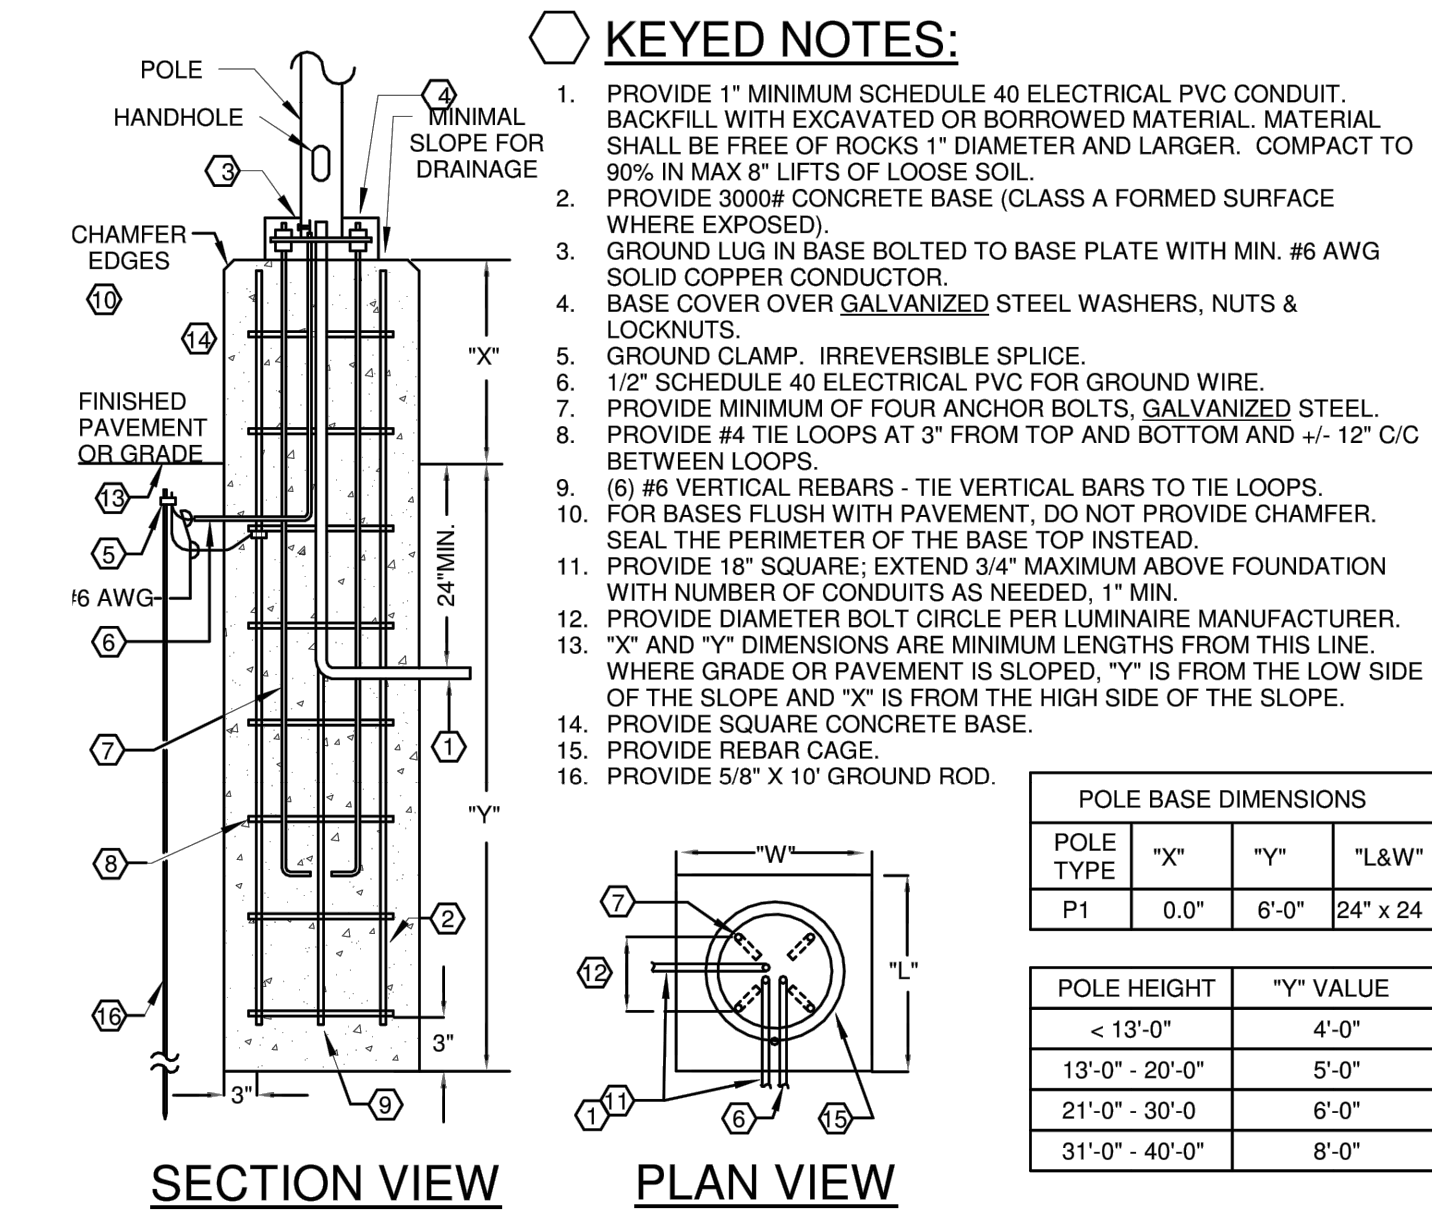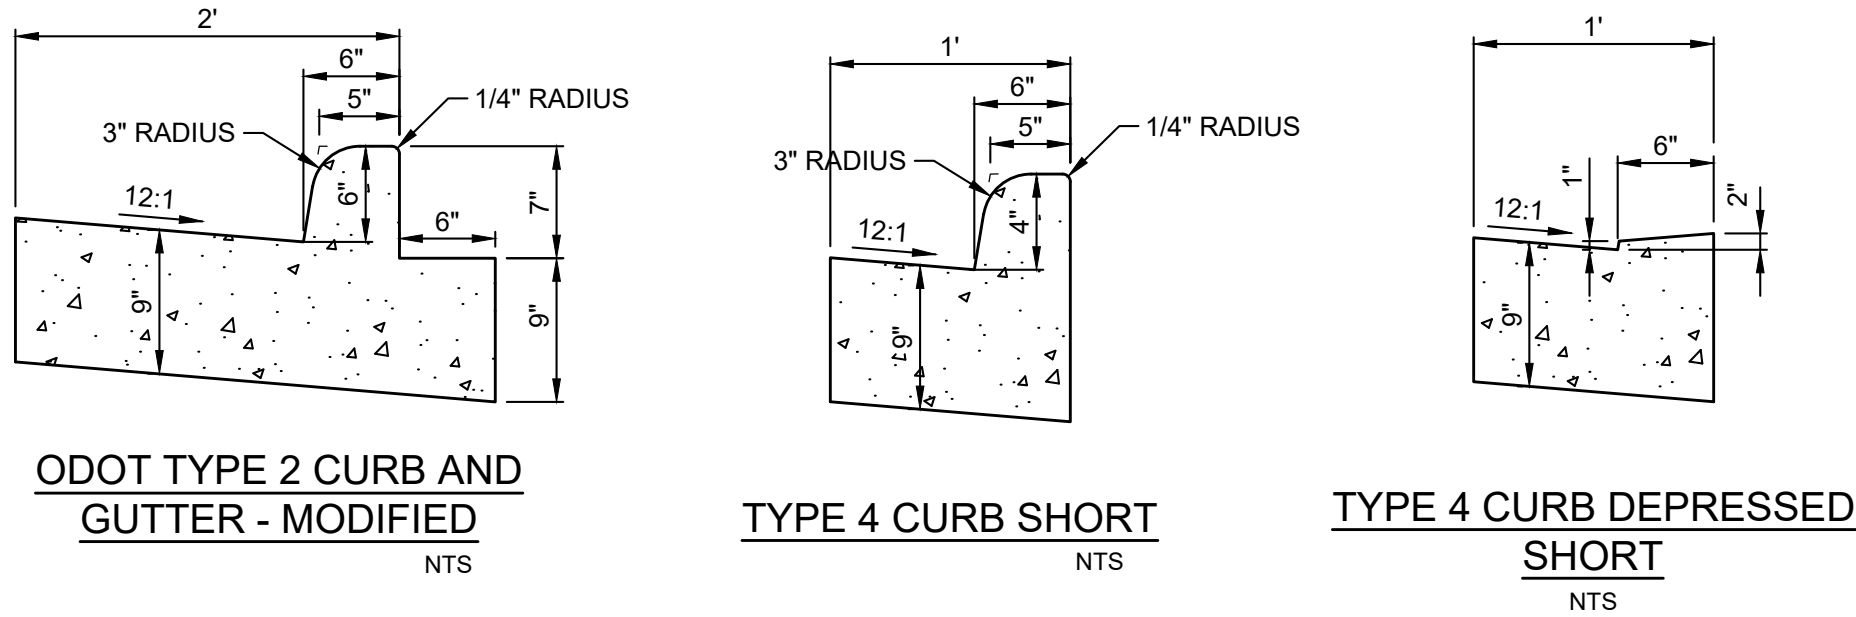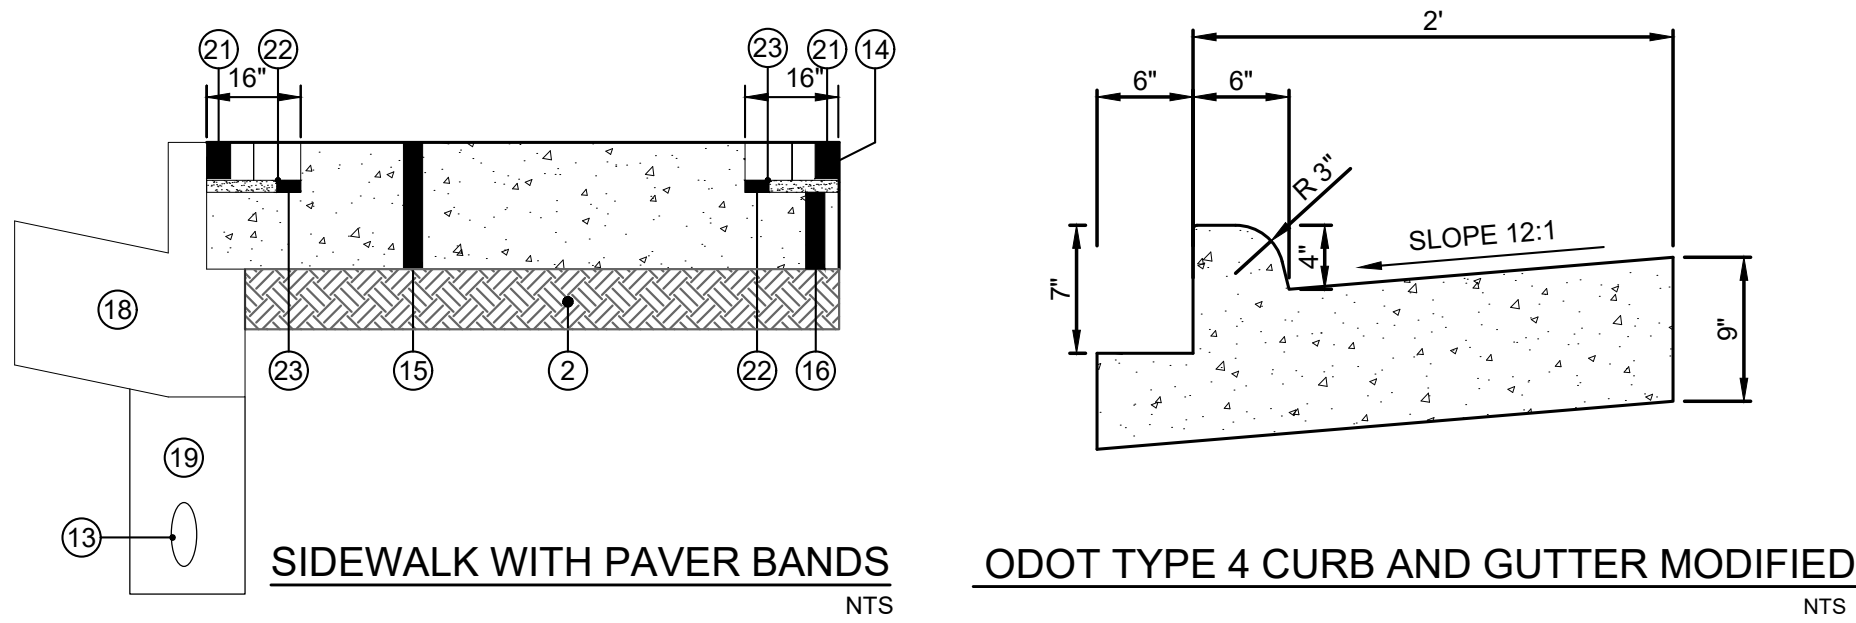


- LEGEND**
- ① ITEM 203 - 12" GRANULATED EMBANKMENT TYPE B (2" - 6" LIFTS)
 - ② ITEM 204 - COMPACTED SUBGRADE
 - ③ ITEM 254 - 2.5" PAVEMENT MILLING
 - ④ ITEM 301 - 6" ASPHALT BASE (3" LIFTS)
 - ⑤ ITEM 301 - 8" ASPHALT BASE (2" 4" LIFTS)
 - ⑥ ITEM 304 - 8" AGGREGATE BASE
 - ⑦ ITEM 407 - TACK COAT @ 0.05 GAL/SY (0.1 GAL/SY FOR MILLED SURFACES)
 - ⑧ ITEM 441 - 1-1/2" ASPHALT CONCRETE SURFACE COURSE, TYPE (448) 1 PG 64-22
 - ⑨ ITEM 441 - 2" ASPHALT CONCRETE INTERMEDIATE COURSE, TYPE 2 PG 64-22
 - ⑩ ITEM 441 - 1" ASPHALT CONCRETE SURFACE COURSE, TYPE (448) 1 PG 64-22
 - ⑪ ITEM 441 - 1-1/2" ASPHALT CONCRETE INTERMEDIATE COURSE, TYPE 2 PG 64-22
 - ⑫ ITEM 452 - 9" NON-REINFORCED CONCRETE PAVEMENT
 - ⑬ ITEM 605 - 6" RIGID PVC PERFORATED UNDERDRAIN
 - ⑭ ITEM 608 - 1/2" PRE FORMED EXPANSION JOINT ADJACENT TO BUILDINGS
 - ⑮ ITEM 608 - 7" CONCRETE SIDEWALK
 - ⑯ ITEM 608 - 4" CONCRETE SIDEWALK
 - ⑰ ITEM 609 - TYPE 4 CURB
 - ⑱ ITEM 609 - TYPE 2 & 4 MODIFIED CURB AND GUTTER
 - ⑲ ITEM 703.11 - STRUCTURAL BACKFILL TYPE 2 OR 3 INCIDENTAL UNDER DRAIN
 - ⑳ ITEM 712.15 - BIAXIAL GEOGRID
 - ㉑ ITEM SPL - CLAY PAVER - SEE PAVER SPECIFICATION
 - ㉒ ITEM SPL - 3/4" ROLLED BITUMINOUS SETTING BED
 - ㉓ ITEM SPL - TACK COAT @ 0.1 GAL/SY

DATE	08/07/2026	REVISION	NO	ISSUE DATE	05/28/2026	SCALE	AS SHOWN	DESIGNED BY	JHOO	DRAWN BY	AJAC	CHECKED BY	MLAC
EAST 6TH STREET IMPROVEMENT PROJECT CITY OF FRANKLIN WARREN COUNTY, OHIO													
DETAILS													
PROJECT NO. 43188													
DISCIPLINE CIVIL													
SHEET NAME DET													
SHEET 4 OF 9													

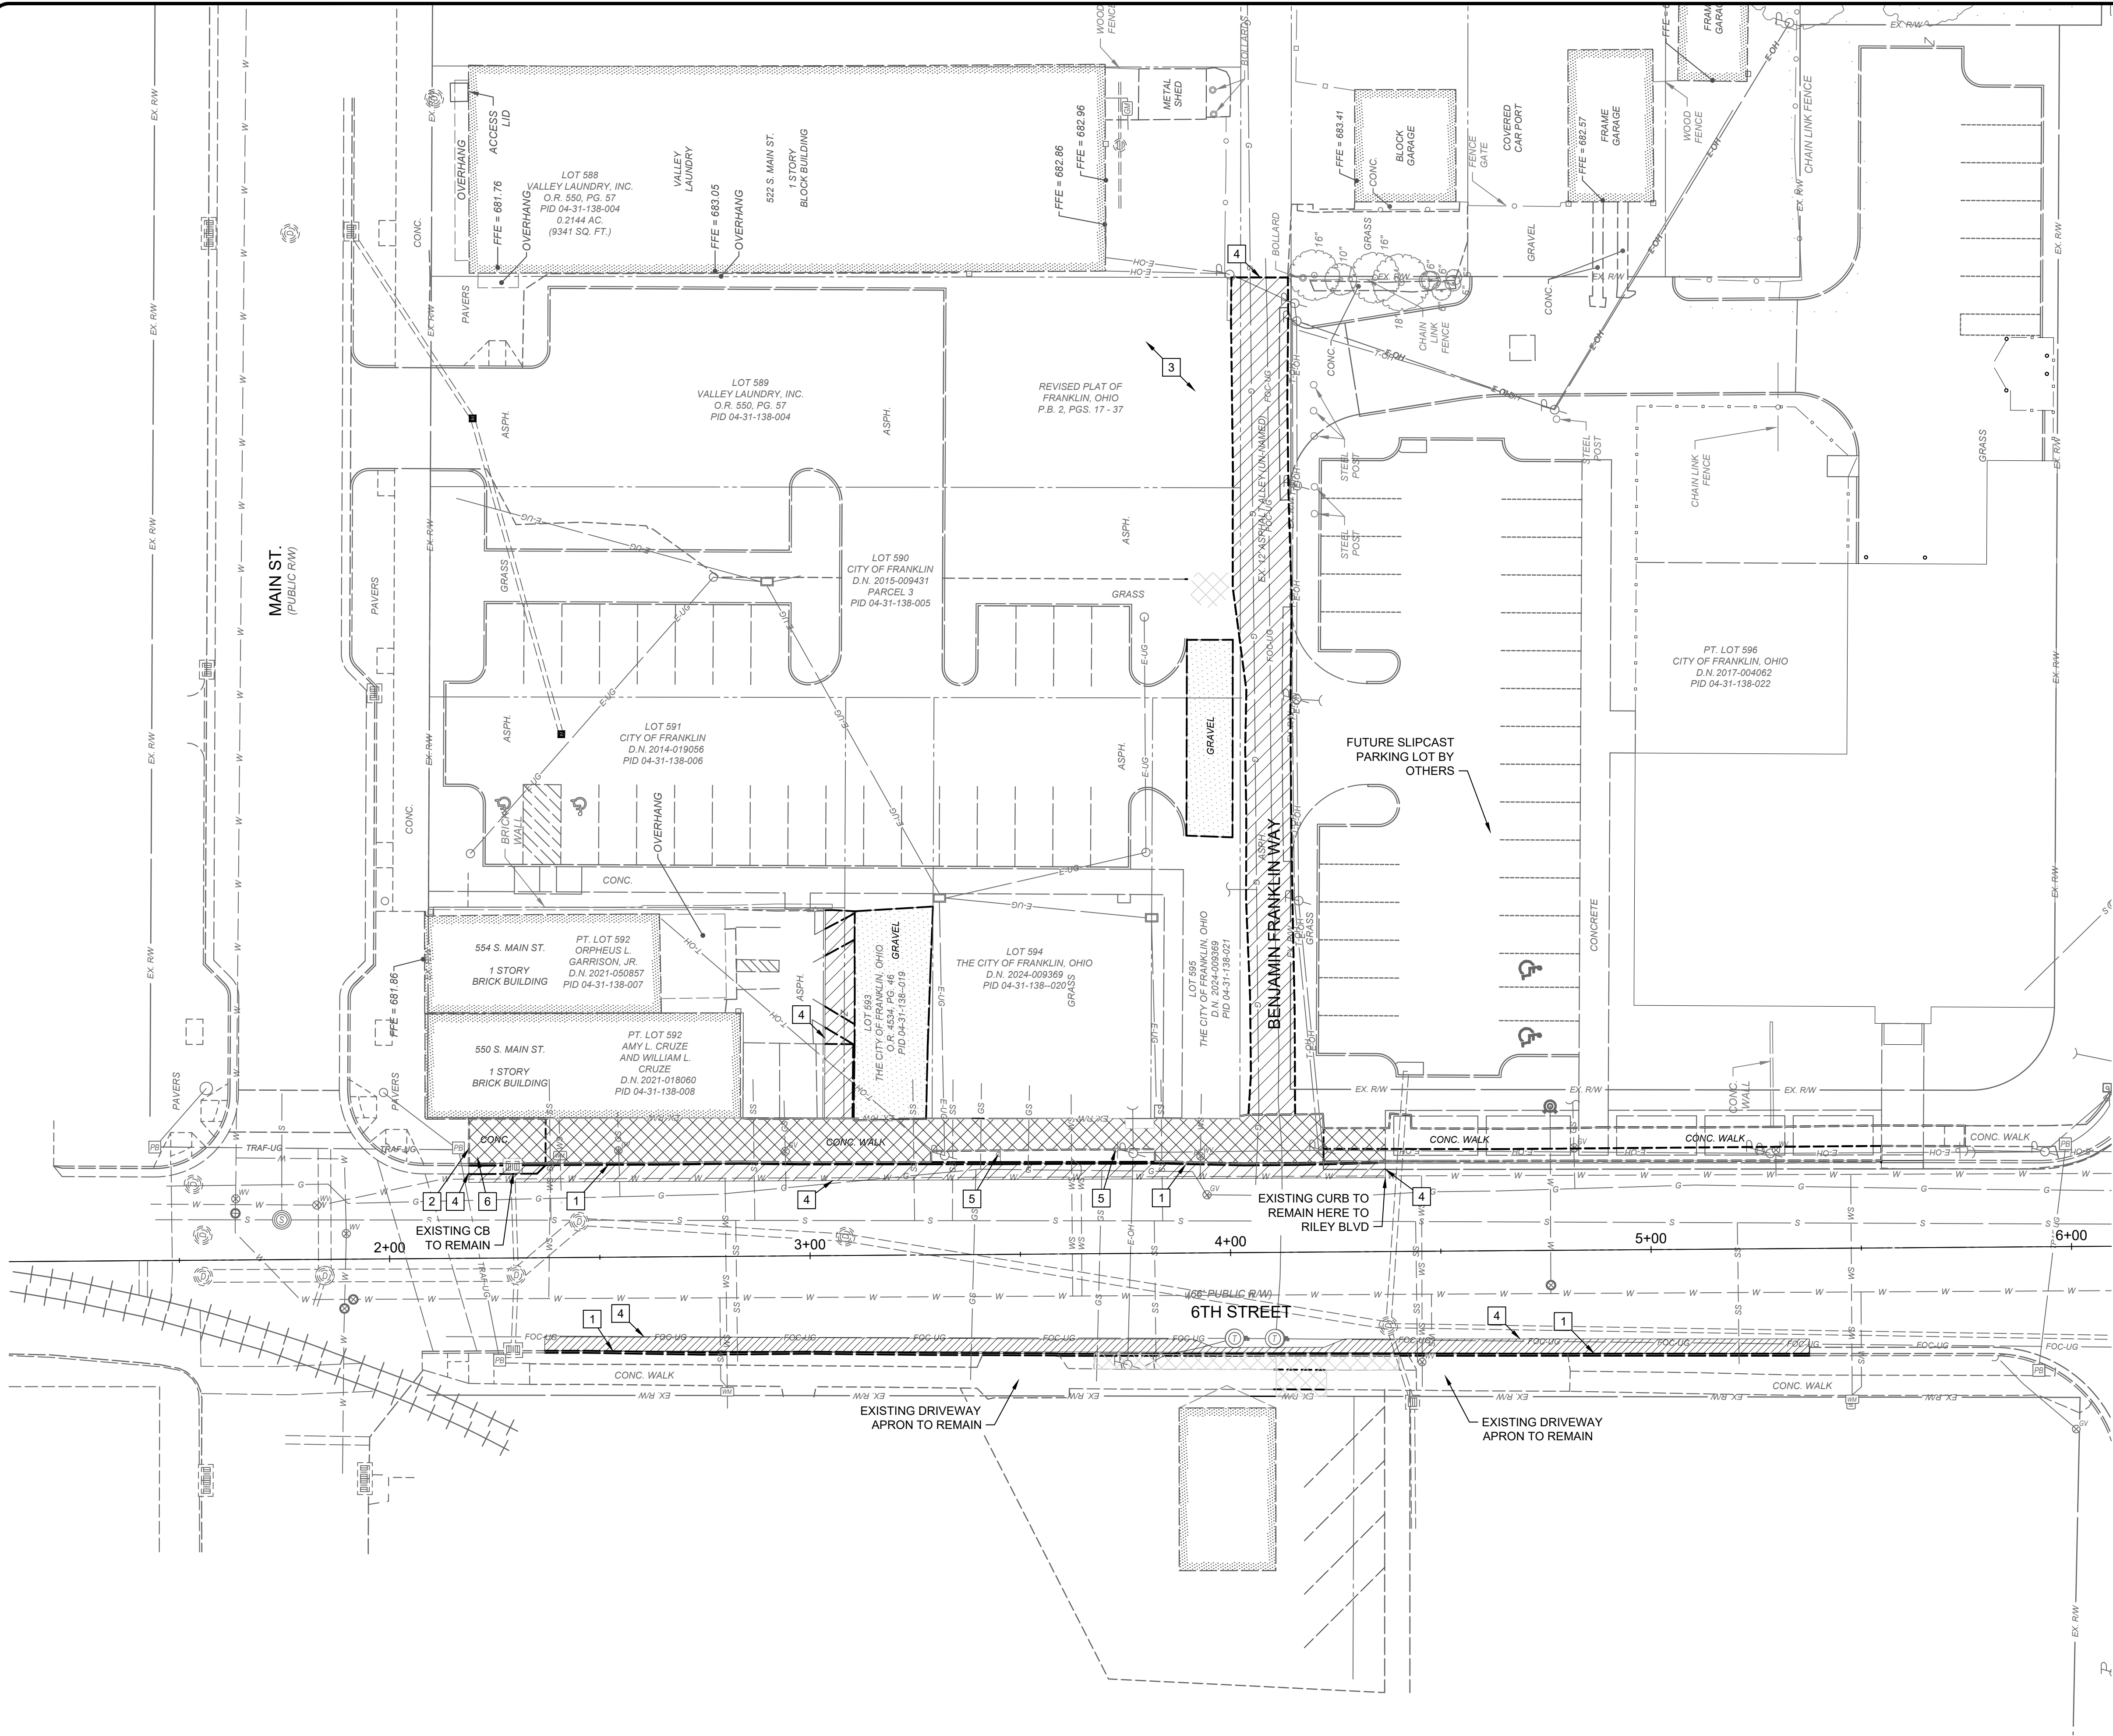


CONSTRUCTION NOTES	
1	ITEM 202 - REMOVE EXISTING CURB
2	EXISTING PAVERS TO REMAIN
3	REMOVAL OF FENCE AND STORAGE SHED BY OTHERS
4	ITEM 202 - SAWCUT PAVEMENT
5	ITEM 202 - REMOVE AND SALVAGE SIGNS
6	EXISTING STOP SIGN REMOVED BY OTHERS
NOTE: 10" WATERMAIN IS BASED ON CONSTRUCTION DOCUMENTS DATED: 3/18/2026	
NOTE: SLIPCAST BREWING SITE PLAN IS BASED ON CONSTRUCTION DOCUMENTS DATED: 03/19/2026	

HATCH LEGEND	
	ITEM 202 - REMOVE EXISTING CONCRETE
	ITEM 202 - FULL DEPTH PAVEMENT REMOVAL
	ITEM 202 - REMOVE EXISTING GRAVEL

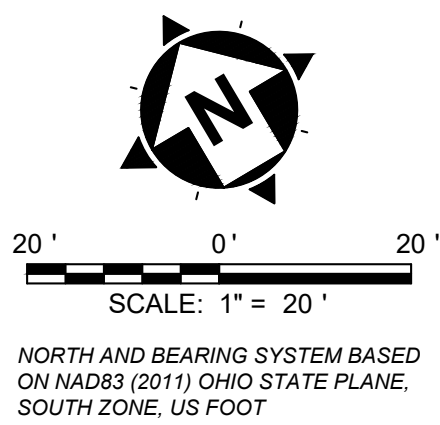


	DATE	
	08/07/2026	
	REVISION	
	PER ADDENDUM #2	
	NO	Δ
ISSUE DATE:	05/28/2026	AS SHOWN
SCALE:		
DESIGNED BY:	JHOO	AJAC
DRAWN BY:		MLAC
CHECKED BY:		
EAST 6TH STREET IMPROVEMENT PROJECT		
CITY OF FRANKLIN		
WARREN COUNTY, OHIO		
EXISTING CONDITIONS AND DEMO PLAN - OVERALL		
PROJECT NO.		
43188		
DISCIPLINE		
CIVIL		
SHEET NAME		
DEMO1		
SHEET	OF	
5	9	

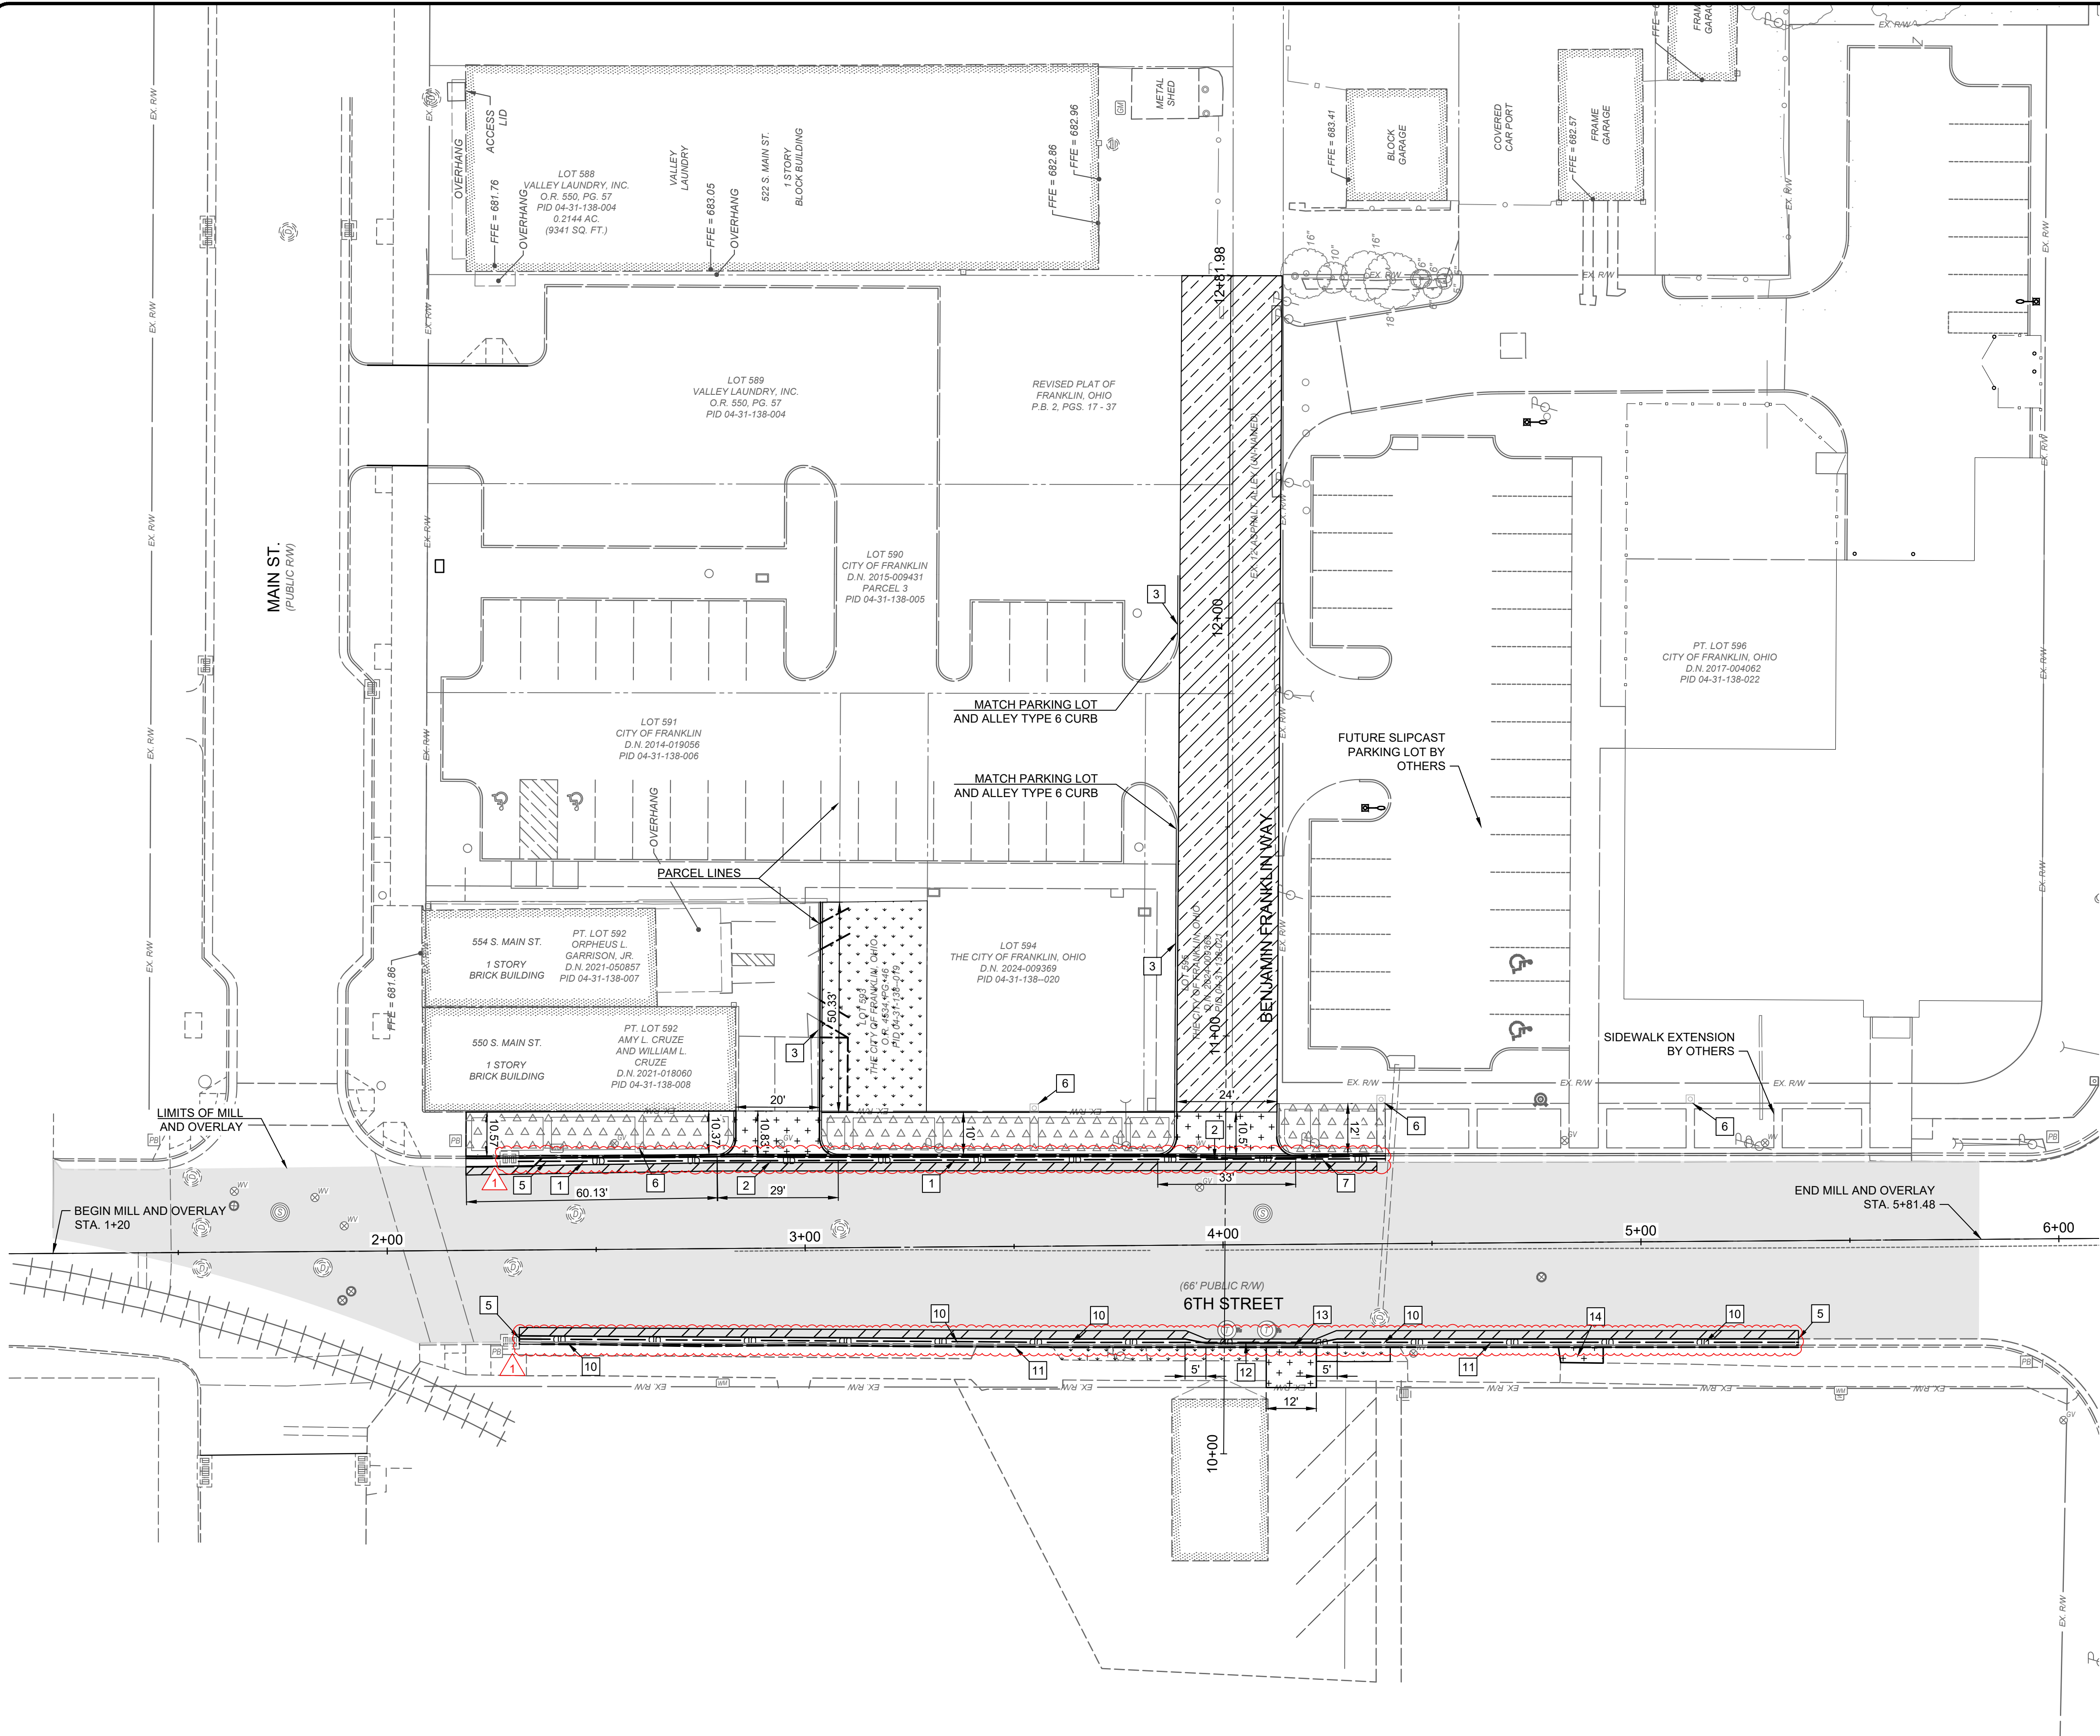

CONSTRUCTION NOTES	
1	ITEM 609 - TYPE 4 CURB - MODIFIED
2	ITEM 609 - TYPE 4 DEPRESSED CURB - MODIFIED
3	ITEM 609 - TYPE 6 CURB
4	ITEM 609 - TYPE 6 DEPRESSED CURB
5	ITEM 609 - TAPER CURB AND GUTTER TO MATCH EXISTING
6	ITEM 623 - DECORATIVE LIGHTING
7	ITEM 609 - TYPE 2 CURB AND GUTTER - MODIFIED
8	ITEM 609 - TYPE 6 CURB - MODIFIED
9	ITEM 609 - TYPE 6 DEPRESSED CURB - MODIFIED
10	ITEM 609 - TYPE 4 CURB
11	ITEM 609 - TYPE 4 DEPRESSED CURB
12	ITEM 609 - TYPE 4 CURB SHORT
13	ITEM 609 - TYPE 4 DEPRESSED CURB SHORT
14	ITEM 608 - EXTEND CONCRETE SIDEWALK TO BACK OF CURB

HATCH LEGEND	
	ITEM 451 - MILL AND OVERLAY (SEE SHEET 3 FOR NOTES AND SHEET 4 FOR DETAILS)
	ITEM 451 - FULL DEPTH PAVEMENT (SEE SHEET 3 FOR NOTES AND SHEET 4 FOR DETAILS)
	ITEM 609 - SIDEWALK WITH PAVER BAND (SEE SHEET 3 FOR NOTES AND SHEET 4 FOR DETAILS)
	ITEM 253 - PAVEMENT REPAIR SECTION (SEE SHEET 3 FOR NOTES AND SHEET 4 FOR DETAILS)
	ITEM 659 - TOPSOIL SEED AND MULCH (SEE SHEET 3 FOR NOTES)
	ITEM 452 - CONCRETE DRIVE PAVEMENT (SEE SHEET 3 FOR NOTES AND SHEET 4 FOR DETAILS)

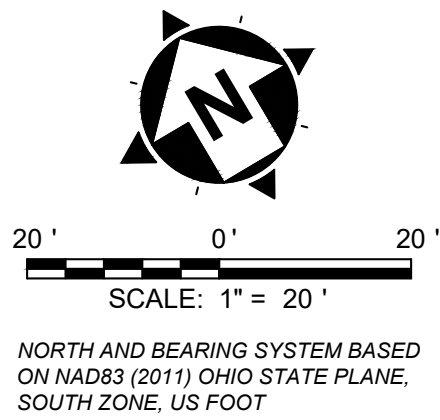

NO	REVISION	DATE
1	PER ADDENDUM #2	08/07/2026

ISSUE DATE:	05/28/2026	AS SHOWN	JHOO	AJAC	MLAC
SCALE:					
DESIGNED BY:					
DRAWN BY:					
CHECKED BY:					


EAST 6TH STREET IMPROVEMENT PROJECT

CITY OF FRANKLIN



WARREN COUNTY, OHIO

LAYOUT PLAN - OVERALL

PROJECT NO.	43188
DISCIPLINE	CIVIL
SHEET NAME	LAY1
SHEET	6
OF	9

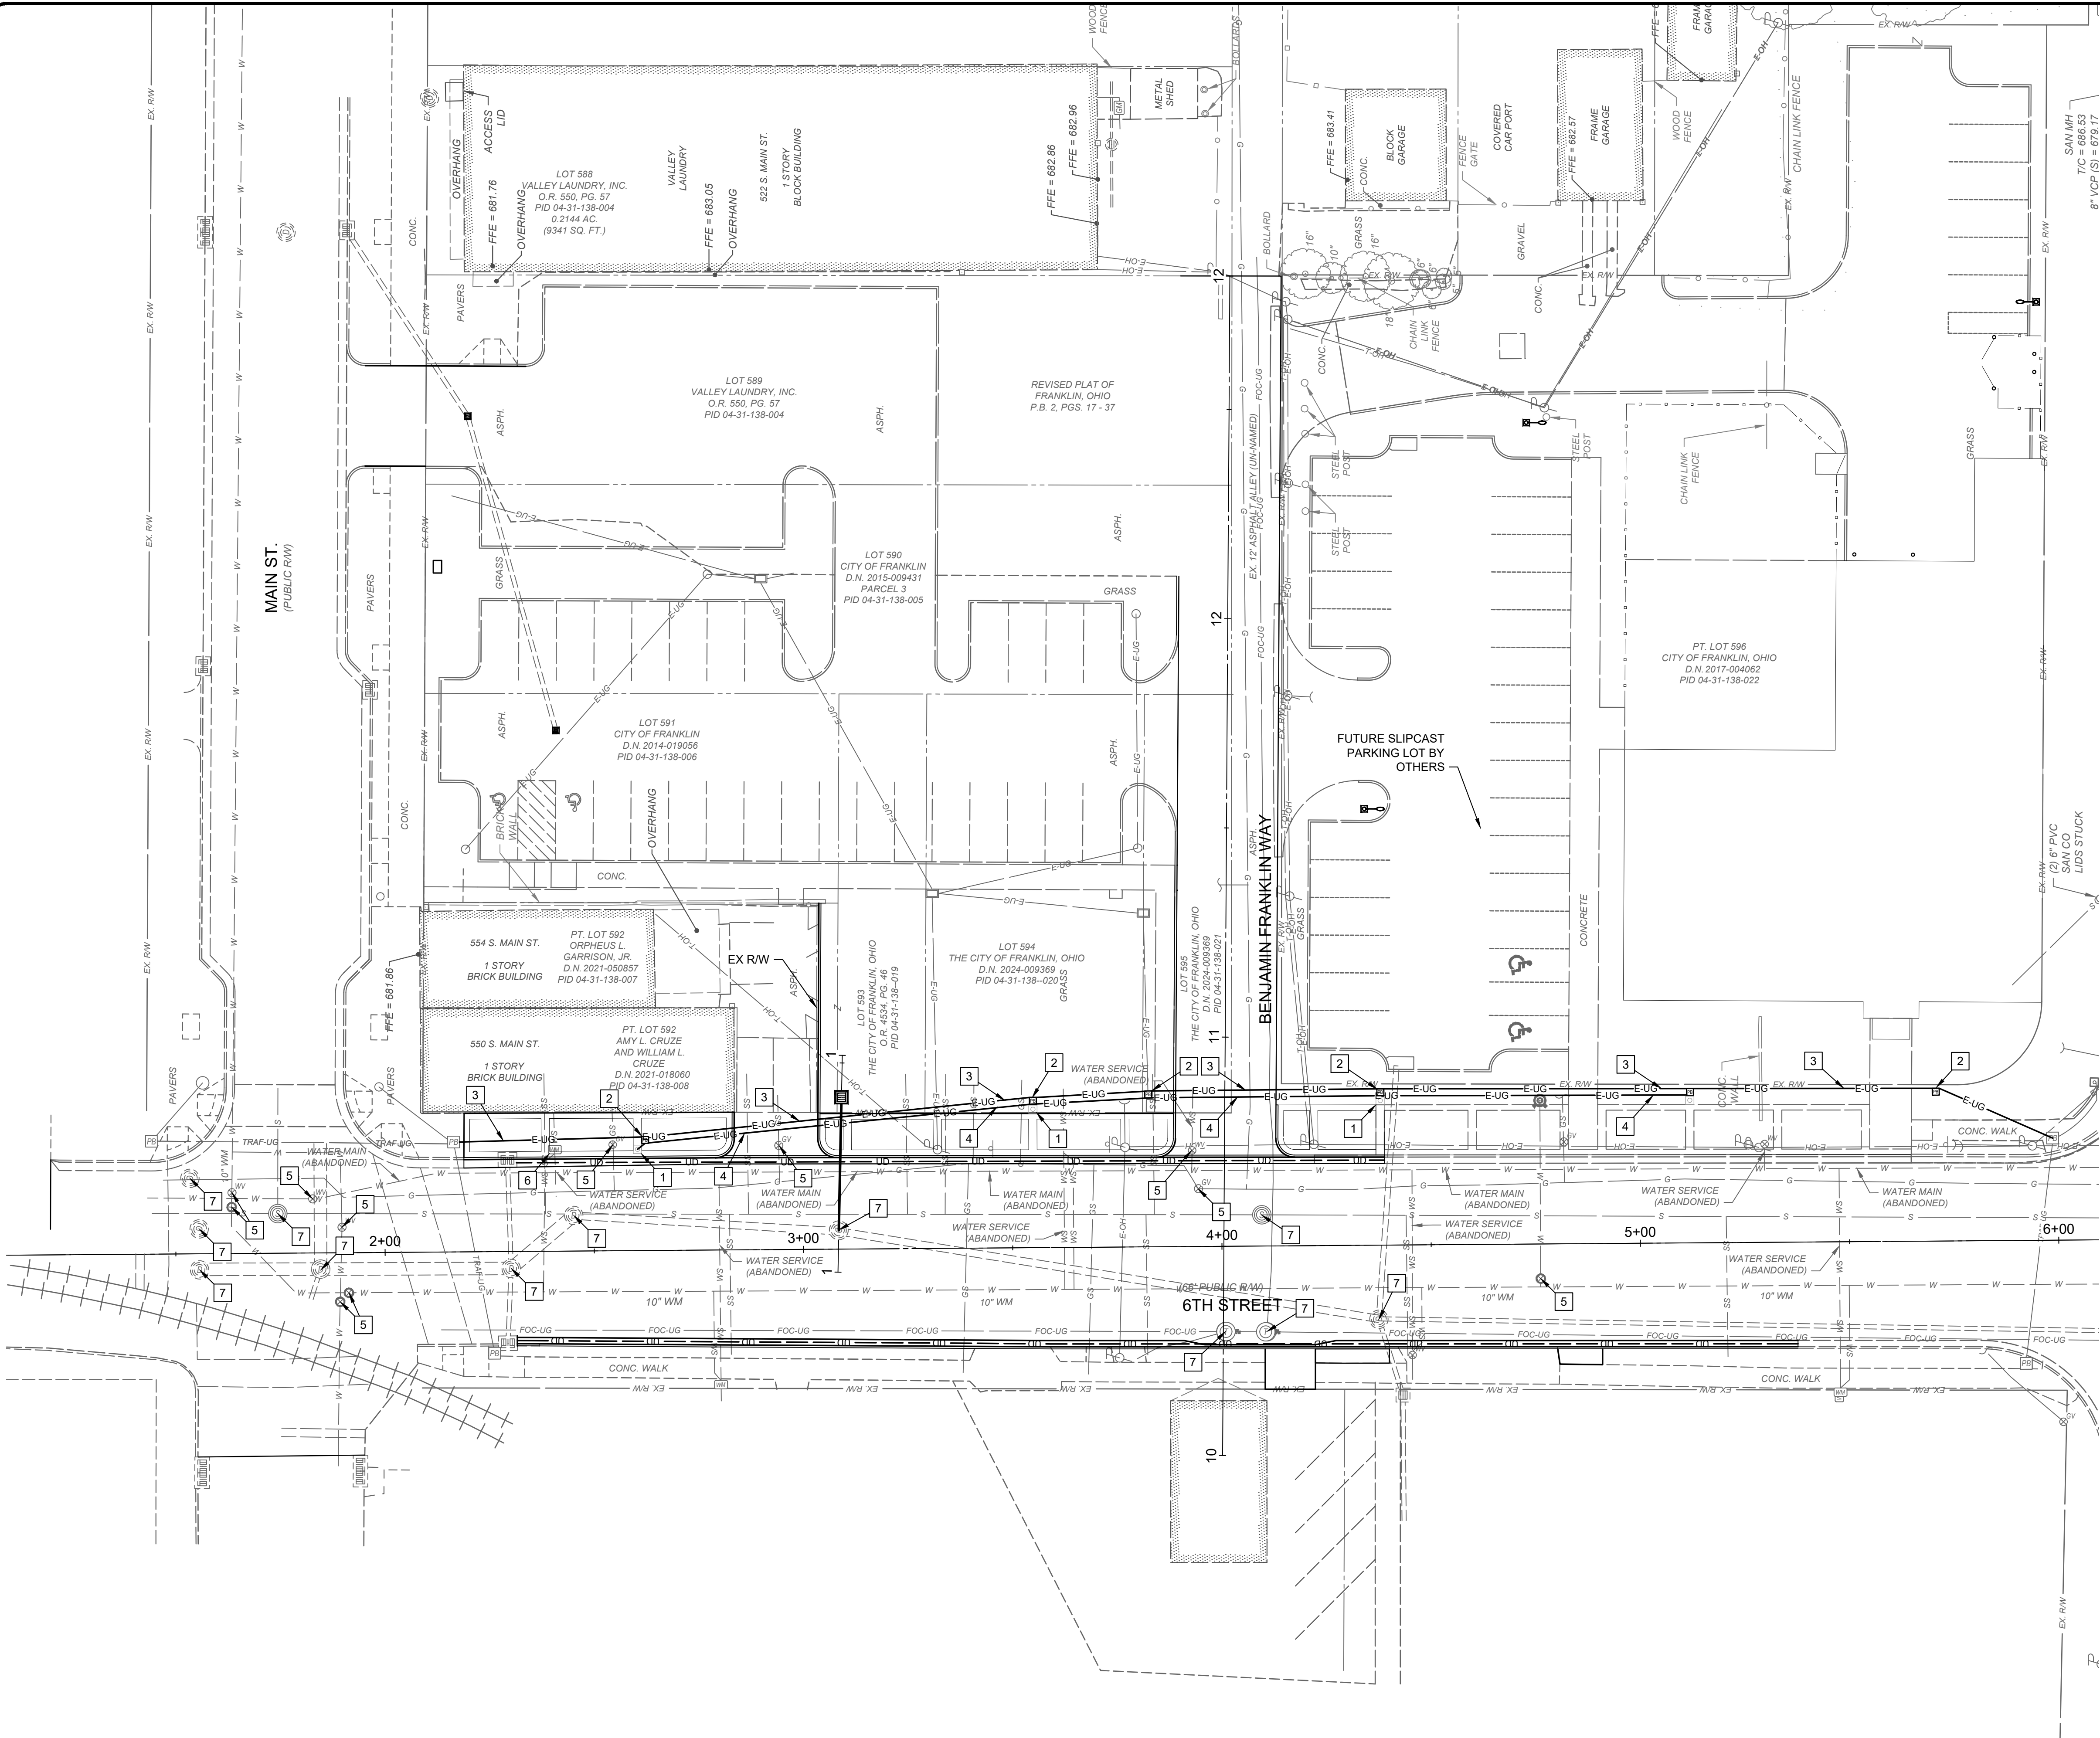

CONSTRUCTION NOTES	
1	ITEM 623 - DECORATIVE LIGHTING FOUNDATION
2	ITEM 625 - PULL BOX
3	ITEM 625 - 4" ELECTRIC CONDUIT
4	ITEM 625 - 1.5" ELECTRIC CONDUIT
5	ITEM 638 - ADJUST VALVE TO GRADE
6	ITEM 638 - ADJUST METER TO GRADE
7	ITEM 611 - ADJUST MANHOLE TO GRADE

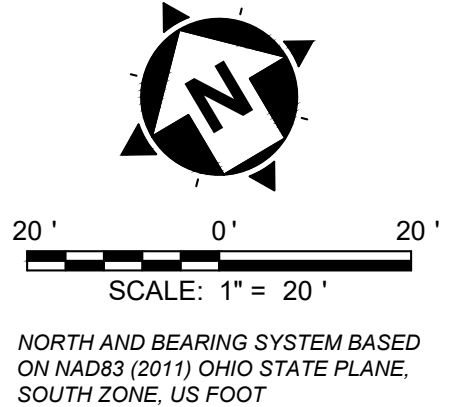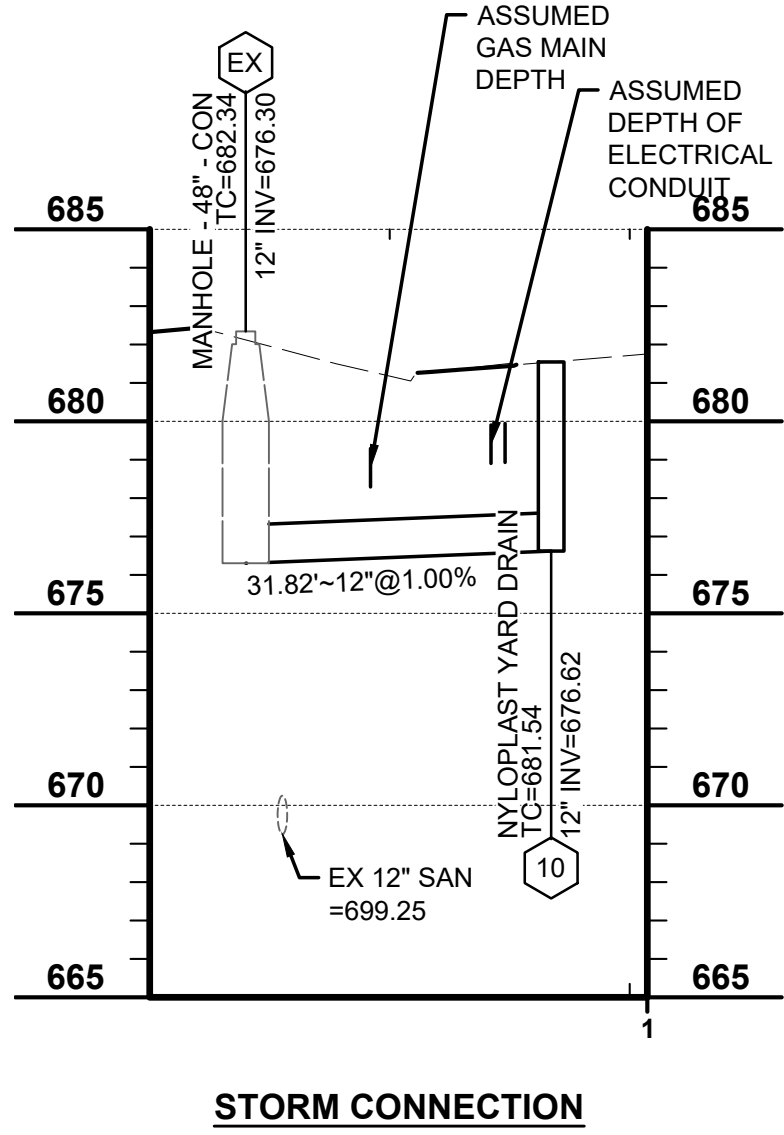

NO	REVISION	DATE
1	PER ADDENDUM #2	08/07/2026

ISSUE DATE:	05/28/2026	AS SHOWN	JHOO	AJAC	MLAC
SCALE:					
DESIGNED BY:					
DRAWN BY:					
CHECKED BY:					



EAST 6TH STREET IMPROVEMENT PROJECT

CITY OF FRANKLIN

WARREN COUNTY, OHIO

UTILITY PLAN - OVERALL

PROJECT NO.	43188
DISCIPLINE	CIVIL
SHEET NAME	UTIL1
SHEET	7
OF	9

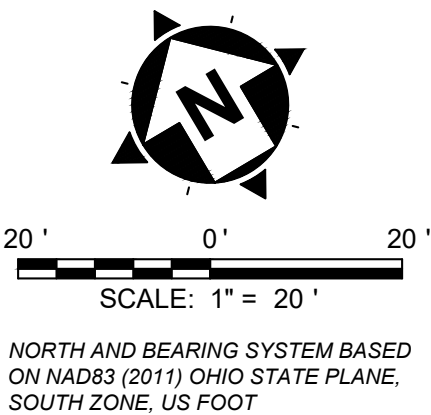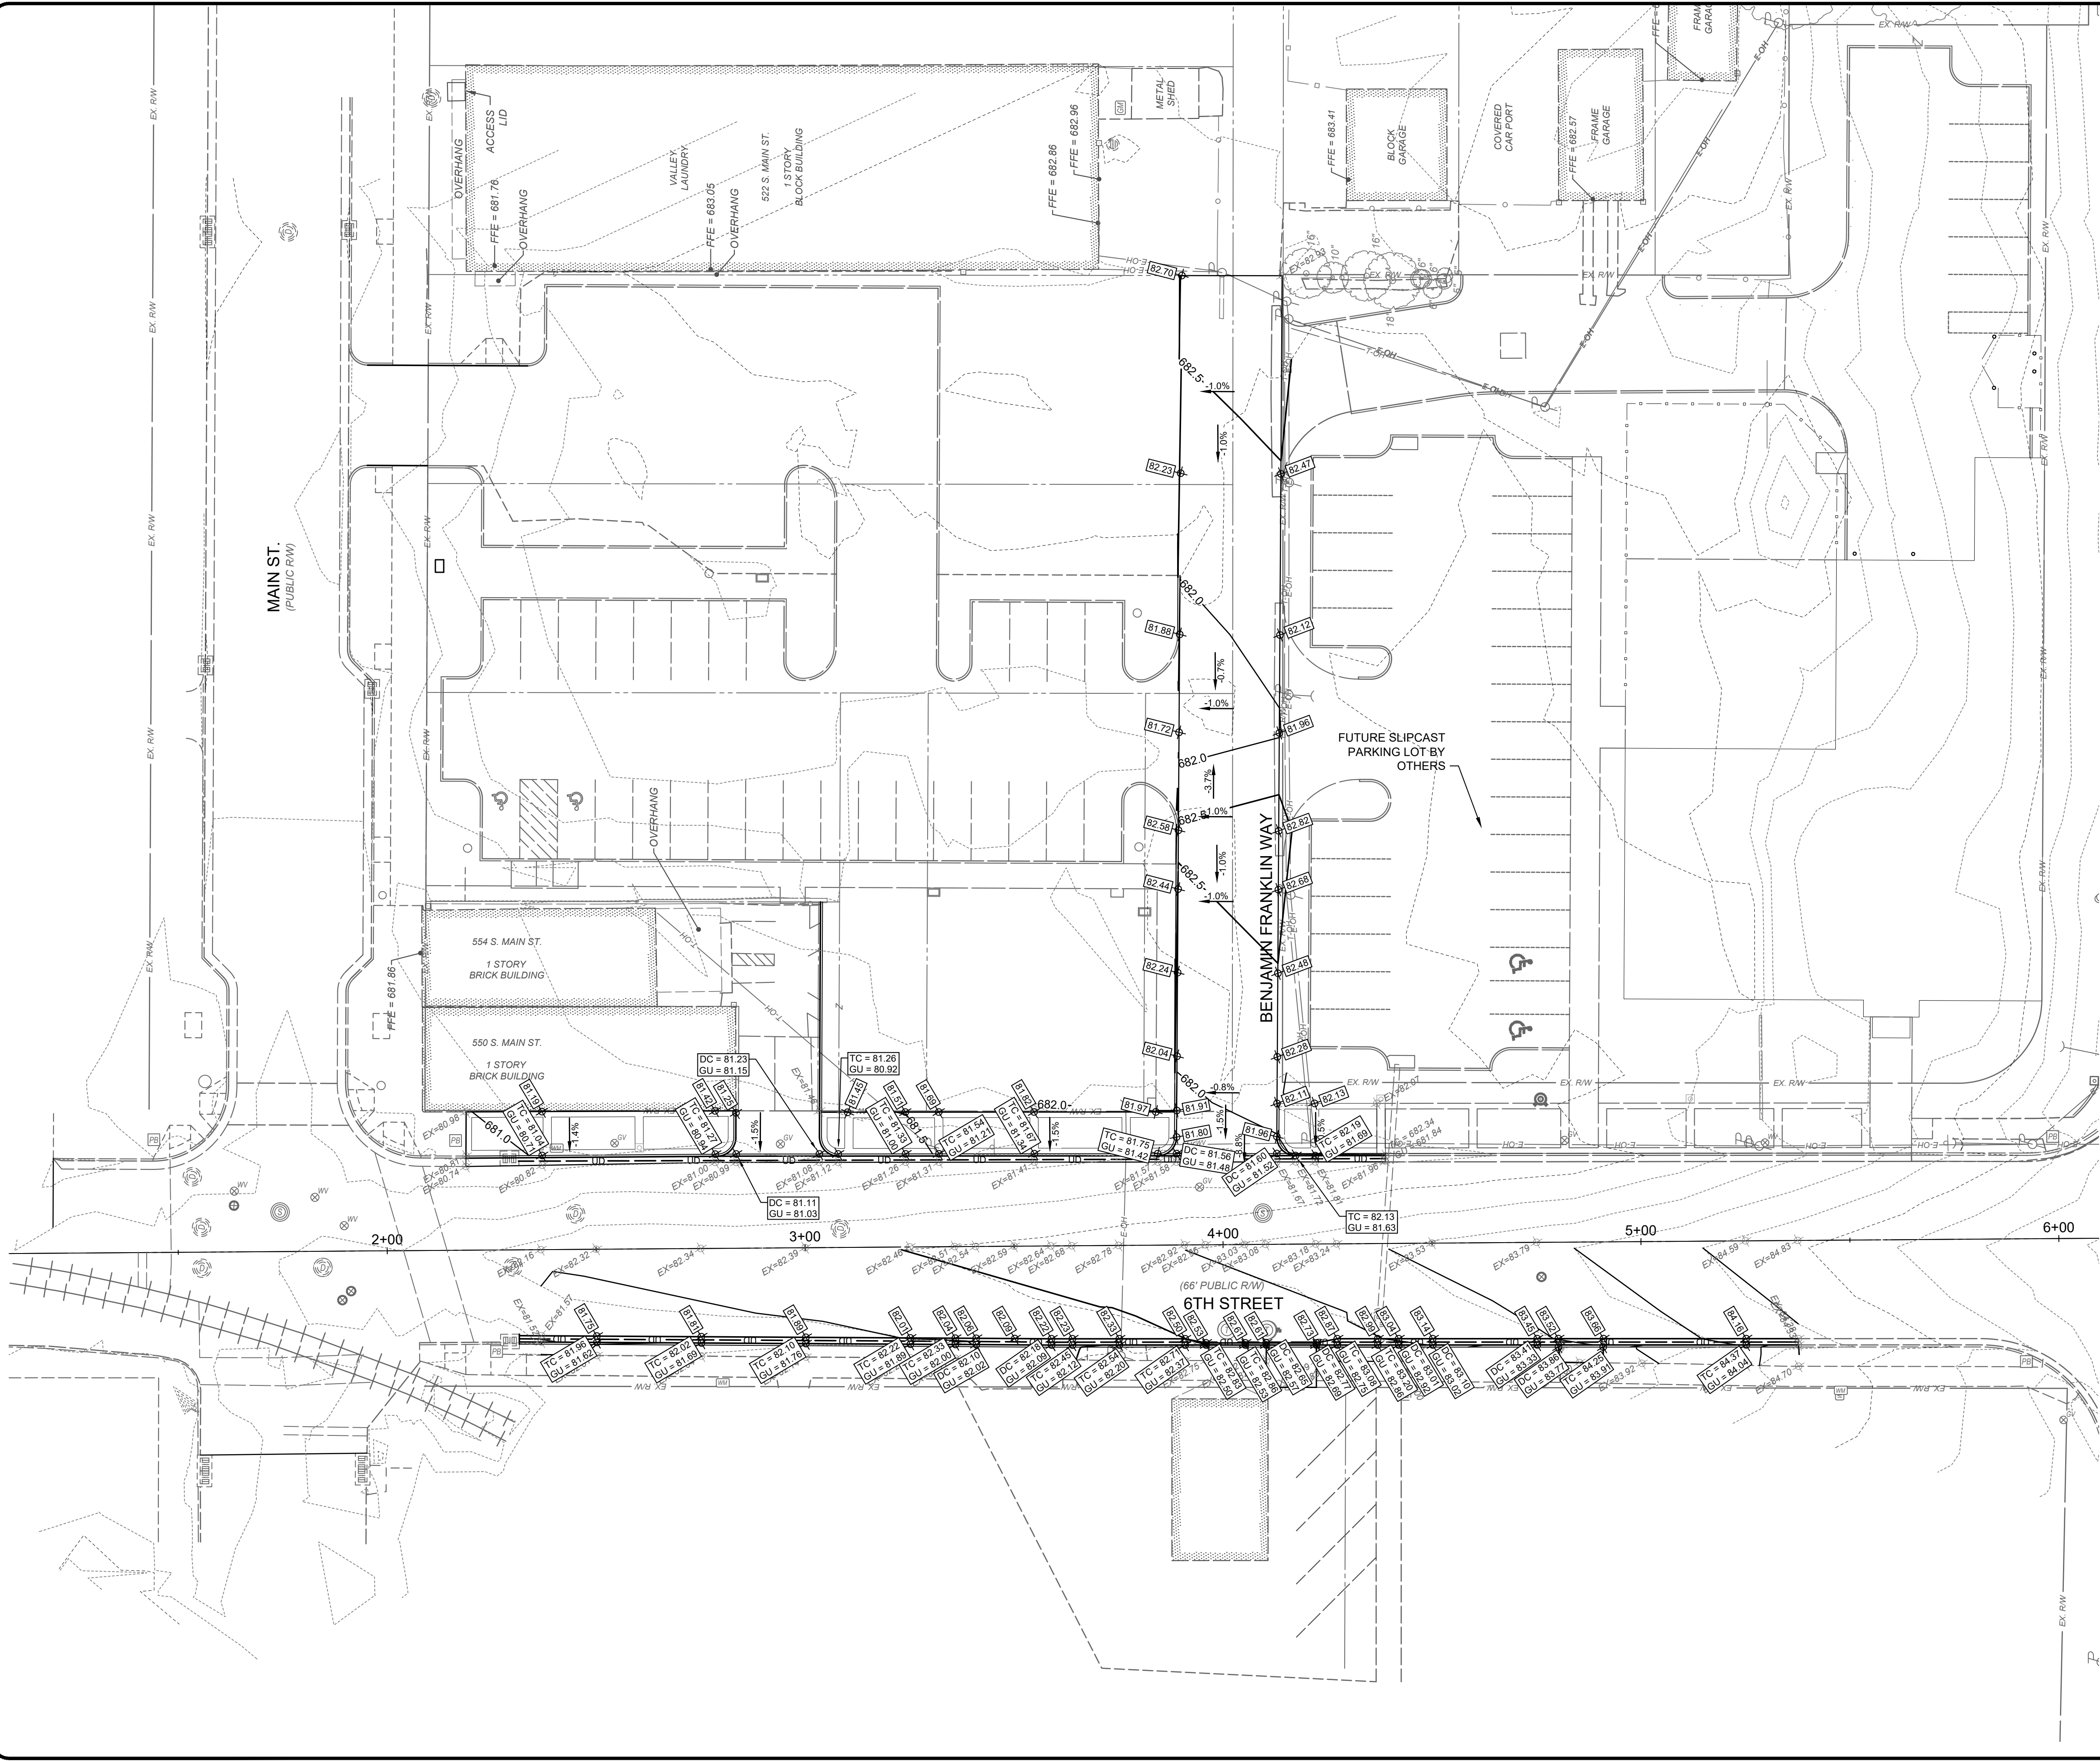


EAST 6TH STREET IMPROVEMENT PROJECT
CITY OF FRANKLIN
WARREN COUNTY, OHIO

GRADING PLAN - OVERALL


ISSUE DATE:	05/28/2026	NO	REVISION	DATE
SCALE:	AS SHOWN	△	PER ADDENDUM #2	08/07/2026
DESIGNED BY:	JHOO			
DRAWN BY:	AJAC			
CHECKED BY:	MLAC			

PROJECT NO.	43188
DISCIPLINE	CIVIL
SHEET NAME	GRAD1
SHEET	OF
8	9

verdantas

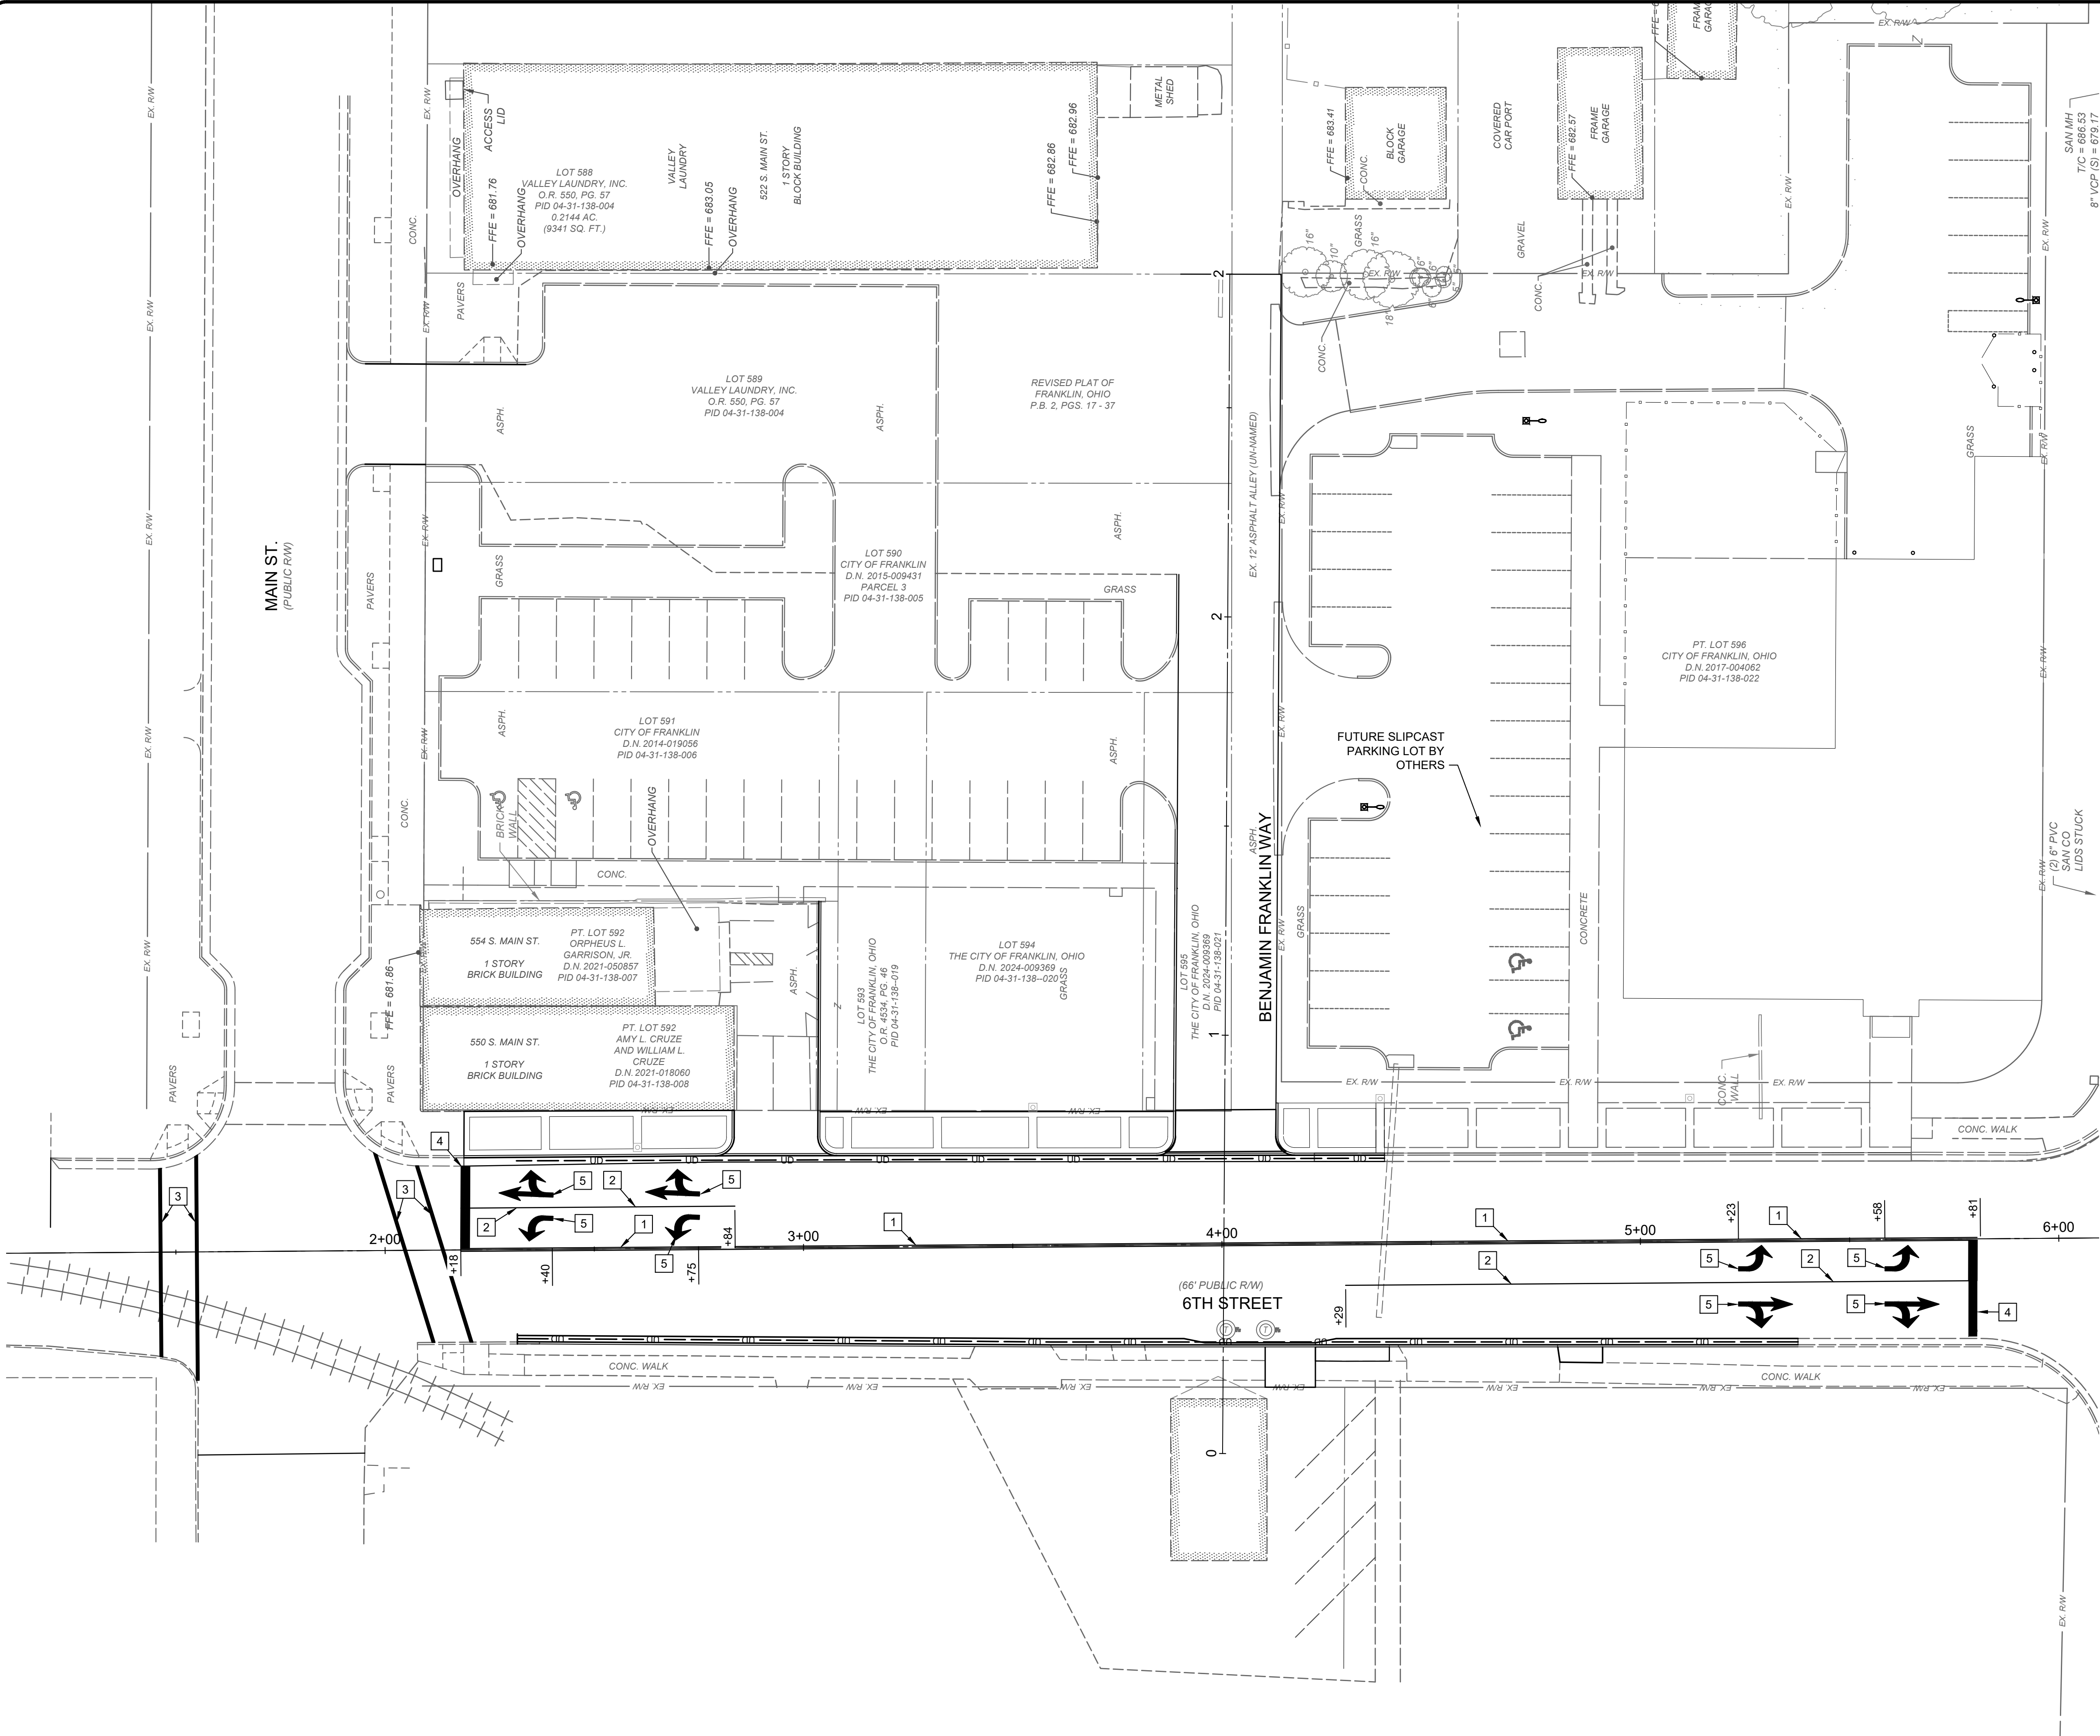

CONSTRUCTION NOTES				
1	ITEM 644 - DOUBLE YELLOW CENTERLINE			
2	ITEM 644 - 8" CHANNELIZING LINE, WHITE			
3	ITEM 644 - 12" CROSSWALK LINE, WHITE			
4	ITEM 644 - 24" STOP BAR, WHITE			
5	ITEM 644 - LANE ARROW, WHITE			

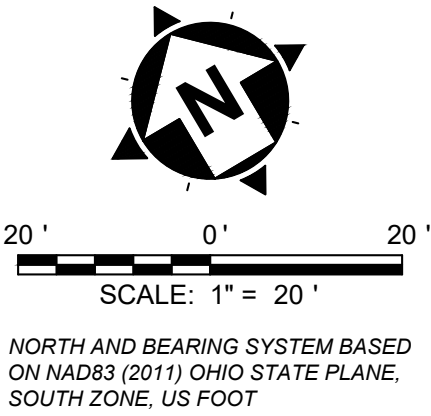

EAST 6TH STREET IMPROVEMENT PROJECT
CITY OF FRANKLIN
WARREN COUNTY, OHIO

STRIPING PLAN OVERALL

ISSUE DATE:	NO	REVISION	DATE
05/28/2026	1	PER ADDENDUM #2	08/07/2026
SCALE:			
DESIGNED BY:			
DRAWN BY:			
CHECKED BY:			

PROJECT NO.	
43188	
DISCIPLINE	
CIVIL	
SHEET NAME	
PM1	
SHEET	OF
9	9

