



To: All Plan Holders of Record

From: Verdantas LLC
For the Owner

Re: *Addendum No. 1*
Colleen Drive Part 2 Storm Improvements
Boardman Township, Ohio

Date: June 22, 2026

This Addendum forms a part of the contract documents and modifies the original bidding documents dated June 2026 and all previous addenda, if any. Acknowledge receipt of this addendum in the space provided in the bid forms. Failure to do so may subject the bidder to disqualification.

PLANS

Replace plan sheet 11/13 with the enclosed revised plan sheet 11/13


Replace plan sheet 12/13 with the enclosed revised plan sheet 12/13

Cured-in-Place Pipe Lining has been removed from the project.

MD/PB:mep


Enclosures

H:\2024\242438\SPEC\Addenda\Addendum 01\Addendum 01.Doc

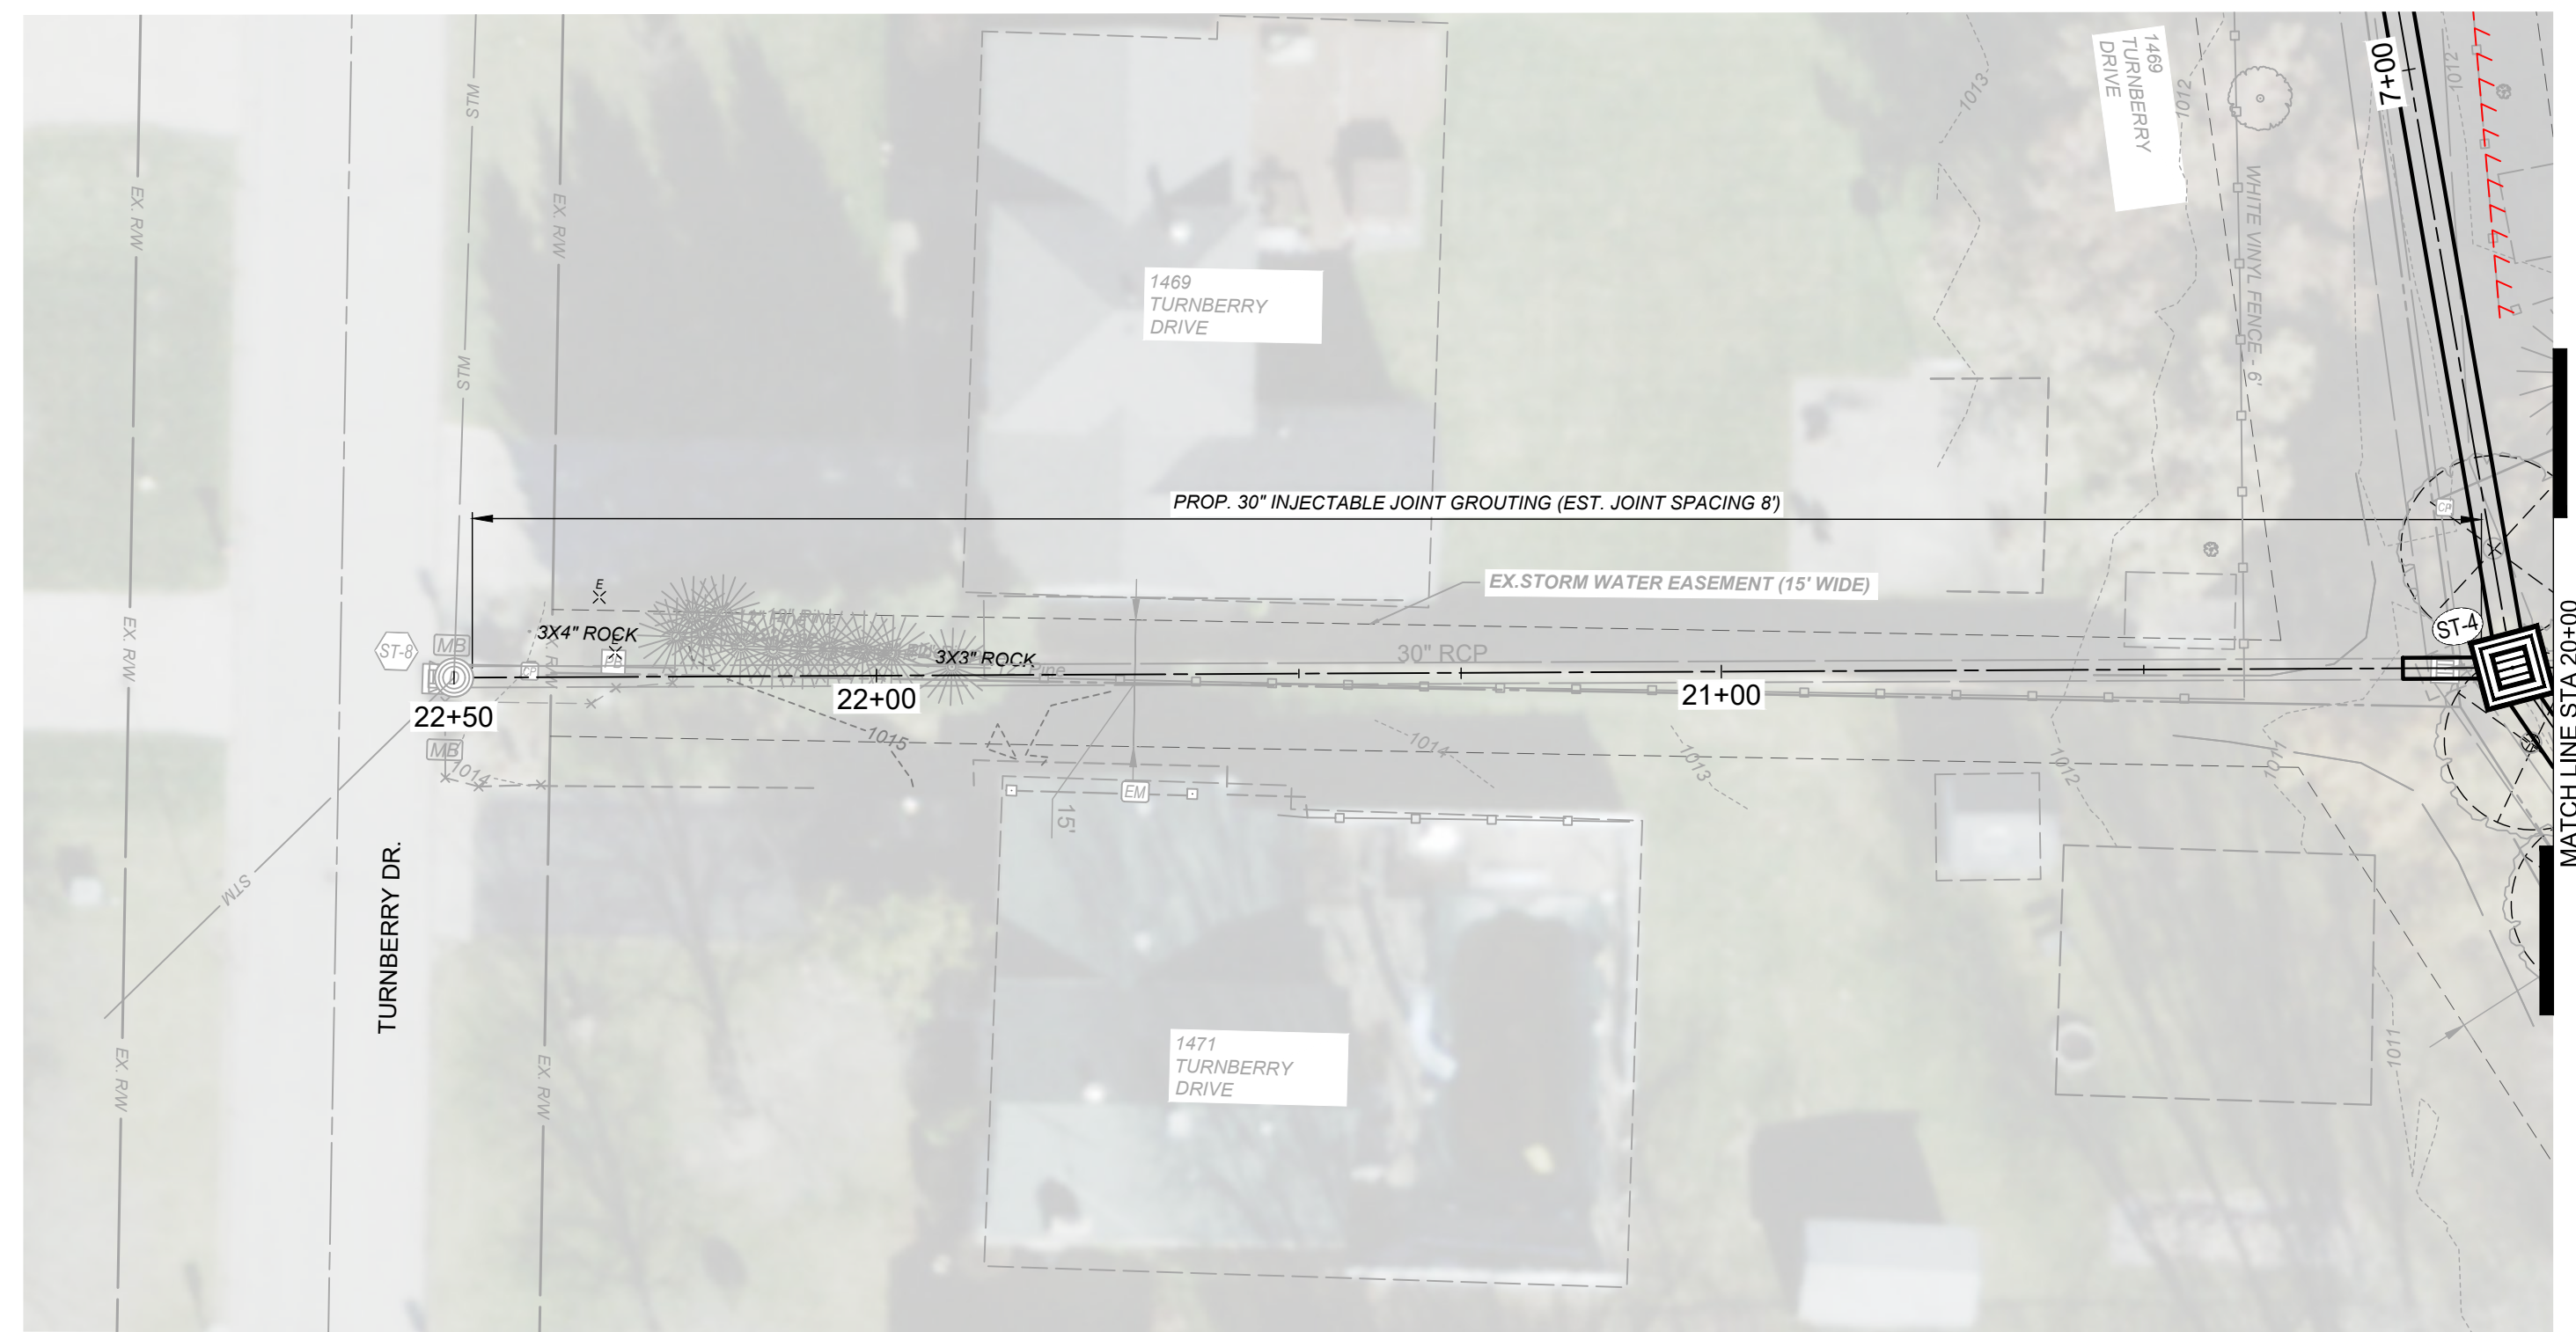

SITE GENERAL NOTES:

1. EXISTING CONDITIONS SHOWN HEREIN ARE PER TOPOGRAPHIC SURVEY PREPARED BY VERDANTAS LLC DATED DECEMBER, 2024.
2. EXISTING UNDERGROUND UTILITY ROUTING IS PER TOPOGRAPHIC SURVEY AND BEST AVAILABLE RECORD PLAN INFORMATION. CONTRACTOR IS RESPONSIBLE FOR CONFIRMING EXISTING UTILITY LOCATIONS AND DEPTHS IN THE FIELD PRIOR TO CONSTRUCTION. IN THE EVENT UTILITY LOCATION DIFFERS IN FIELD FROM PLAN, CONTRACTOR SHALL CONTACT THE DESIGN ENGINEER.
3. THE PROPOSED IMPROVEMENTS ARE INTENDED TO TIE-IN TO EXISTING, SURROUNDING GRADES AND MAINTAIN EXISTING ELEVATIONS, UNLESS OTHERWISE NOTED IN THE PLANS.
4. CONTRACTOR TO COORDINATE WITH HOMEOWNER(S) AND NOTIFY HOMEOWNER(S) OF TEMPORARY DISTURBANCES TO BE EXPECTED RESULTING FROM CONSTRUCTION, INCLUDING START DATES, AT LEAST 48 HOURS IN ADVANCE.
5. CONTRACTOR SHALL FIELD VERIFY THE LOCATION OF EXISTING SEWER PIPES AND PROVIDE REQUIRED MEANS AND MATERIALS TO CONNECT THE EXISTING STORM SEWER PIPES TO THE NEW STRUCTURES WHERE INDICATED.
6. FLOW CONTROL AND BYPASS PUMPING DURING THE DURATION OF THE PROJECT IS THE RESPONSIBILITY OF THE CONTRACTOR. REFER TO SEWER FLOW CONTROL SPEC IN DIVISION 33.
7. EXISTING ARMSTRONG CABLE UNDERGROUND CONDUITS AND PEDESTALS ARE SHOWN PER AVAILABLE UTILITY RECORDS. ARMSTRONG IS SCHEDULED TO RELOCATE THE PEDESTALS AND BURIED CONDUIT OUTSIDE OF THE EASEMENT TO FACILITATE THE STORM SEWER WORK. CONTRACTOR SHALL COORDINATE WITH ARMSTRONG CABLE BEFORE START OF STORM SEWER WORK TO CONFIRM CABLE HAS BEEN RELOCATED.

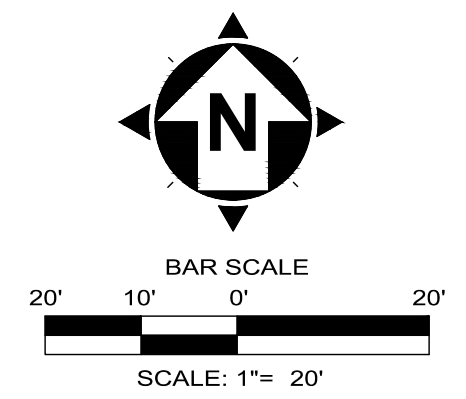

verdantas

SCALE:	NONE	NO	REVISION	DATE
DATE:	2/27/2025	1	PER ADDENDUM 01	06/22/26
DESIGNED BY:	MMB			
DRAWN BY:	MMB			
CHECKED BY:	PAB			


COLLEEN DRIVE STORM
IMPROVEMENTS: PART II



MAHONING COUNTY
BOARDMAN, OHIO

PLAN & PROFILE

STA. 22+00 TO STA. 22+50



PROJECT NO:	
242438	
DRAWING NAME	
C-11	
SHEET	OF
11	13

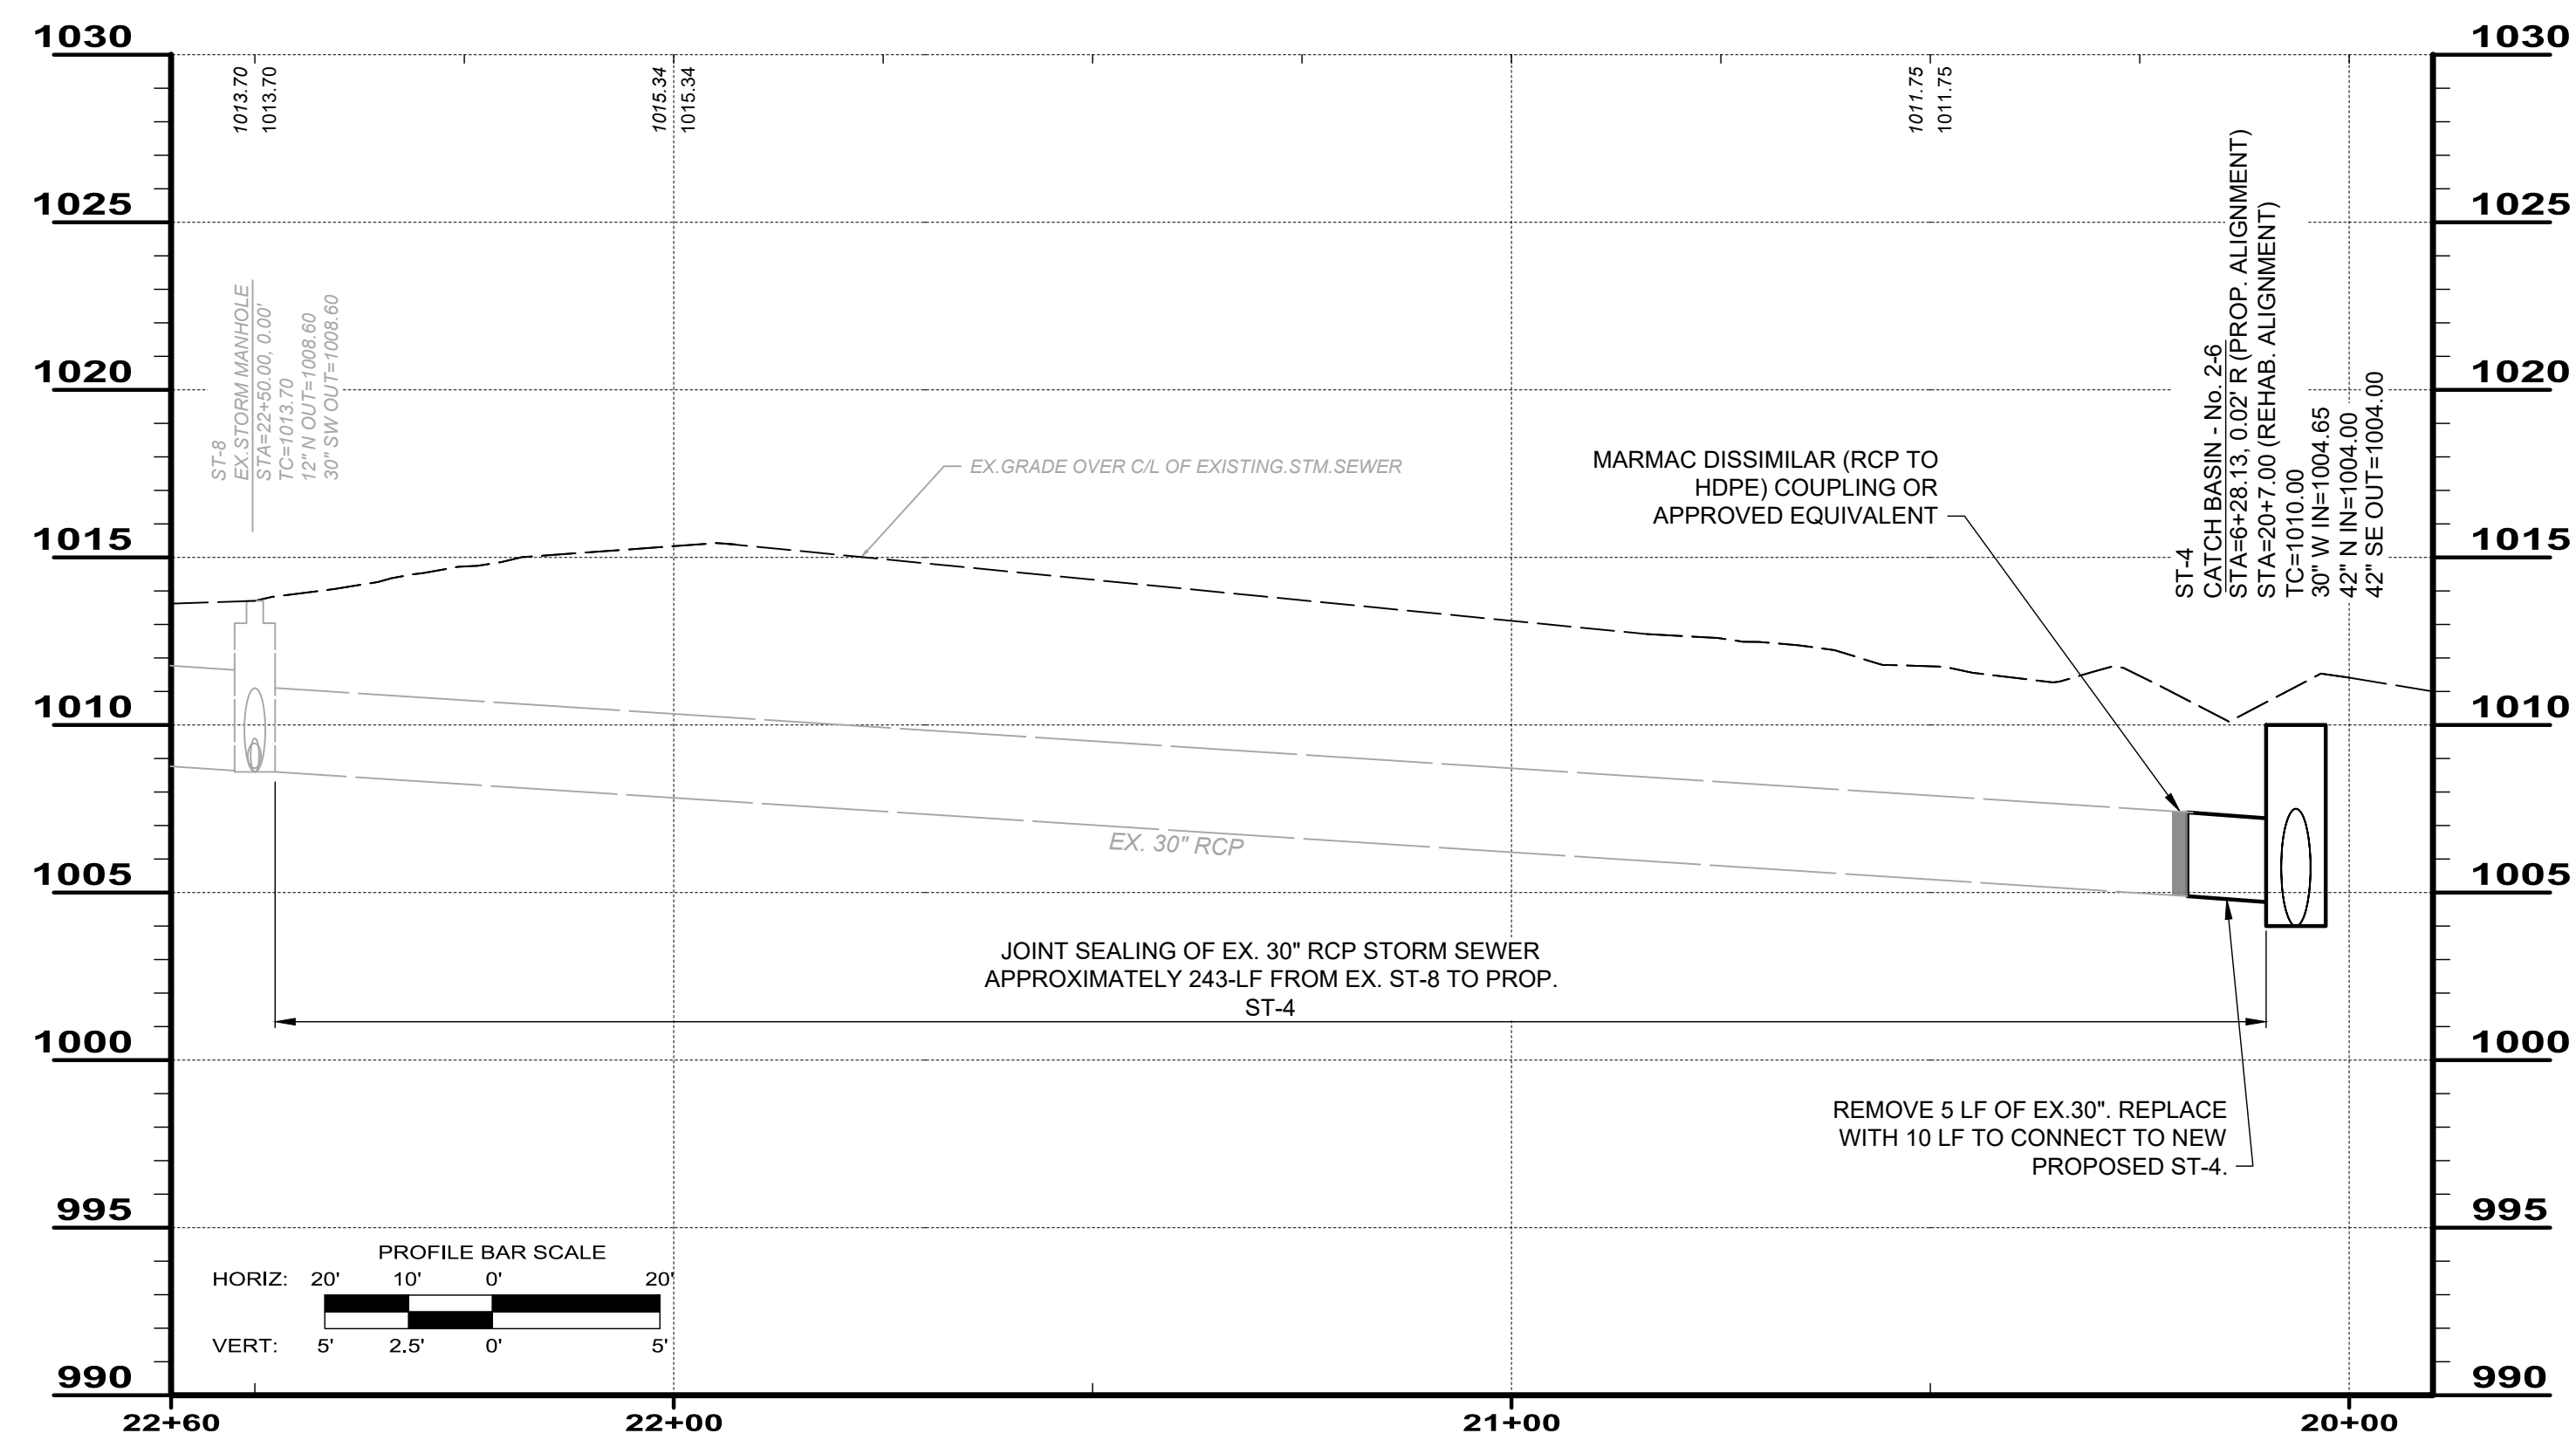

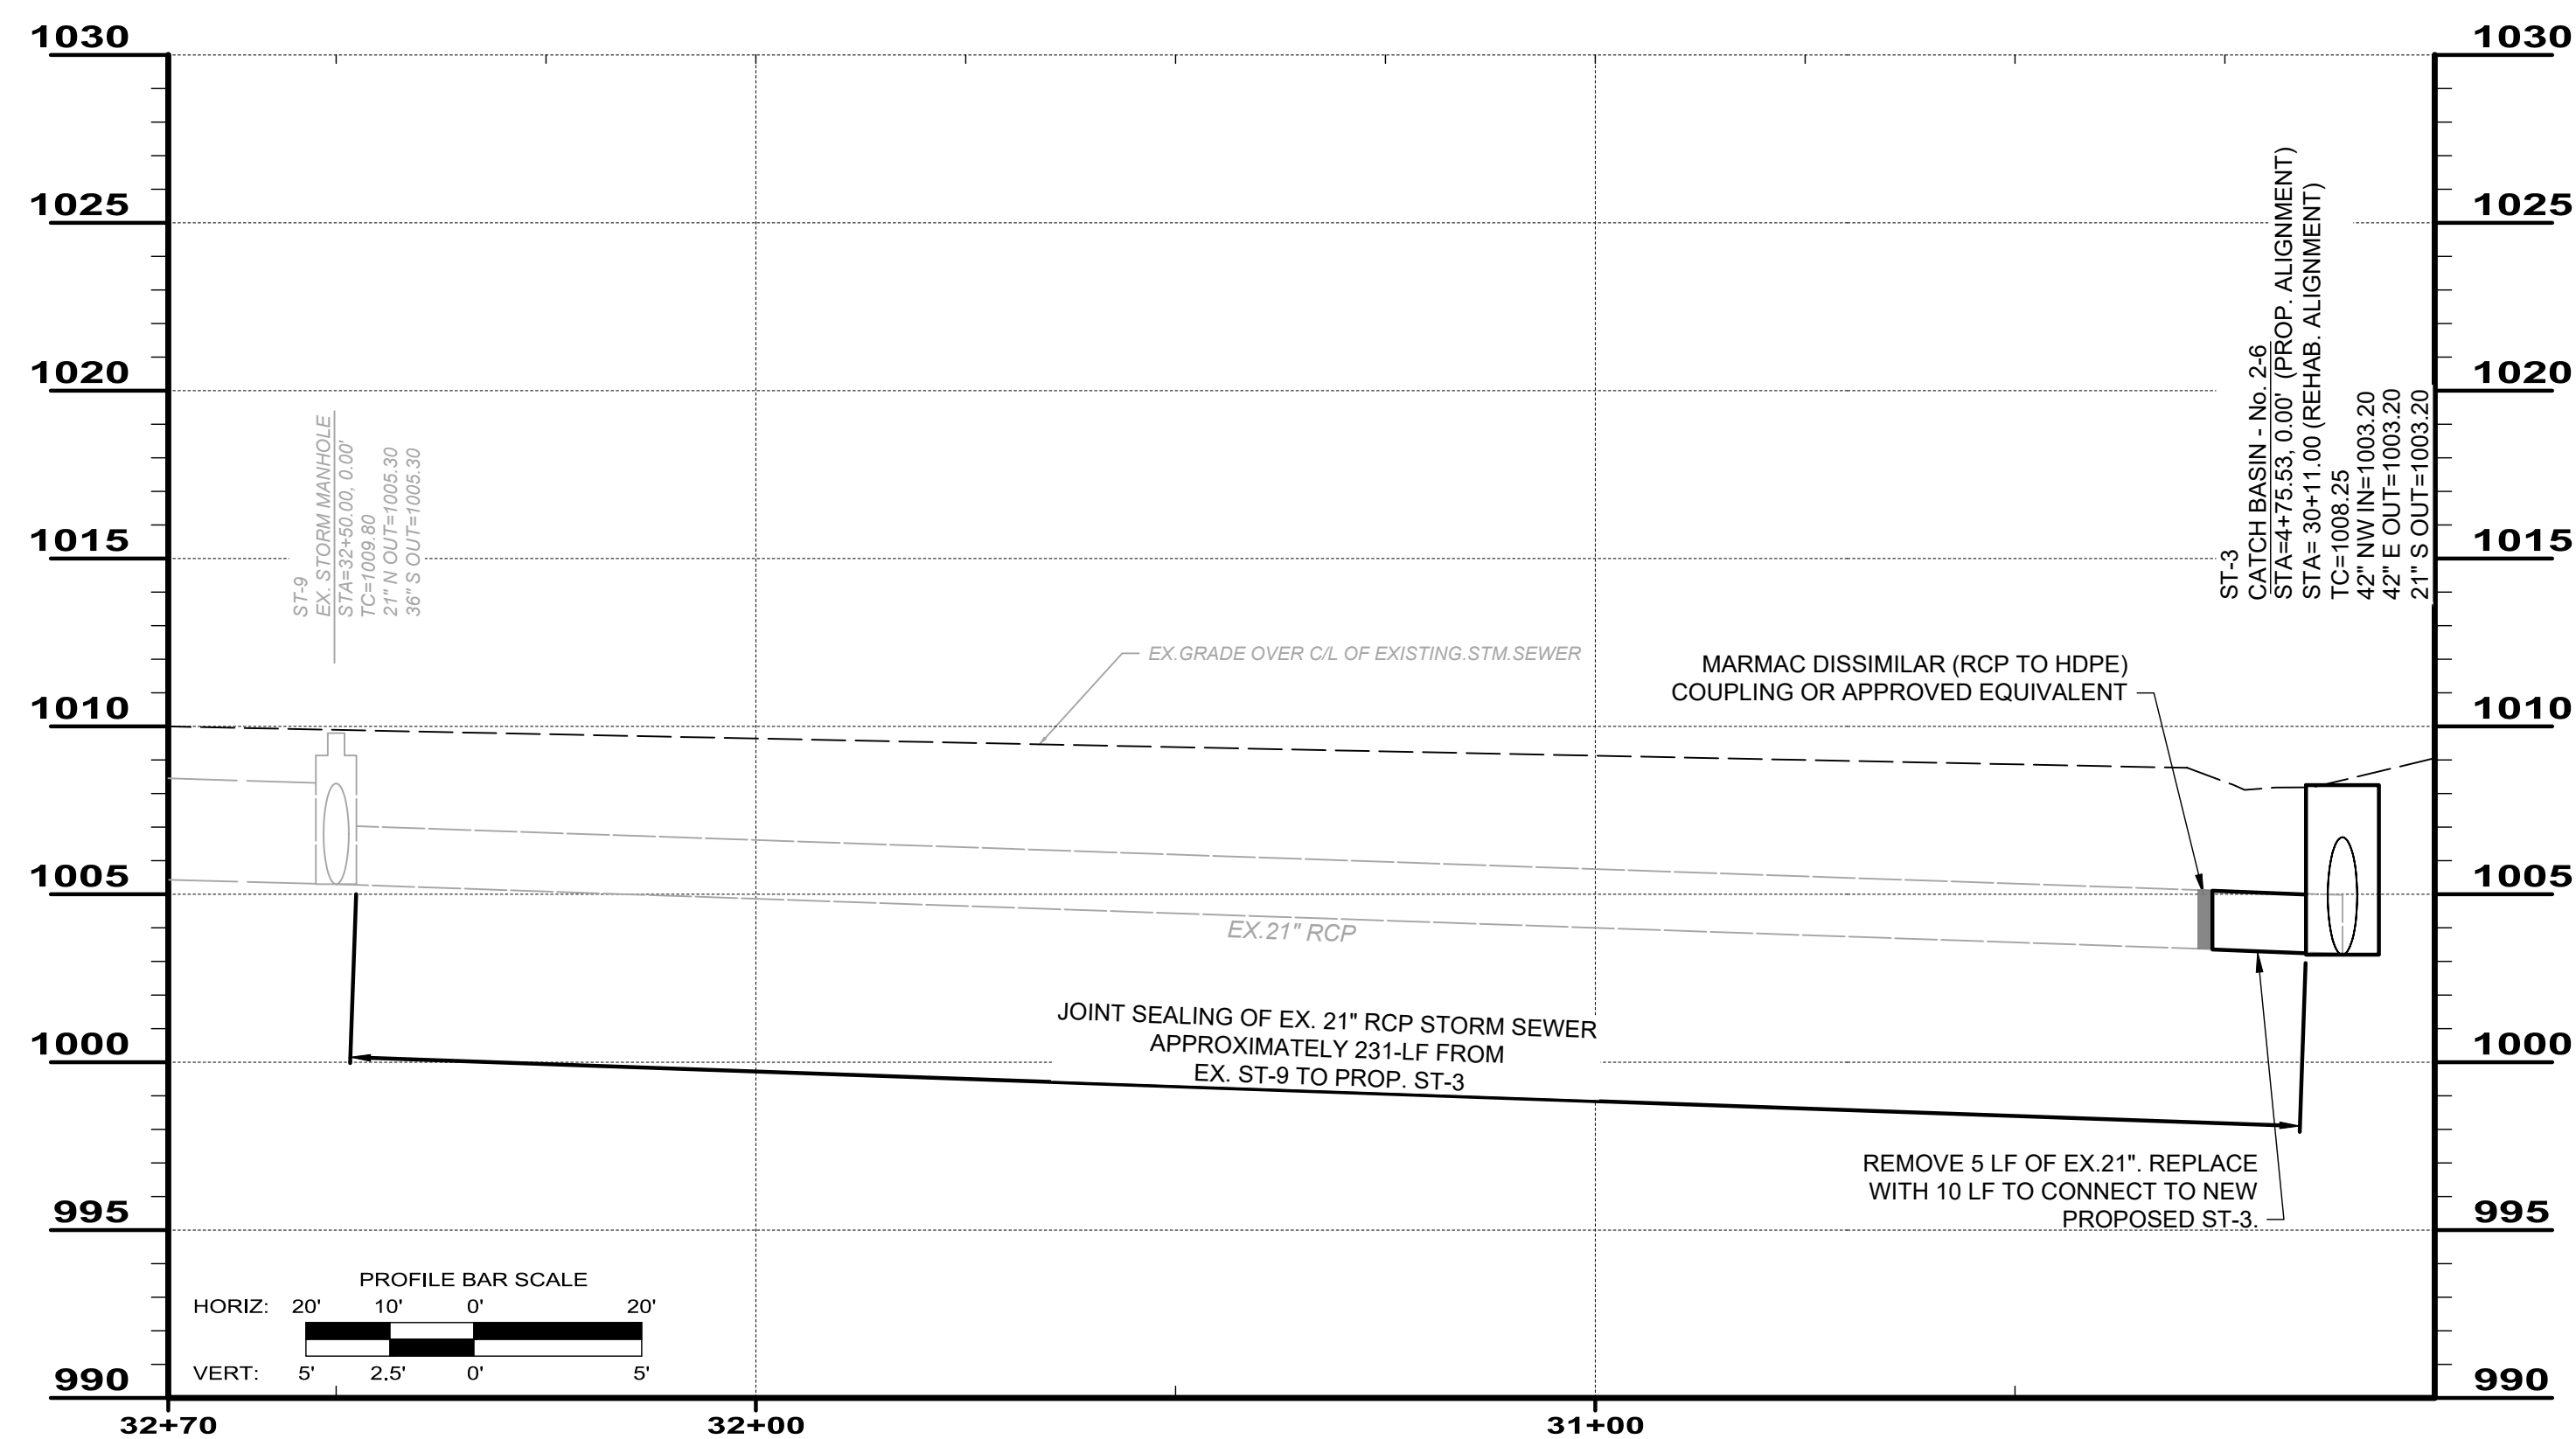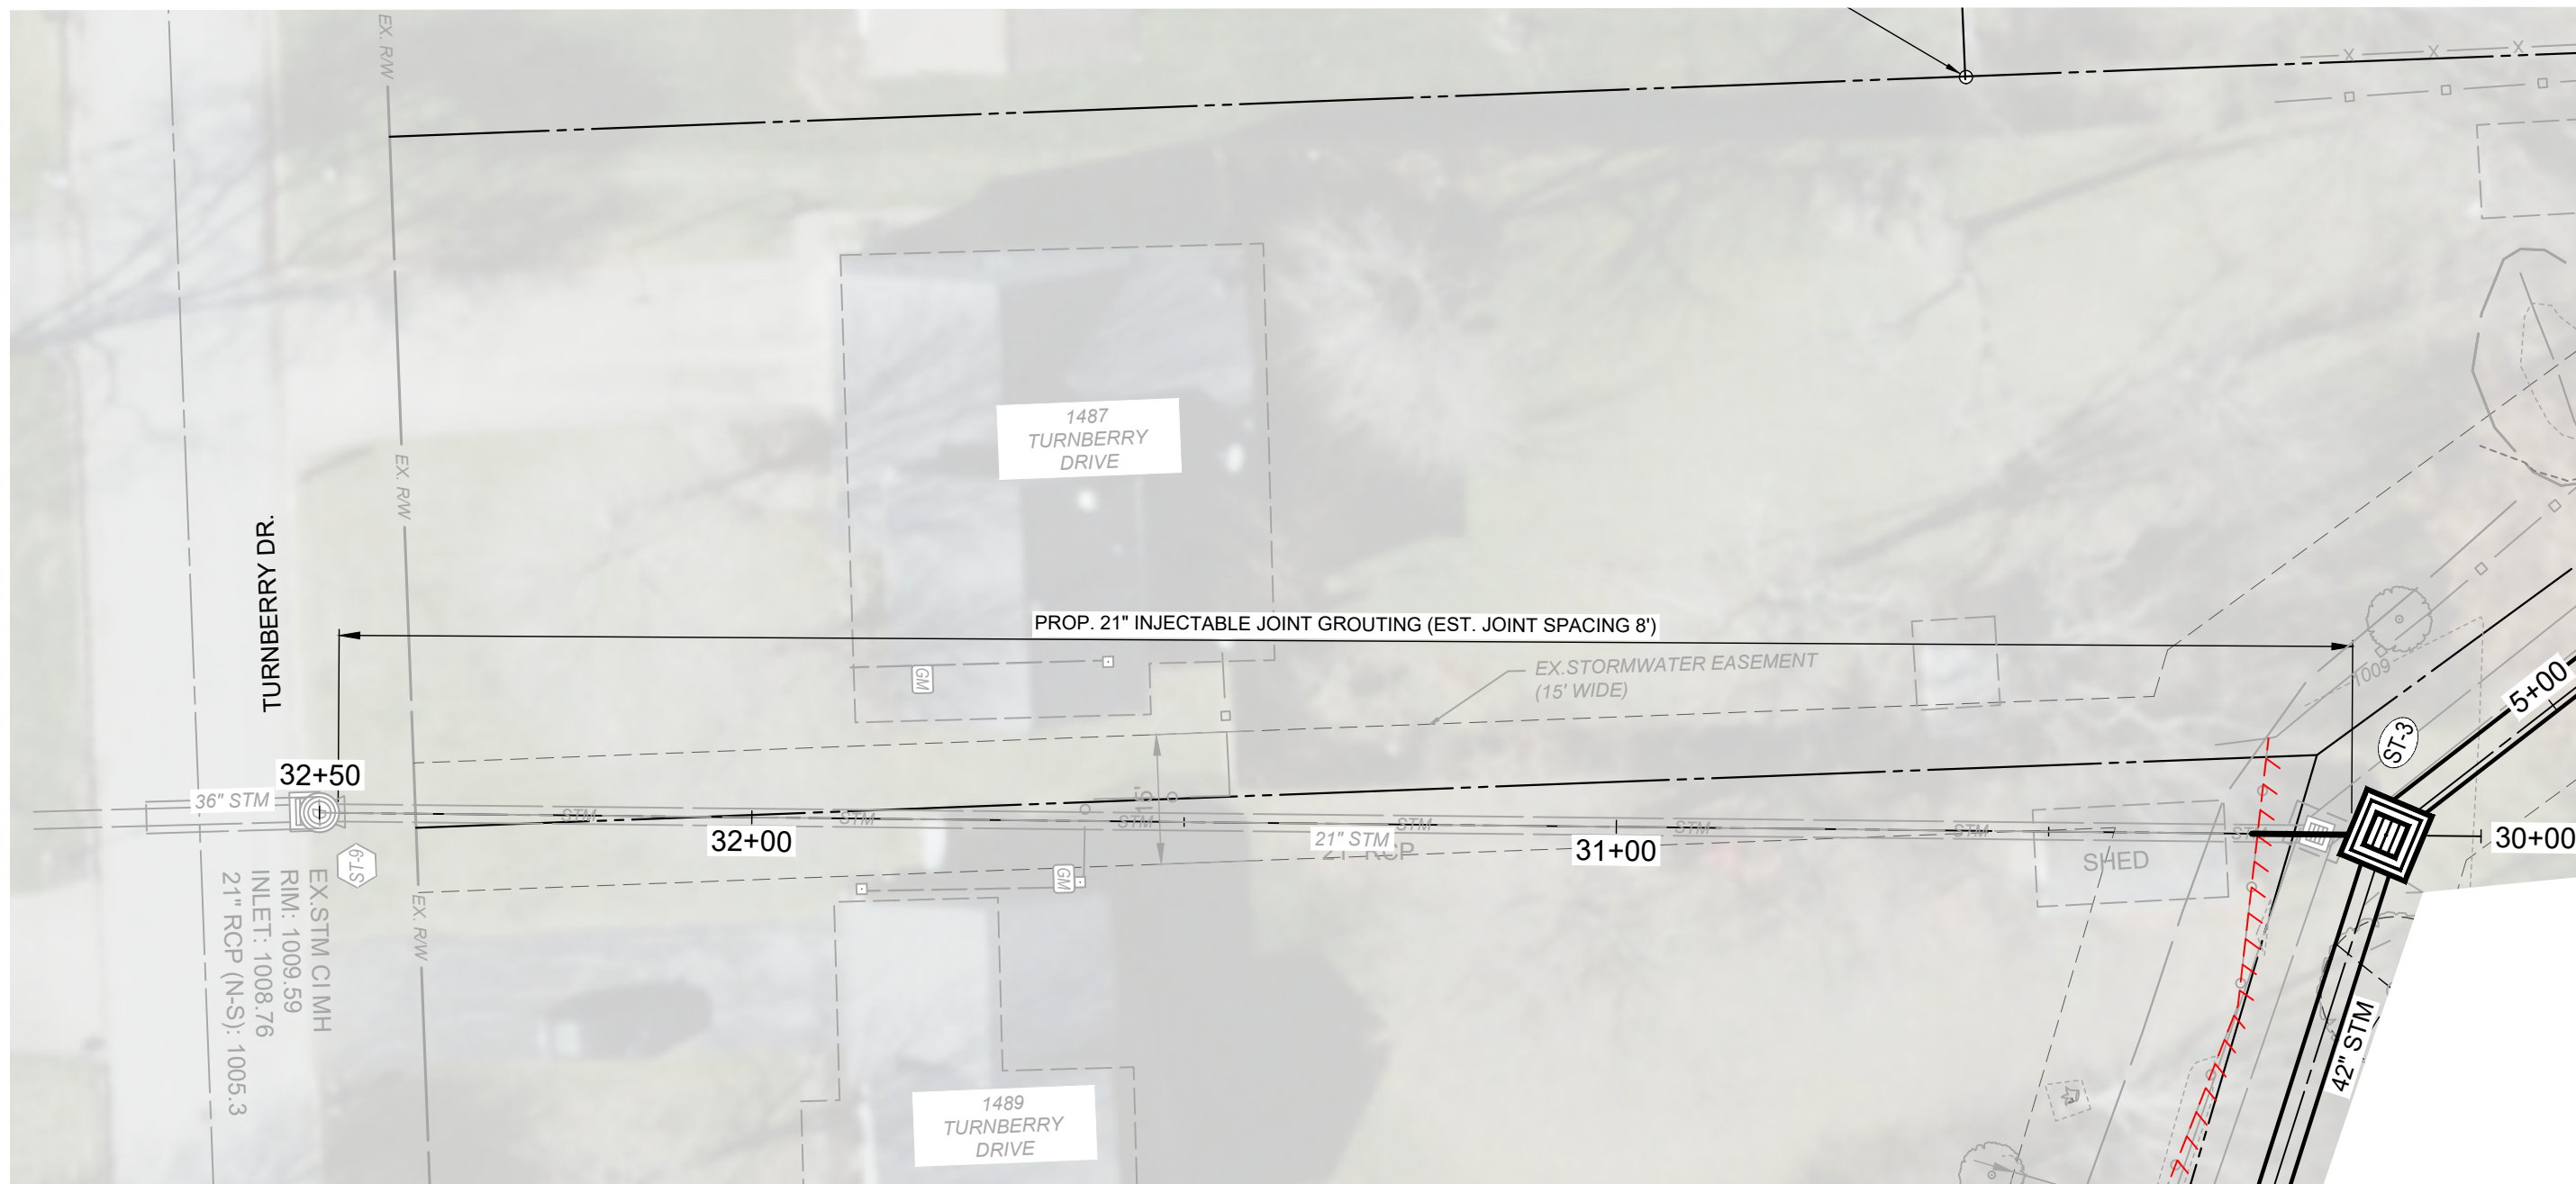

SITE GENERAL NOTES:

1. EXISTING CONDITIONS SHOWN HEREIN ARE PER TOPOGRAPHIC SURVEY PREPARED BY VERDANTAS LLC DATED DECEMBER, 2024.
2. EXISTING UNDERGROUND UTILITY ROUTING IS PER TOPOGRAPHIC SURVEY AND BEST AVAILABLE RECORD PLAN INFORMATION. CONTRACTOR IS RESPONSIBLE FOR CONFIRMING EXISTING UTILITY LOCATIONS AND DEPTHS IN THE FIELD PRIOR TO CONSTRUCTION. IN THE EVENT UTILITY LOCATION DIFFERS IN FIELD FROM PLAN, CONTRACTOR SHALL CONTACT THE DESIGN ENGINEER.
3. THE PROPOSED IMPROVEMENTS ARE INTENDED TO TIE-IN TO EXISTING, SURROUNDING GRADES AND MAINTAIN EXISTING ELEVATIONS, UNLESS OTHERWISE NOTED IN THE PLANS.
4. CONTRACTOR TO COORDINATE WITH HOMEOWNER(S) AND NOTIFY HOMEOWNER(S) OF TEMPORARY DISTURBANCES TO BE EXPECTED RESULTING FROM CONSTRUCTION, INCLUDING START DATES, AT LEAST 48 HOURS IN ADVANCE.
5. CONTRACTOR SHALL FIELD VERIFY THE LOCATION OF EXISTING SEWER PIPES AND PROVIDE REQUIRED MEANS AND MATERIALS TO CONNECT THE EXISTING STORM SEWER PIPES TO THE NEW STRUCTURES WHERE INDICATED.
6. FLOW CONTROL AND BYPASS PUMPING DURING THE DURATION OF THE PROJECT IS THE RESPONSIBILITY OF THE CONTRACTOR. REFER TO SEWER FLOW CONTROL SPEC IN DIVISION 33.
7. EXISTING ARMSTRONG CABLE UNDERGROUND CONDUITS AND PEDESTALS ARE SHOWN PER AVAILABLE UTILITY RECORDS. ARMSTRONG IS SCHEDULED TO RELOCATE THE PEDESTALS AND BURIED CONDUIT OUTSIDE OF THE EASEMENT TO FACILITATE THE STORM SEWER WORK. CONTRACTOR SHALL COORDINATE WITH ARMSTRONG CABLE BEFORE START OF STORM SEWER WORK TO CONFIRM CABLE HAS BEEN RELOCATED.

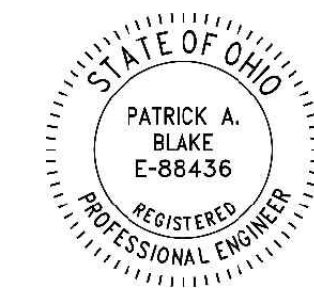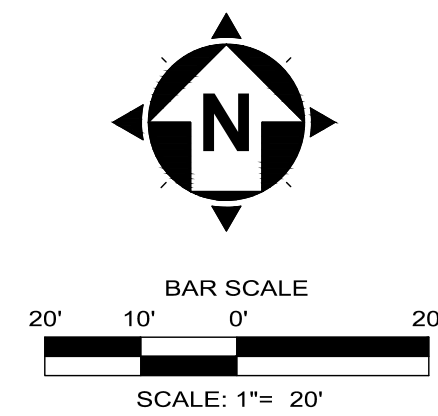

verdantas

SCALE:	NO	REVISION	DATE
DATE:	1	PER ADDENDUM 01	06/22/26
DESIGNED BY:			
DRAWN BY:			
CHECKED BY:			

**COLLEEN DRIVE STORM
IMPROVEMENTS: PART II**

MAHONING COUNTY BOARDMAN, OHIO

PLAN & PROFILE

STA. 30+00 TO STA. 32+50

PROJECT NO:

242438

DRAWING NAME

C-12

SHEET	OF
--------------	-----------

12	13
----	----