



To: All Plan Holders of Record

From: Verdantas LLC
For the Owner

Re: Addendum No. 2
Colleen Drive Part 2 Storm Improvements
Boardman Township, Ohio

Date: June 24, 2026

This Addendum forms a part of the contract documents and modifies the original bidding documents dated June 2026 and all previous addenda, if any. Acknowledge receipt of this addendum in the space provided in the bid forms. Failure to do so may subject the bidder to disqualification.

QUESTIONS AND ANSWERS

Q1. Is there a detail for the asphalt in the roadway on this project?

A1. See enclosed Type 'C' Pavement Replacement (Asphalt), Roadway detail.

Q2 Just to clarify, there is no dirt backfill permitted even in the grass areas? This is per Note 2 under the Excavation Backfill and Compaction section in the plans.

A2. Note 2 Under the Excavation Backfill and Compaction Section is Intended for the Initial Backfill. On-site Material can be used for the Final Backfill per the backfill detail.

Q3 Is the contractor responsible for the reinstalment of structures removed like bocce court, batting cages sheds, fences etc.

A3. No, per discussions with the Owner, Contractor will not be responsible to reinstall the structures that are removed out of the existing stormwater easement.

Q4 If a shed is deemed not to be able to be moved without being destroyed due to age, who is responsible for replacement?

A4. The homeowners have been notified by letter of the upcoming work and possible impacts to their structures and trees within the easement. They have been instructed to remove their structures from the easement or Boardman Township's contractor will remove them, without compensation or replacement to the homeowner.

Q5. On Sheet 12, a 21" HDPE pipe is specified, but this size is not available in HDPE. Should RCP be used instead?

A5. No, we have revised the plans to use a 24" HDPE pipe and include a note requiring concrete encasement at the coupling.

BID DOCUMENTS

Revise Prices to Include, Page BD.15, Part 2.17 to read 24" STORM SEWER, AS PER PLAN

BID FORMS

Replace Bid Form, Page BF.9, with the enclosed Bid Form, Page BF.9A.

PLANS

Replace plan sheet 11/13 from Addendum 1 with the enclosed revised plan sheet 11/13

Replace plan sheet 12/13 from Addendum 1 with the enclosed revised plan sheet 12/13

MD/PB/MG:mep


Enclosures

H:\2024\242438\SPEC\Addenda\Addendum 02\Addendum 02.Doc

Proposal to Boardman Township
 For Colleen Drive Part 2 Storm Improvements


Project No. 242438

REF. NO.	DESCRIPTION	QTY.	MEASURE UNITS	UNIT PRICE LABOR	UNIT PRICE MATERIAL	TOTAL UNIT PRICE	ITEM TOTAL
23	(SPC) 6 INCH DIAMETER & SMALLER SEWER & DRAIN REPAIR OR REPLACEMENT, CONTINGENCY	20.00	FT	\$	\$	\$	\$
24	(611) 12" STORM SEWER, AS PER PLAN	25.00	FT	\$	\$	\$	\$
25	(611) 24" STORM SEWER, AS PER PLAN	10.00	FT	\$	\$	\$	\$
26	(611) 30" STORM SEWER, AS PER PLAN	10.00	FT	\$	\$	\$	\$
27	(611) 36" CONDUIT, TYPE B, AS PER PLAN	600.00	FT	\$	\$	\$	\$
28	(611) 42" CONDUIT, TYPE B, AS PER PLAN	24.00	FT	\$	\$	\$	\$
29	(611) 42" STORM SEWER, AS PER PLAN	815.00	FT	\$	\$	\$	\$
30	(611) CONDUIT, MISC.: CONNECTION TO EXISTING PIPE	5.00	EACH	\$	\$	\$	\$
31	(611) 27 INCH - 36 INCH CONDUIT INTERNAL TELEVISION INSPECTION, INCLUDING LIGHT CLEANING, AS PER PLAN	600.00	FT	\$	\$	\$	\$
32	(611) 42 INCH - 60 INCH CONDUIT INTERNAL TELEVISION INSPECTION, INCLUDING LIGHT CLEANING, AS PER PLAN	815.00	FT	\$	\$	\$	\$
33	(611) CATCH BASIN, NO. 2-6, AS PER PLAN	4.00	EACH	\$	\$	\$	\$
34	(611) INLET, YARD DRAIN, AS PER PLAN	6.00	EACH	\$	\$	\$	\$
35	(611) 72 INCH STORM MANHOLE, AS PER PLAN	1.00	EACH	\$	\$	\$	\$
36	(611) JUNCTION CHAMBER, AS PER PLAN	2.00	EACH	\$	\$	\$	\$
37	(614) MAINTAINING TRAFFIC	1.00	LS	\$	\$	\$	\$
38	(624) MOBILIZATION	1.00	LS	\$	\$	\$	\$
39	(624) CONSTRUCTION ENTRANCE, AS PER PLAN	35.00	SY	\$	\$	\$	\$
40	(SPC) LAWN RESTORATION (GRADING, SEEDING, & MULCHING)	1.00	LS	\$	\$	\$	\$
41	(SPC) TEMPORARY SEDIMENT AND EROSION CONTROL, AS PER PLAN	1.00	LS	\$	\$	\$	\$
INFORMAL TOTAL BID						\$	\$

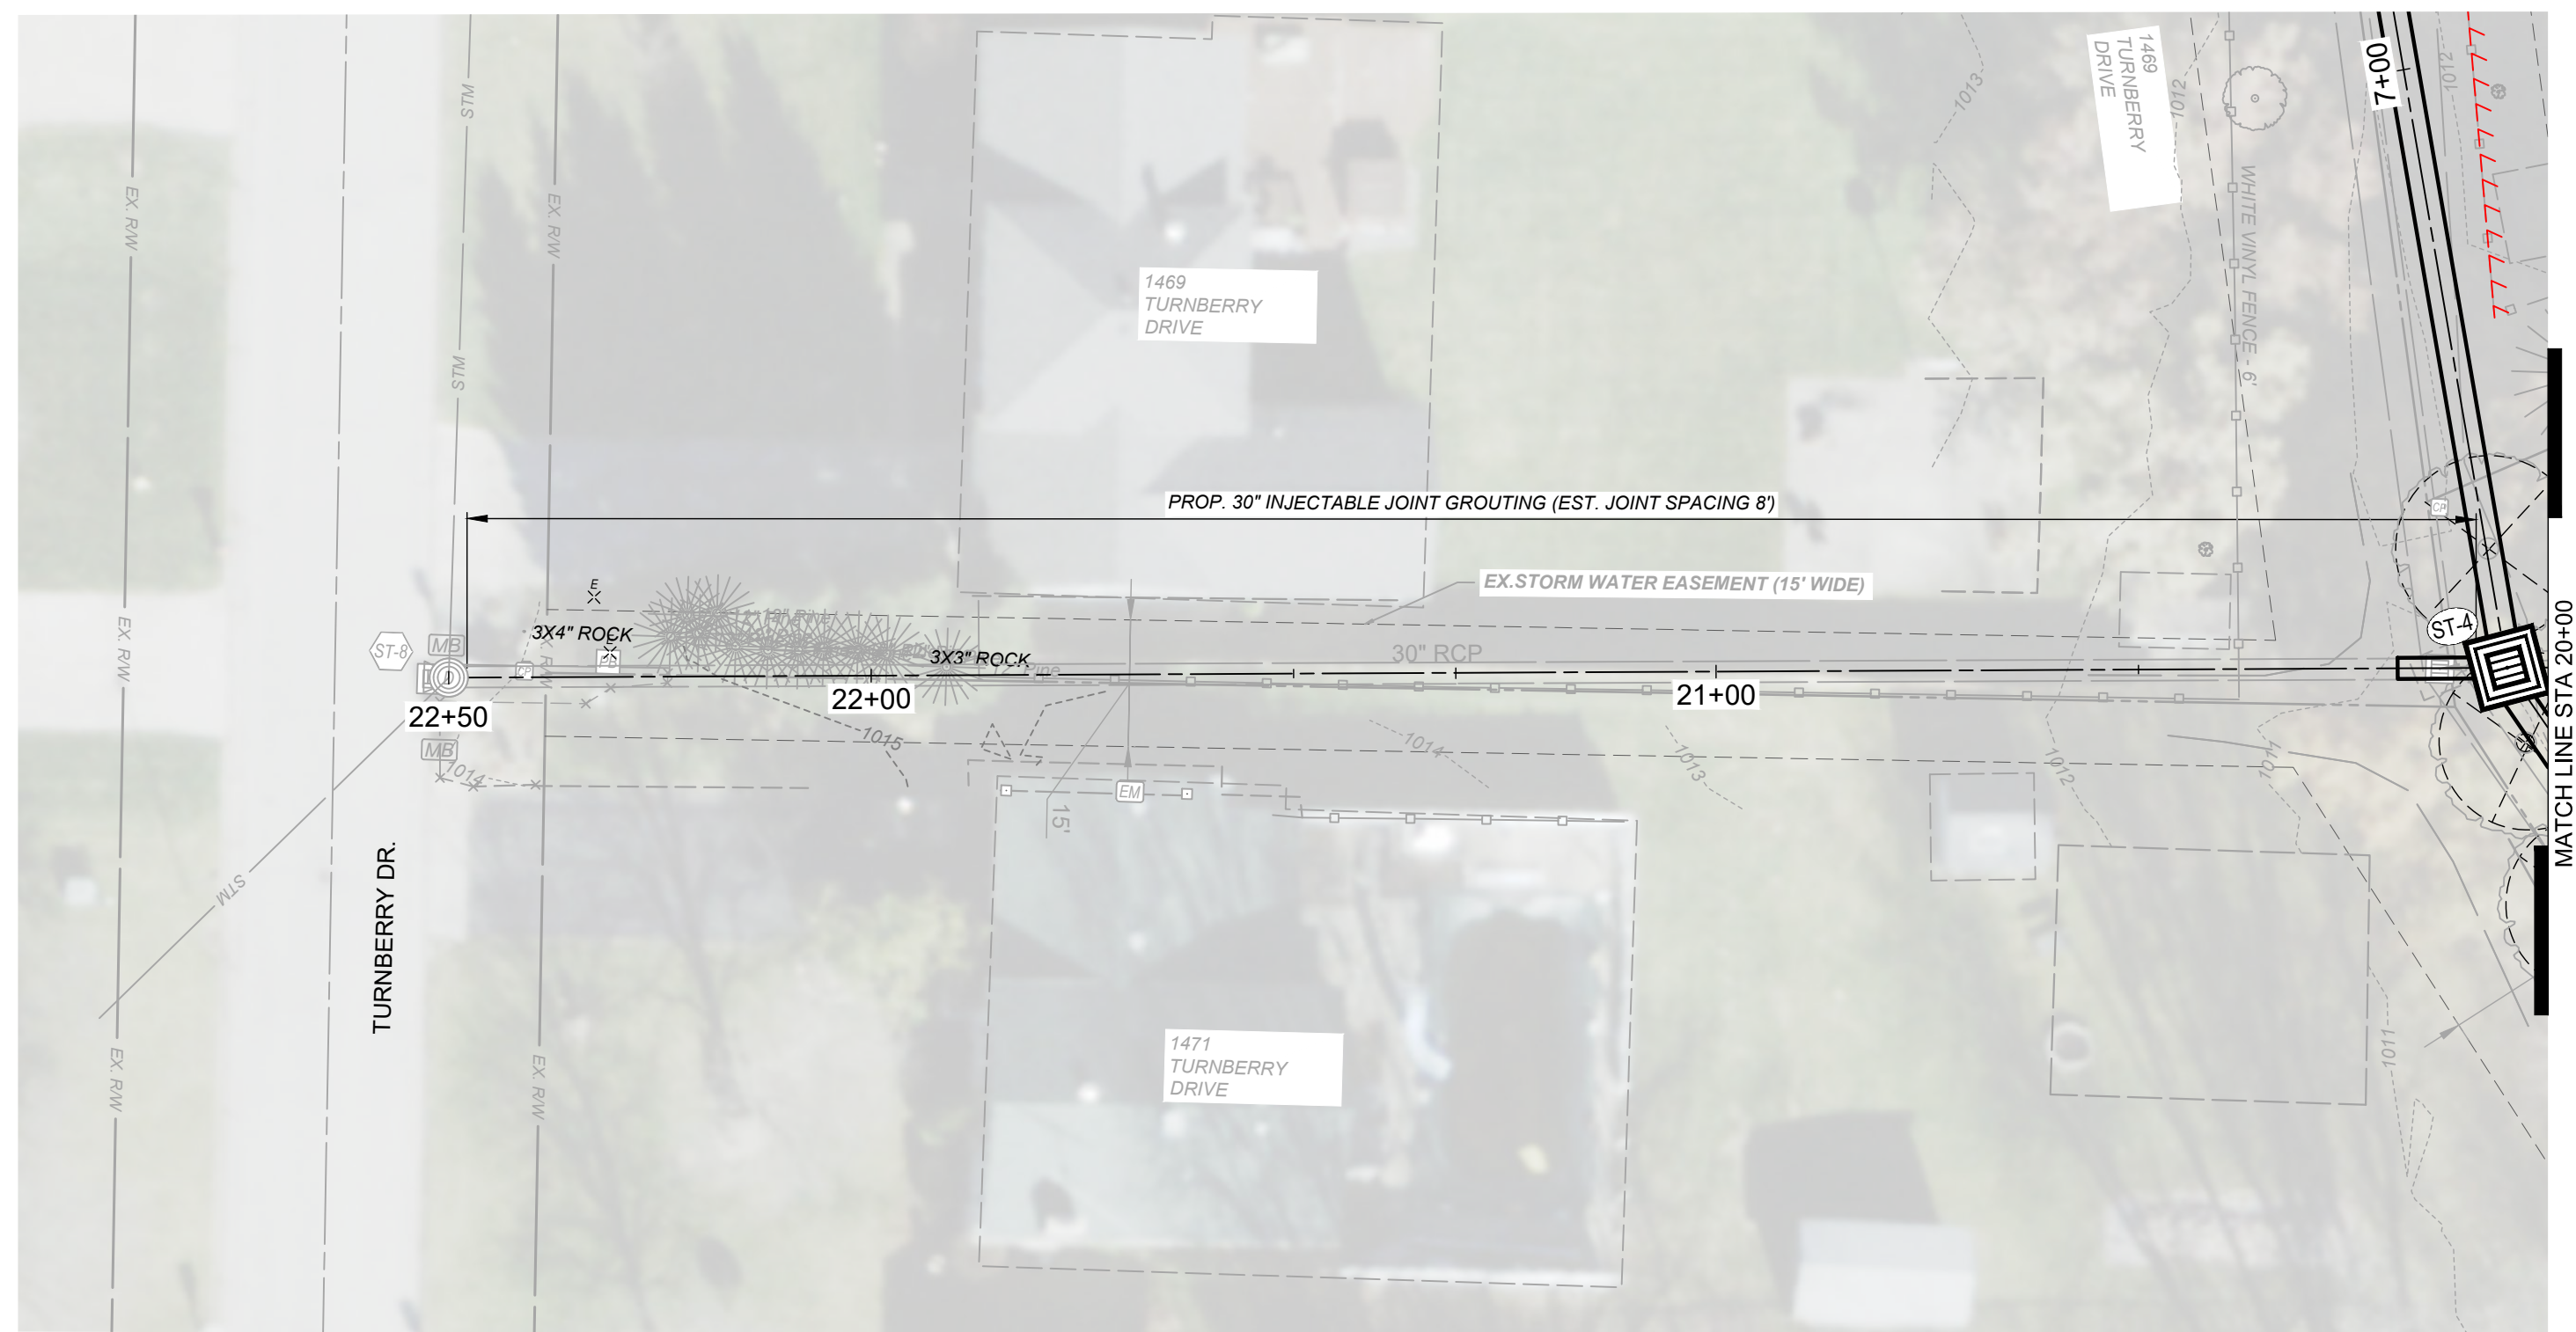

- SITE GENERAL NOTES:**

1. EXISTING CONDITIONS SHOWN HEREIN ARE PER TOPOGRAPHIC SURVEY PREPARED BY VERDANTAS LLC DATED DECEMBER, 2024.
2. EXISTING UNDERGROUND UTILITY ROUTING IS PER TOPOGRAPHIC SURVEY AND BEST AVAILABLE RECORD PLAN INFORMATION. CONTRACTOR IS RESPONSIBLE FOR CONFIRMING EXISTING UTILITY LOCATIONS AND DEPTHS IN THE FIELD PRIOR TO CONSTRUCTION. IN THE EVENT UTILITY LOCATION DIFFERS IN FIELD FROM PLAN, CONTRACTOR SHALL CONTACT THE DESIGN ENGINEER.
3. THE PROPOSED IMPROVEMENTS ARE INTENDED TO TIE-IN TO EXISTING, SURROUNDING GRADES AND MAINTAIN EXISTING ELEVATIONS, UNLESS OTHERWISE NOTED IN THE PLANS.
4. CONTRACTOR TO COORDINATE WITH HOMEOWNER(S) AND NOTIFY HOMEOWNER(S) OF TEMPORARY DISTURBANCES TO BE EXPECTED RESULTING FROM CONSTRUCTION, INCLUDING START DATES, AT LEAST 48 HOURS IN ADVANCE.
5. CONTRACTOR SHALL FIELD VERIFY THE LOCATION OF EXISTING SEWER PIPES AND PROVIDE REQUIRED MEANS AND MATERIALS TO CONNECT THE EXISTING STORM SEWER PIPES TO THE NEW STRUCTURES WHERE INDICATED.
6. FLOW CONTROL AND BYPASS PUMPING DURING THE DURATION OF THE PROJECT IS THE RESPONSIBILITY OF THE CONTRACTOR. REFER TO SEWER FLOW CONTROL SPEC IN DIVISION 33.
7. EXISTING ARMSTRONG CABLE UNDERGROUND CONDUITS AND PEDESTALS ARE SHOWN PER AVAILABLE UTILITY RECORDS. ARMSTRONG IS SCHEDULED TO RELOCATE THE PEDESTALS AND BURIED CONDUIT OUTSIDE OF THE EASEMENT TO FACILITATE THE STORM SEWER WORK. CONTRACTOR SHALL COORDINATE WITH ARMSTRONG CABLE BEFORE START OF STORM SEWER WORK TO CONFIRM CABLE HAS BEEN RELOCATED.

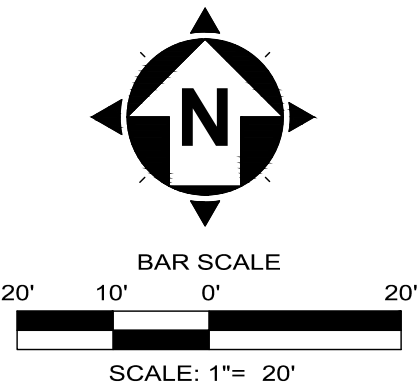

verdantas

SCALE:	NONE	NO	REVISION	DATE
DATE:	2/27/2025	1	PER ADDENDUM 01	06/22/26
		2	PER ADDENDUM 02	06/24/26
DESIGNED BY:	MMB			
DRAWN BY:	MMB			
CHECKED BY:	PAB			


**COLLEEN DRIVE STORM
IMPROVEMENTS: PART II**



MAHONING COUNTY **BOARDMAN, OHIO**

PLAN & PROFILE

STA. 22+00 TO STA. 22+50


PROJECT NO:	
242438	
DRAWING NAME	
C-11	
SHEET	OF
11	13

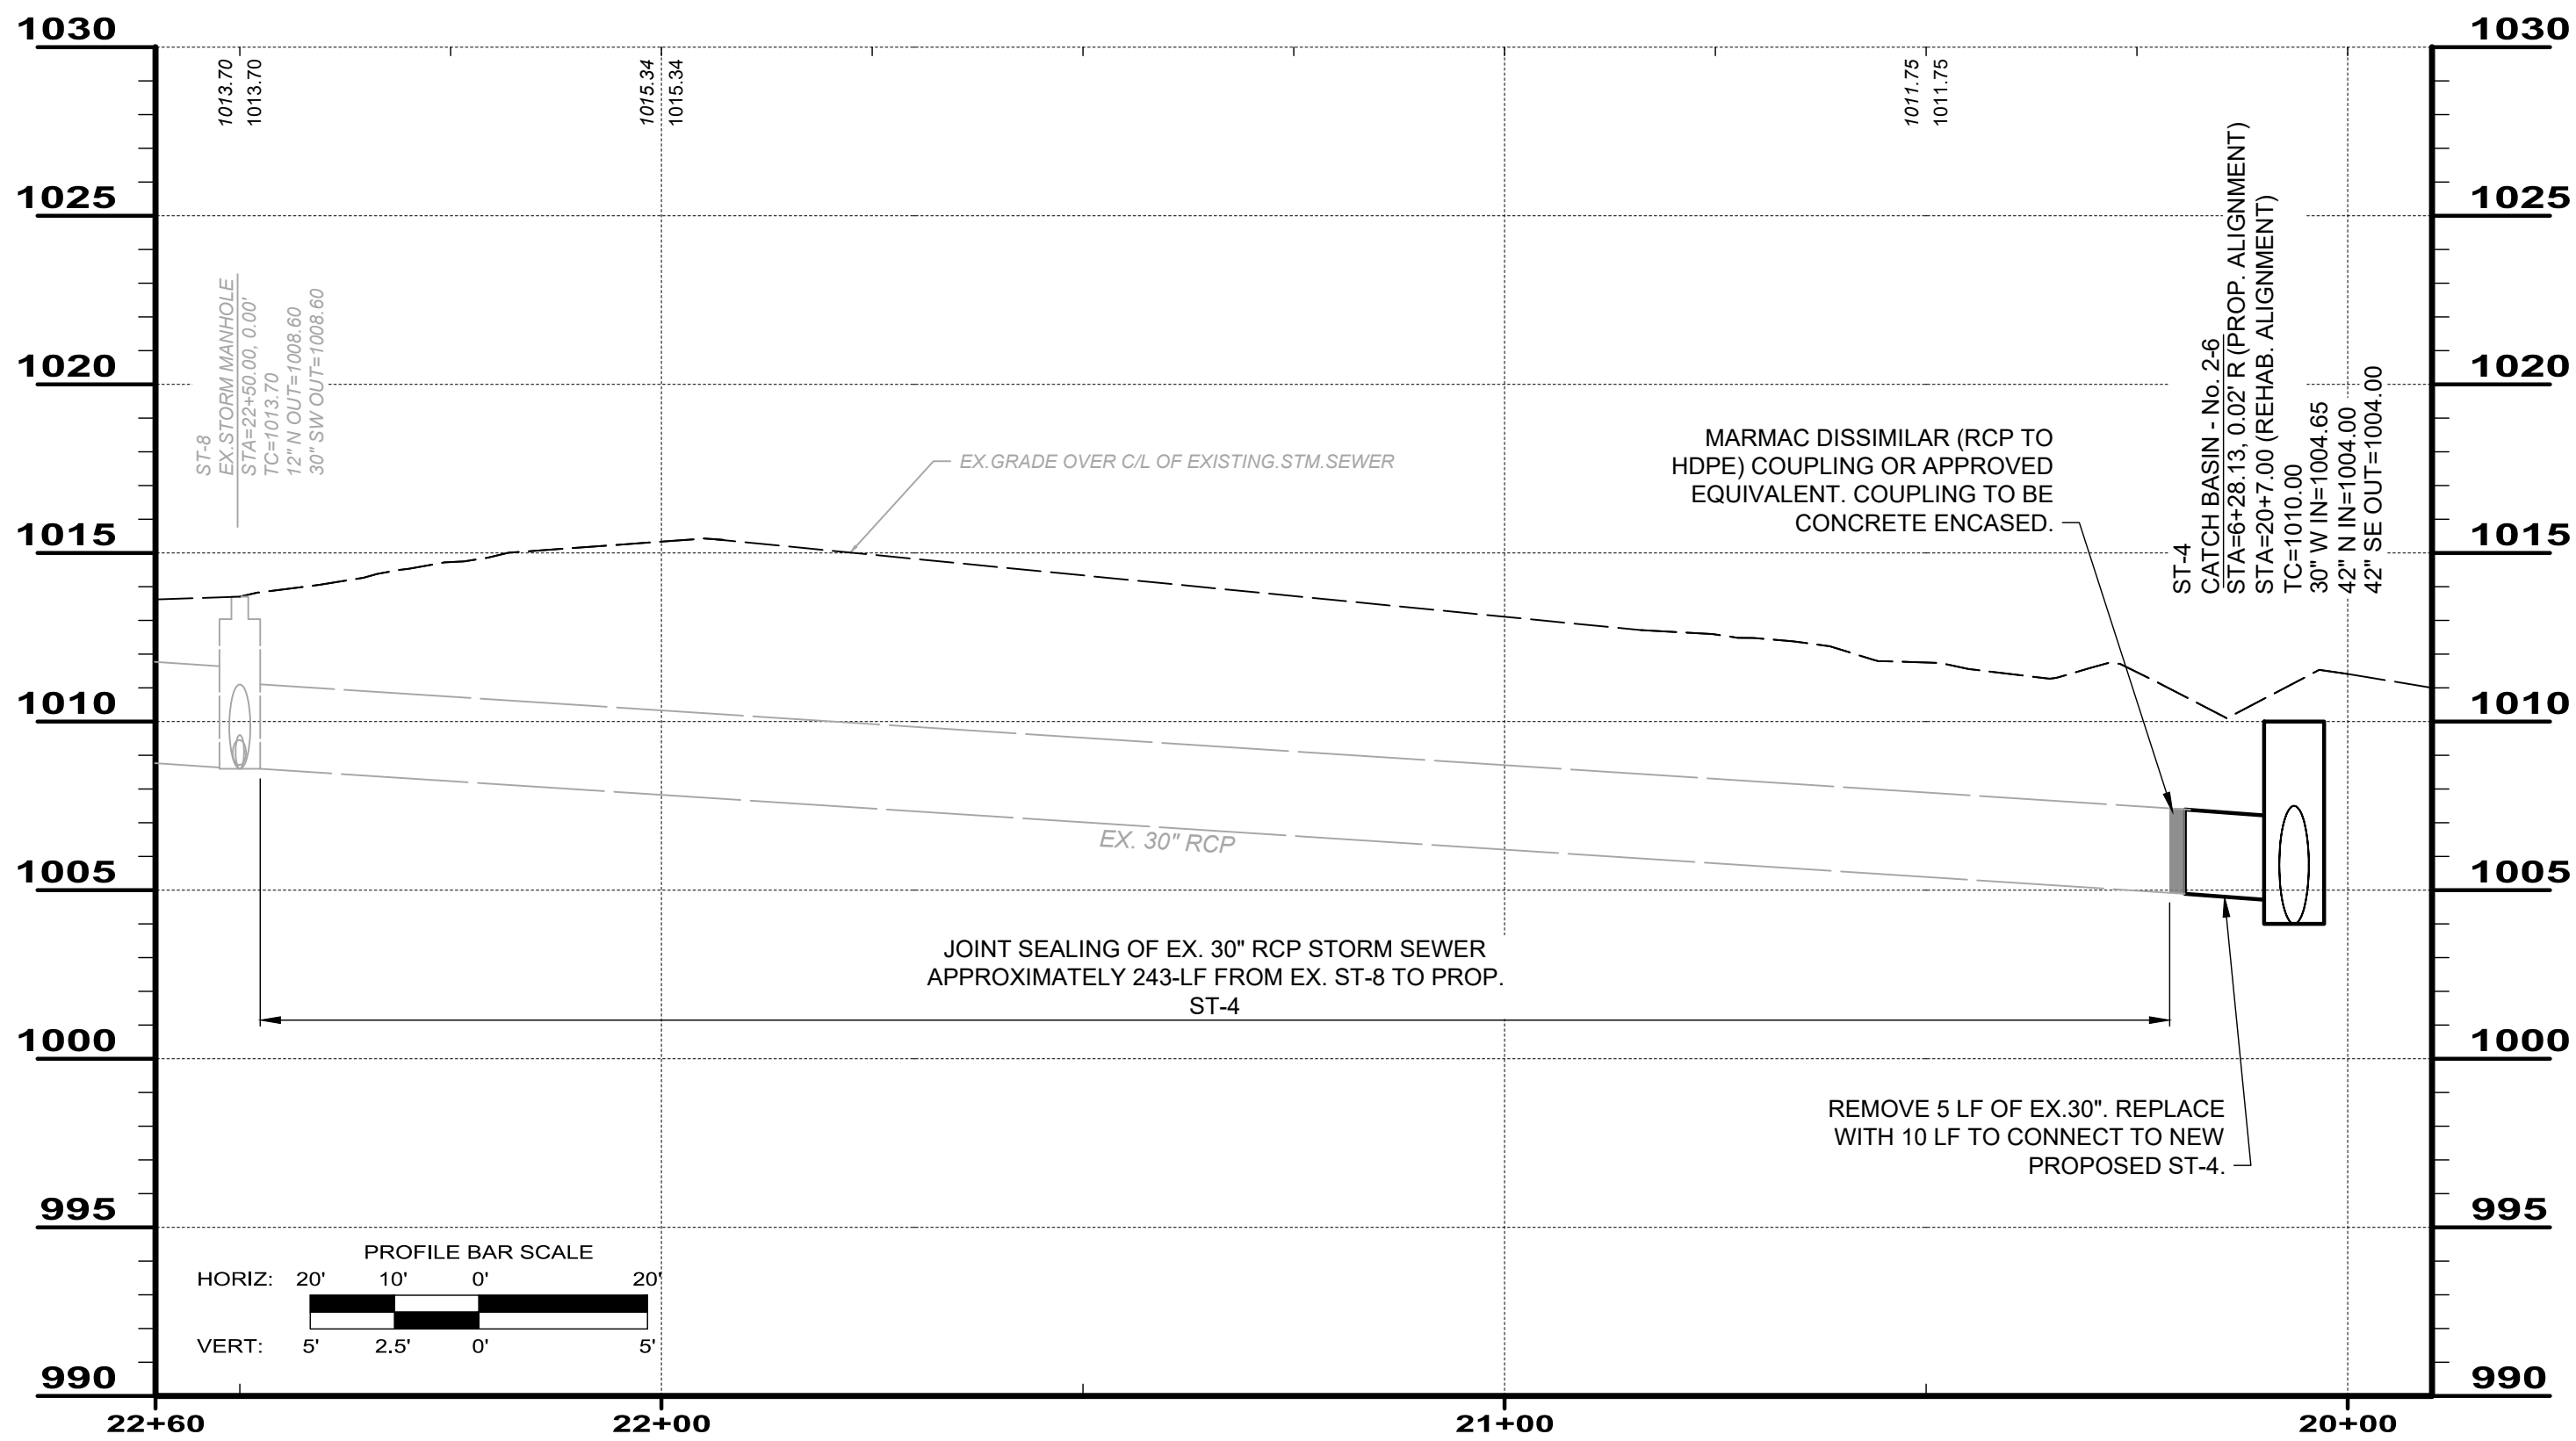

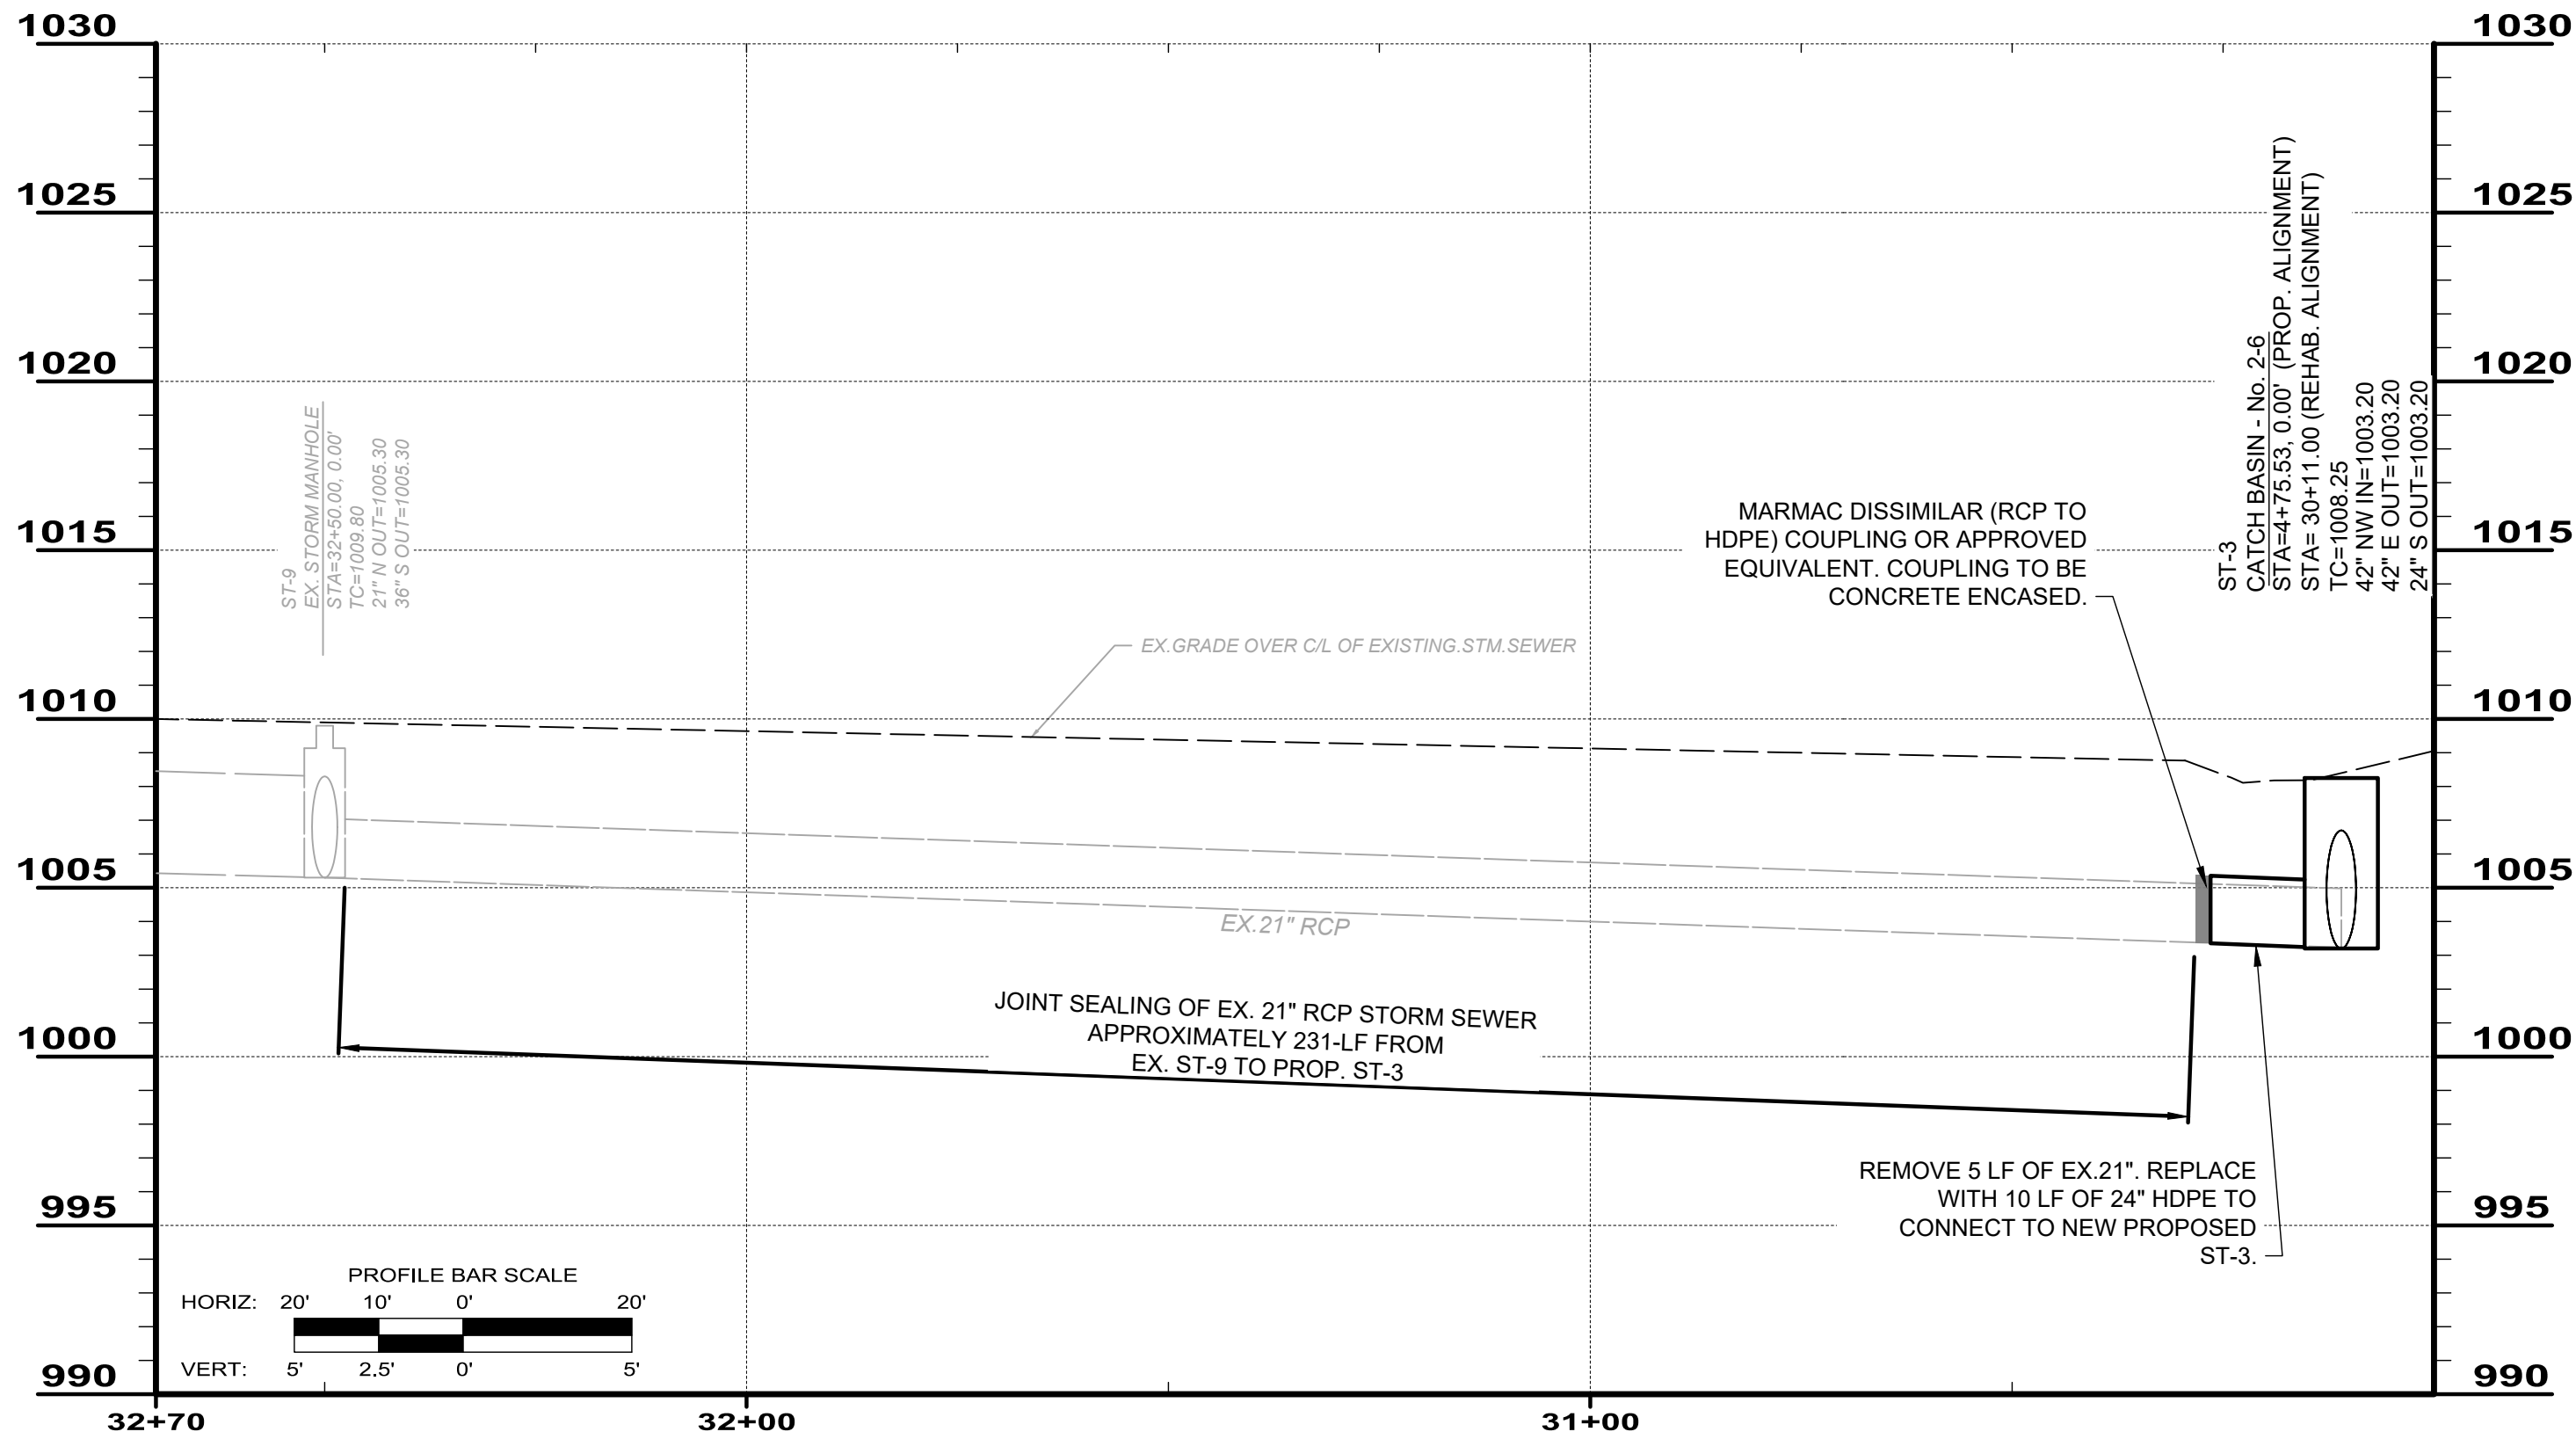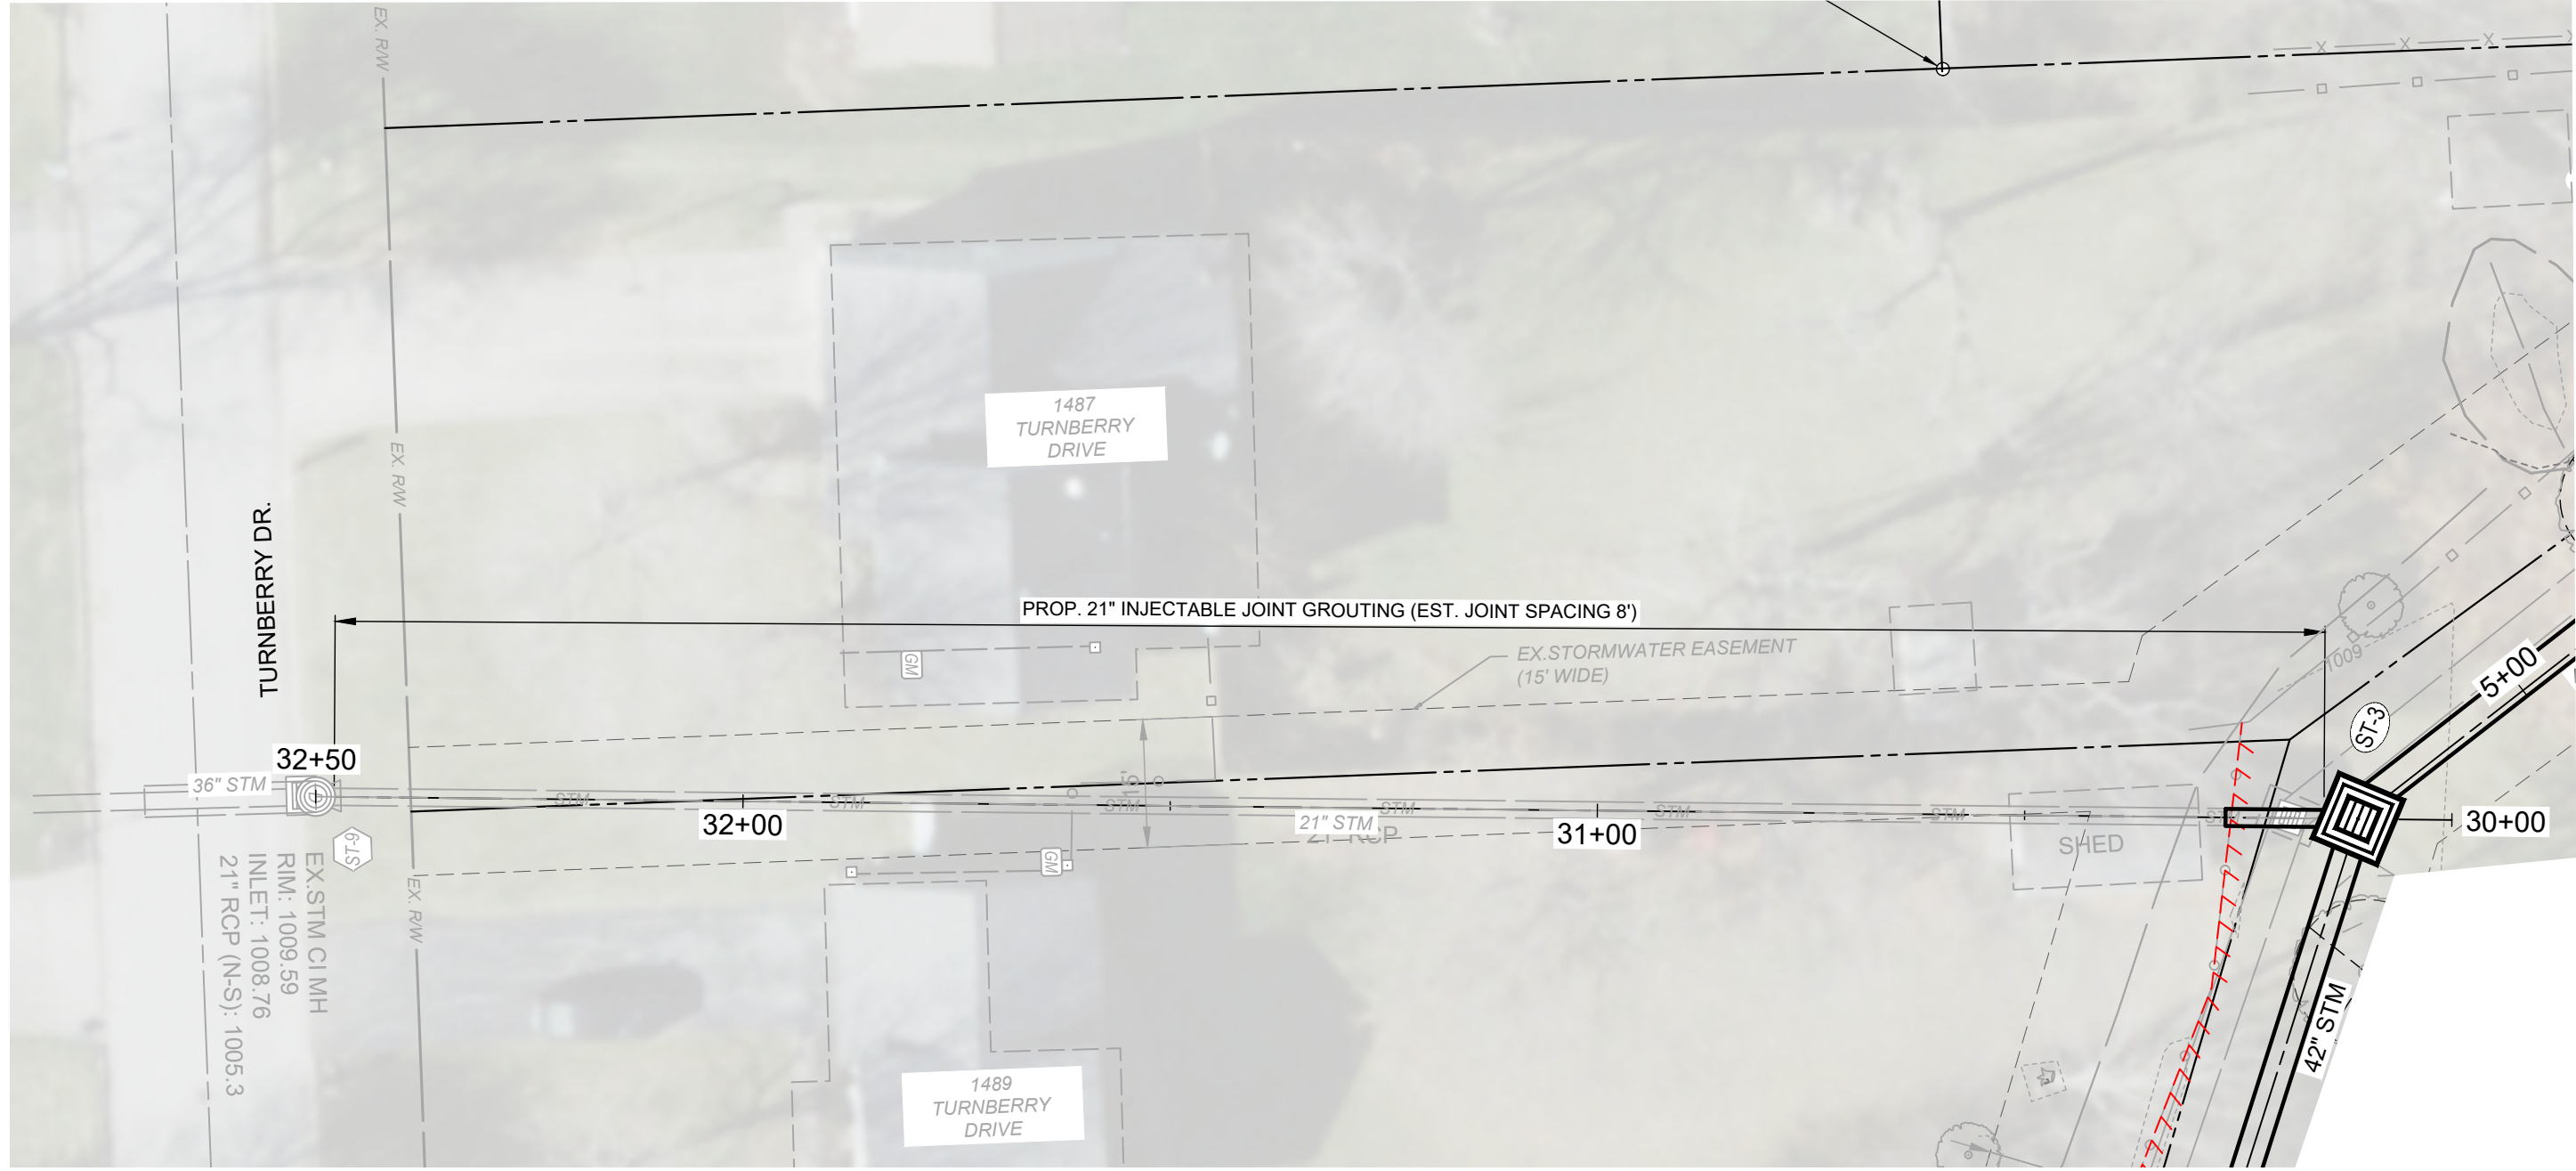

SITE GENERAL NOTES:

- EXISTING CONDITIONS SHOWN HEREIN ARE PER TOPOGRAPHIC SURVEY PREPARED BY VERDANTAS LLC DATED DECEMBER, 2024.
- EXISTING UNDERGROUND UTILITY ROUTING IS PER TOPOGRAPHIC SURVEY AND BEST AVAILABLE RECORD PLAN INFORMATION. CONTRACTOR IS RESPONSIBLE FOR CONFIRMING EXISTING UTILITY LOCATIONS AND DEPTHS IN THE FIELD PRIOR TO CONSTRUCTION. IN THE EVENT UTILITY LOCATION DIFFERS IN FIELD FROM PLAN, CONTRACTOR SHALL CONTACT THE DESIGN ENGINEER.
- THE PROPOSED IMPROVEMENTS ARE INTENDED TO TIE-IN TO EXISTING, SURROUNDING GRADES AND MAINTAIN EXISTING ELEVATIONS, UNLESS OTHERWISE NOTED IN THE PLANS.
- CONTRACTOR TO COORDINATE WITH HOMEOWNER(S) AND NOTIFY HOMEOWNER(S) OF TEMPORARY DISTURBANCES TO BE EXPECTED RESULTING FROM CONSTRUCTION, INCLUDING START DATES, AT LEAST 48 HOURS IN ADVANCE.
- CONTRACTOR SHALL FIELD VERIFY THE LOCATION OF EXISTING SEWER PIPES AND PROVIDE REQUIRED MEANS AND MATERIALS TO CONNECT THE EXISTING STORM SEWER PIPES TO THE NEW STRUCTURES WHERE INDICATED.
- FLOW CONTROL AND BYPASS PUMPING DURING THE DURATION OF THE PROJECT IS THE RESPONSIBILITY OF THE CONTRACTOR. REFER TO SEWER FLOW CONTROL SPEC IN DIVISION 33.
- EXISTING ARMSTRONG CABLE UNDERGROUND CONDUITS AND PEDESTALS ARE SHOWN PER AVAILABLE UTILITY RECORDS. ARMSTRONG IS SCHEDULED TO RELOCATE THE PEDESTALS AND BURIED CONDUIT OUTSIDE OF THE EASEMENT TO FACILITATE THE STORM SEWER WORK. CONTRACTOR SHALL COORDINATE WITH ARMSTRONG CABLE BEFORE START OF STORM SEWER WORK TO CONFIRM CABLE HAS BEEN RELOCATED.

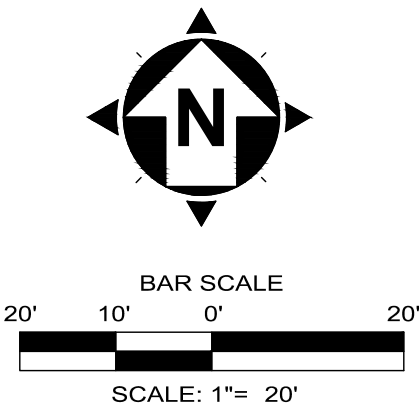

verdantas

NO	REVISION	DATE
1	PER ADDENDUM 01	06/22/26
2	PER ADDENDUM 02	06/24/26

SCALE:	NONE
DATE:	2/27/2025
DESIGNED BY:	MIMB
DRAWN BY:	MIMB
CHECKED BY:	PAB

COLLEEN DRIVE STORM IMPROVEMENTS: PART II
MAHONING COUNTY BOARDMAN, OHIO

PLAN & PROFILE
STA. 30+00 TO STA. 32+50

PROJECT NO:	
242438	
DRAWING NAME	
C-12	
SHEET	OF
12	13